

OUTSIDE

1919

VOL. 4

H-N

Assessors Map Book
of
SACRAMENTO COUNTY
(Outside City Limits)
Accompanying Assessors Roll
for
1919

I hereby certify that the following is a true and correct Map of the lands embraced within the boundaries of **SACRAMENTO COUNTY (Outside City Limits)** exclusive of Sacramento City as drawn and compiled by me from official data and surveys of record.

Sacramento March 1st 191

.....
County Surveyor.

Mapped.

Black Ink-1919 Ownership
Red Ink-1920 Ownership

HAGGIN PARK

located in
Sec's 47 & 52 Rancho Del Paso
Scale: 1"=400'

Center S.D.

San Juan.

Center S.D.
~~San Juan S.D.~~
Carmichael.

Blanks to Sacramento Suburban Fruit Lands Co. ✓✓




Black Ink-1919 Ownership
Red Ink-1920 Ownership

LOCATED IN
S.W. $\frac{1}{4}$ SEC. 3 T. 7 N R 5 E

Florin S. D.

Blanks assessed to Cornelius, Catherine, & Matilda Harkins ✓✓

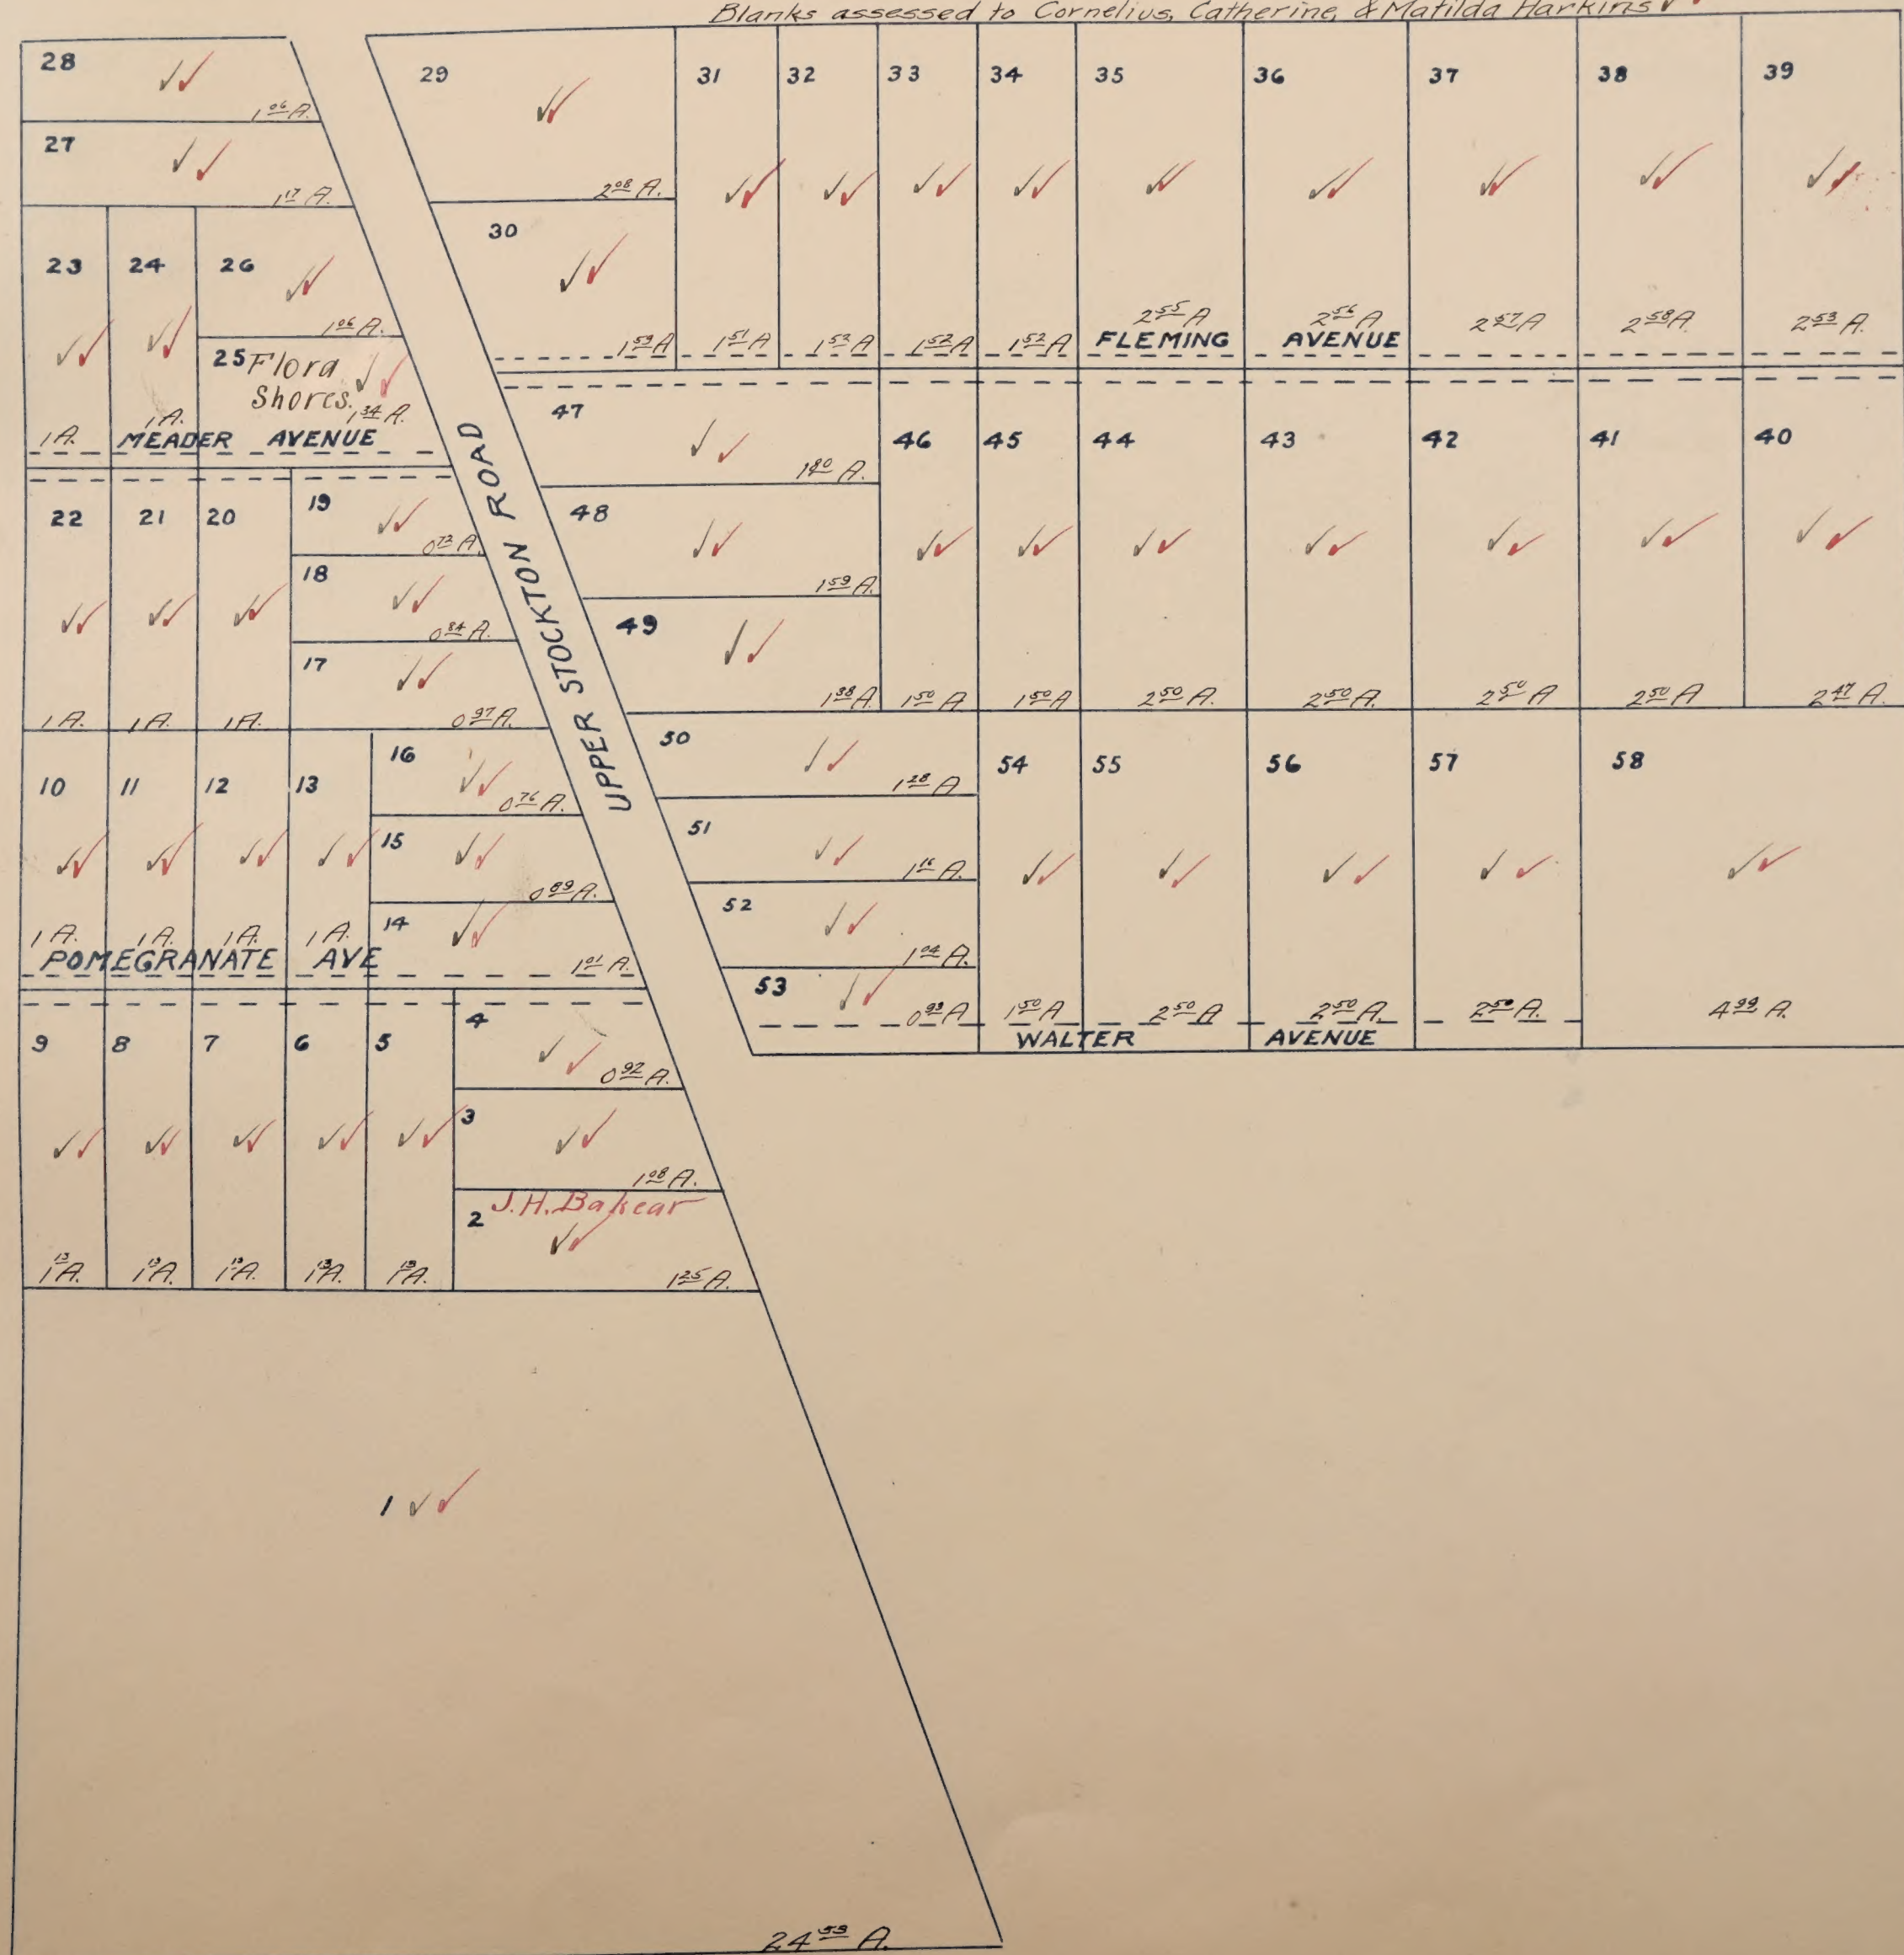


Mapped.

Black Ink-1919 Ownership
Red Ink-1920 Ownership

HERALD
LOCATED IN
Sections 7 & 8, T.5N.R.7E.
Scale: 100 ft = 1 inch.

Alabama, S.D.

Blanks to Herald Realty Co. ✓

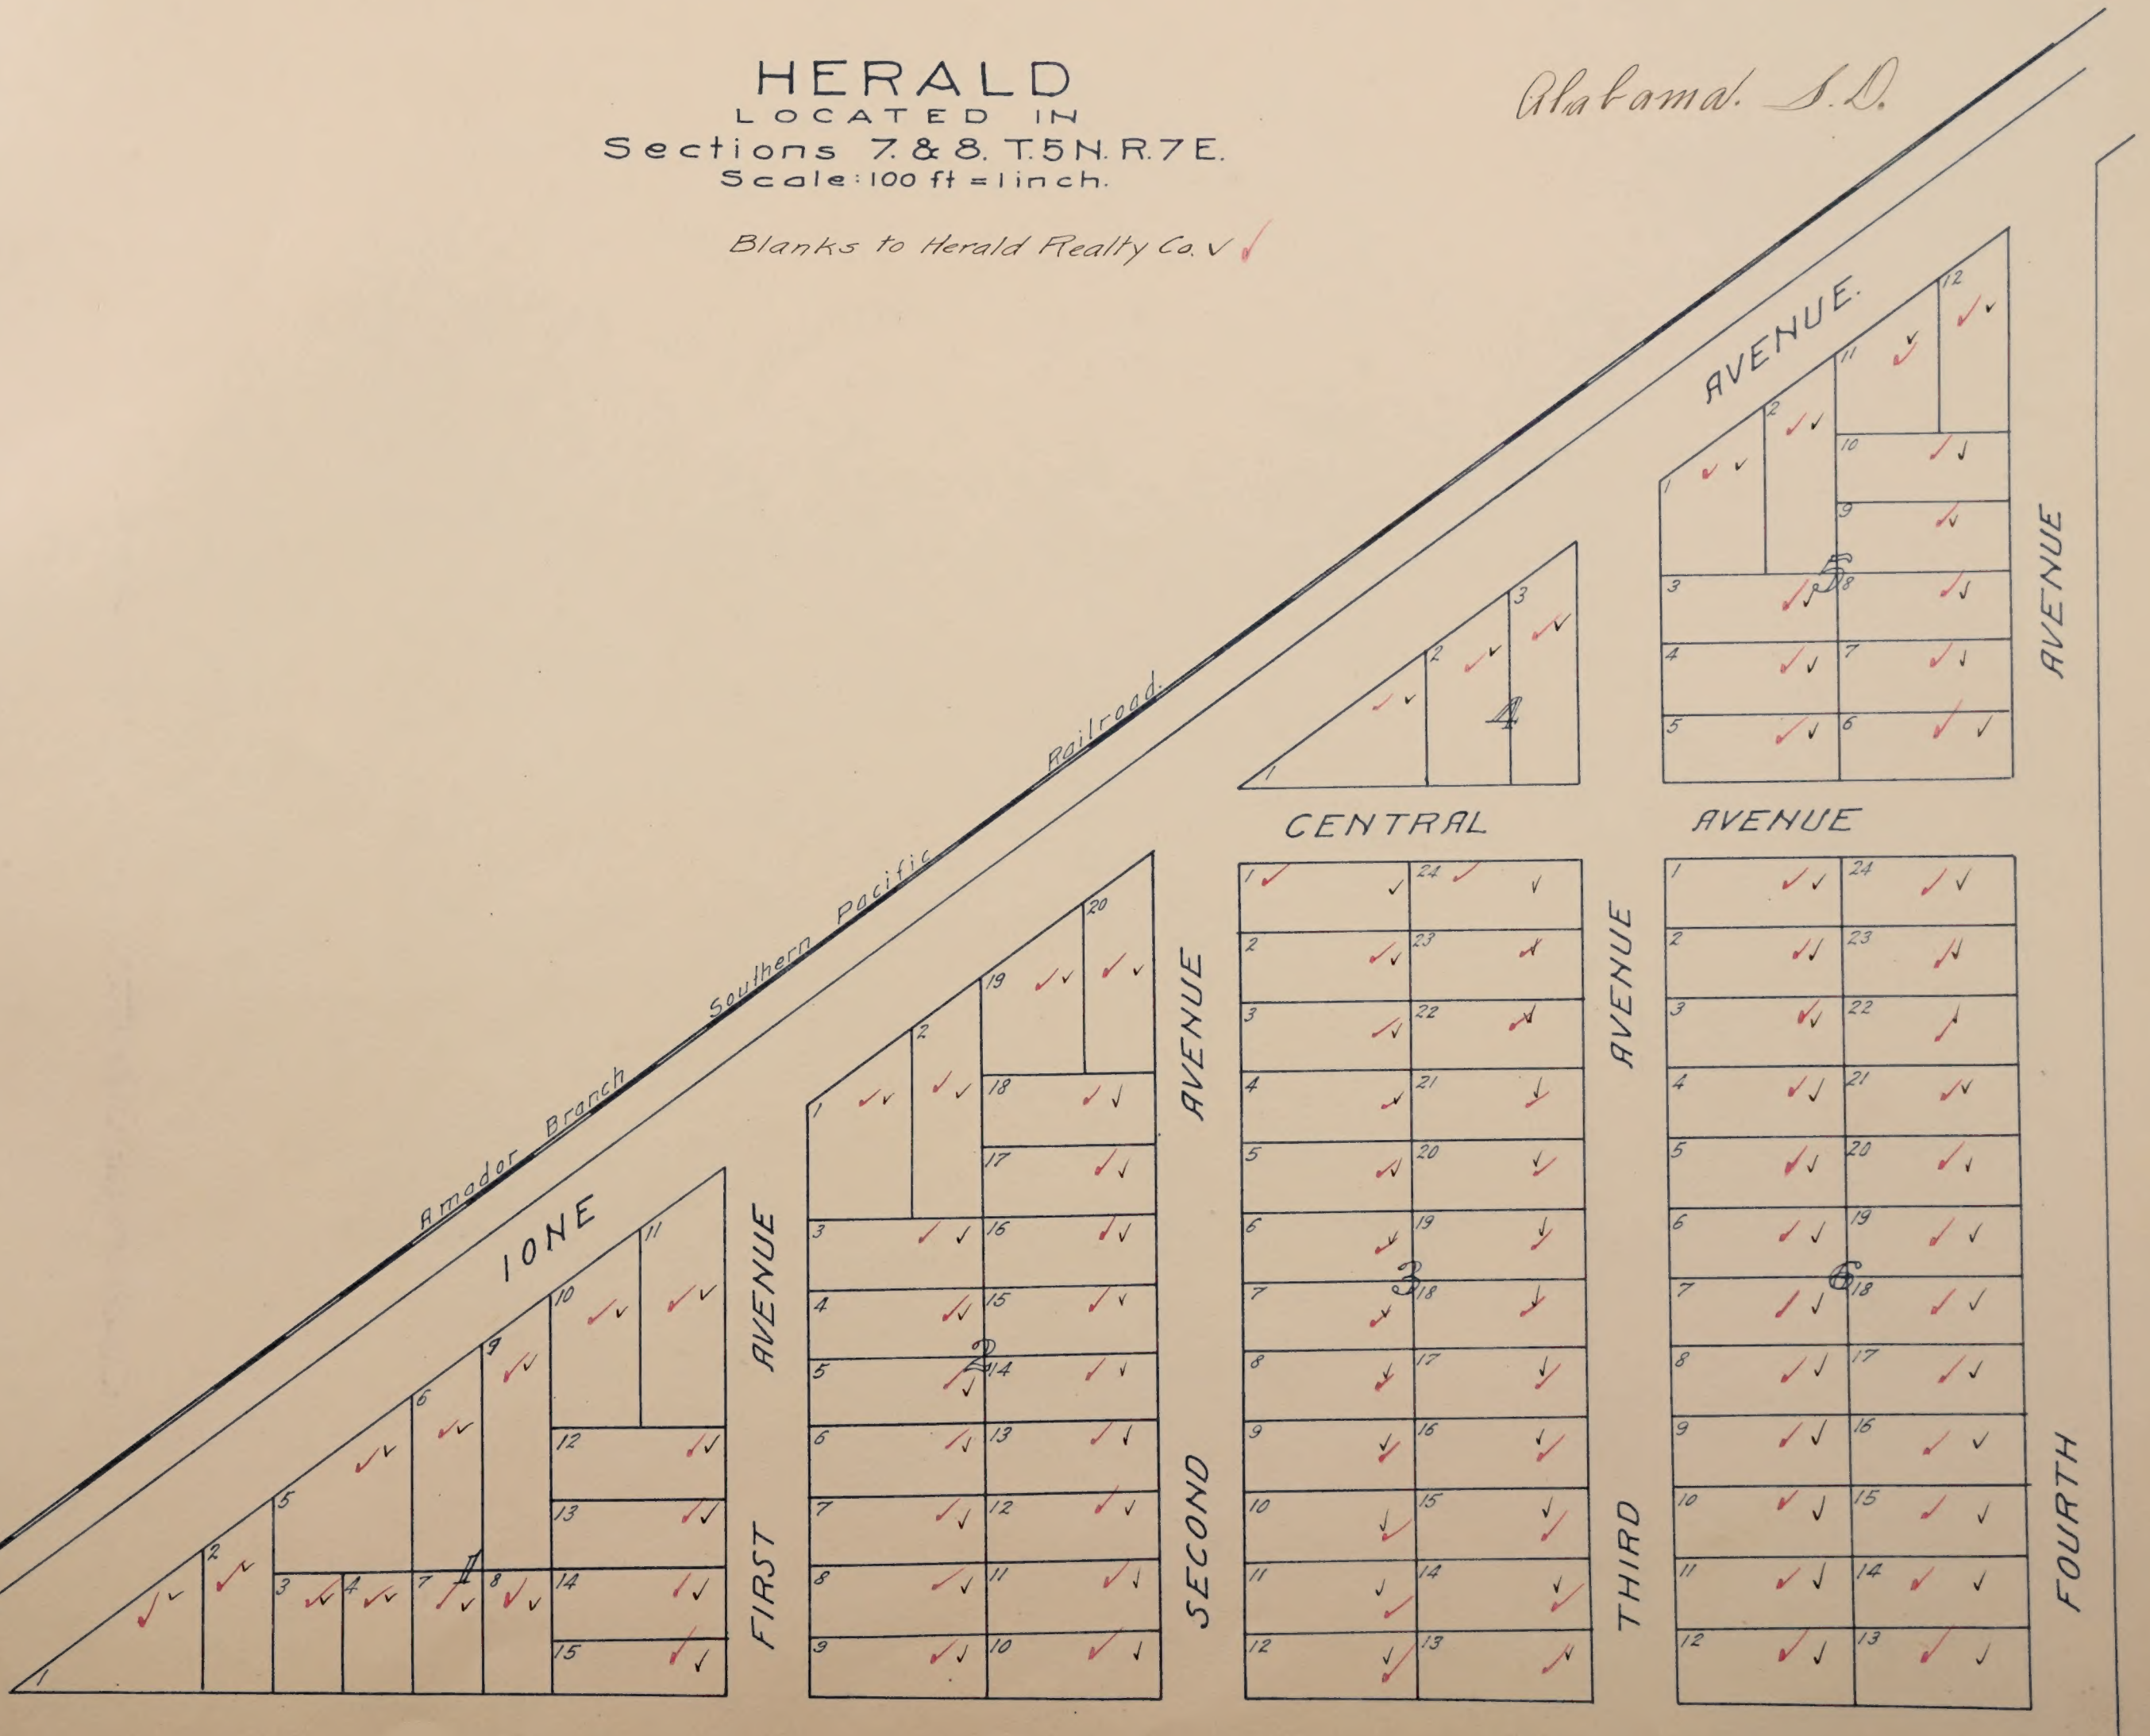

Mapped

Black Ink-1919 Ownership
Red Ink-1920 Ownership

HERALD

LOCATED IN








Sections 7 & 8, T.5 N. R.7 E.

Scale: 100 ft = 1 inch.

Blanks to Herald Realty Co. ✓

Franklin Warren & Co.
16 Building & Quigley

Alabama S.D.

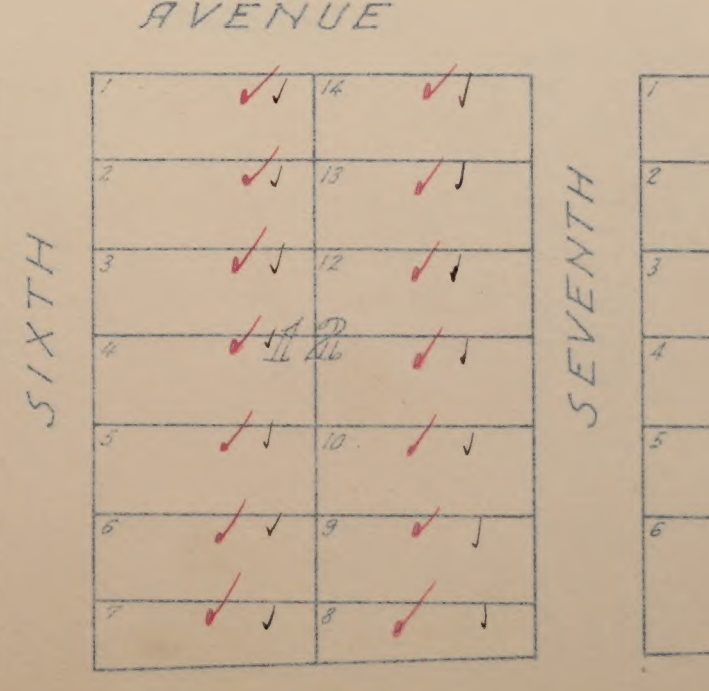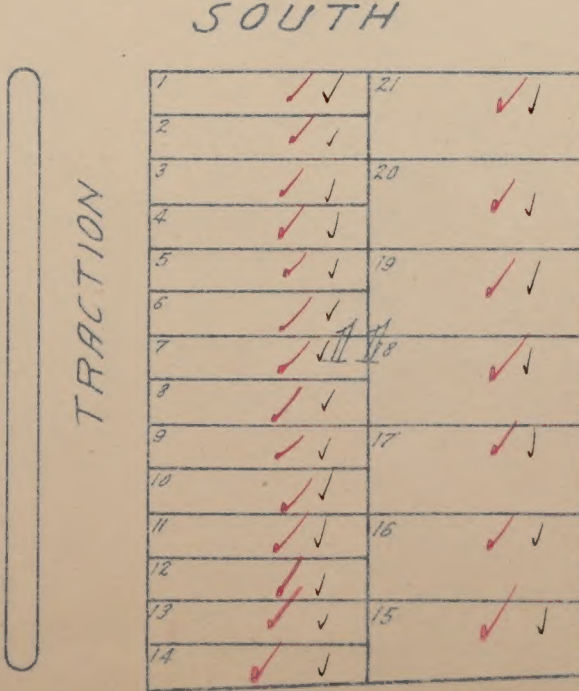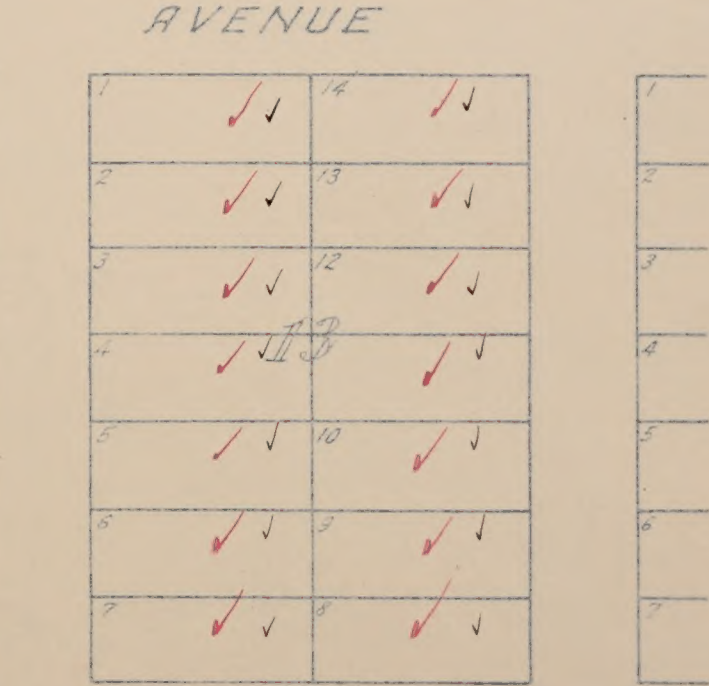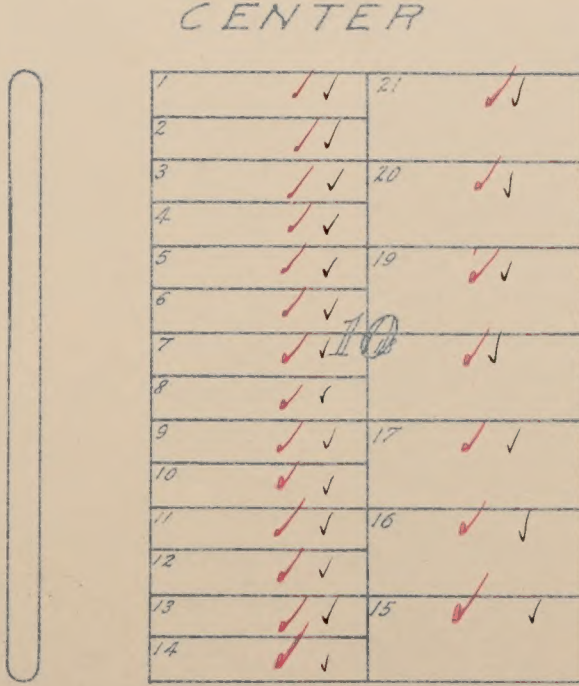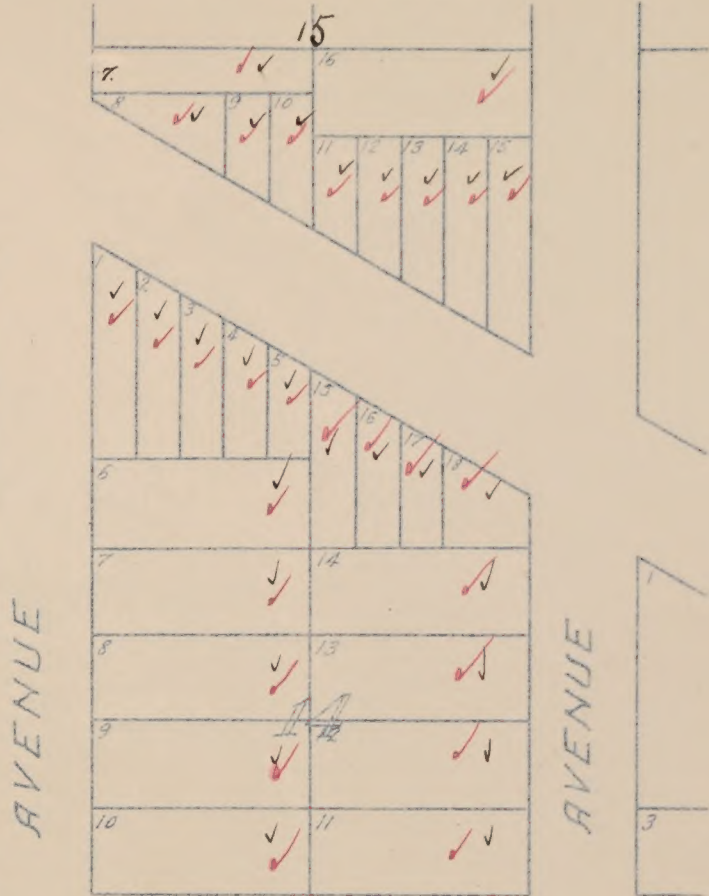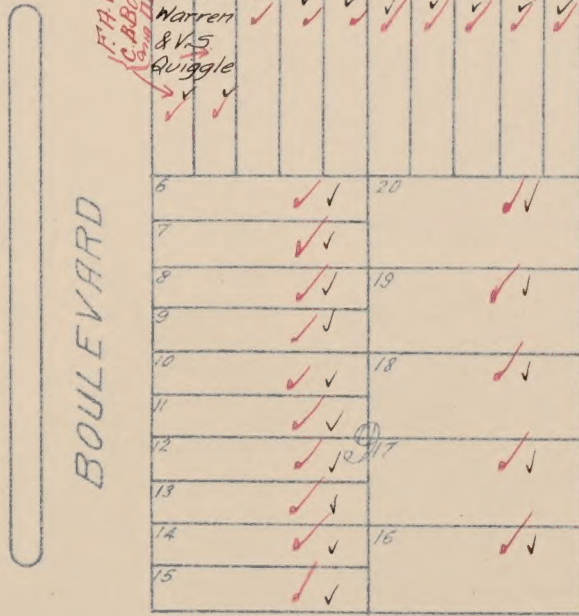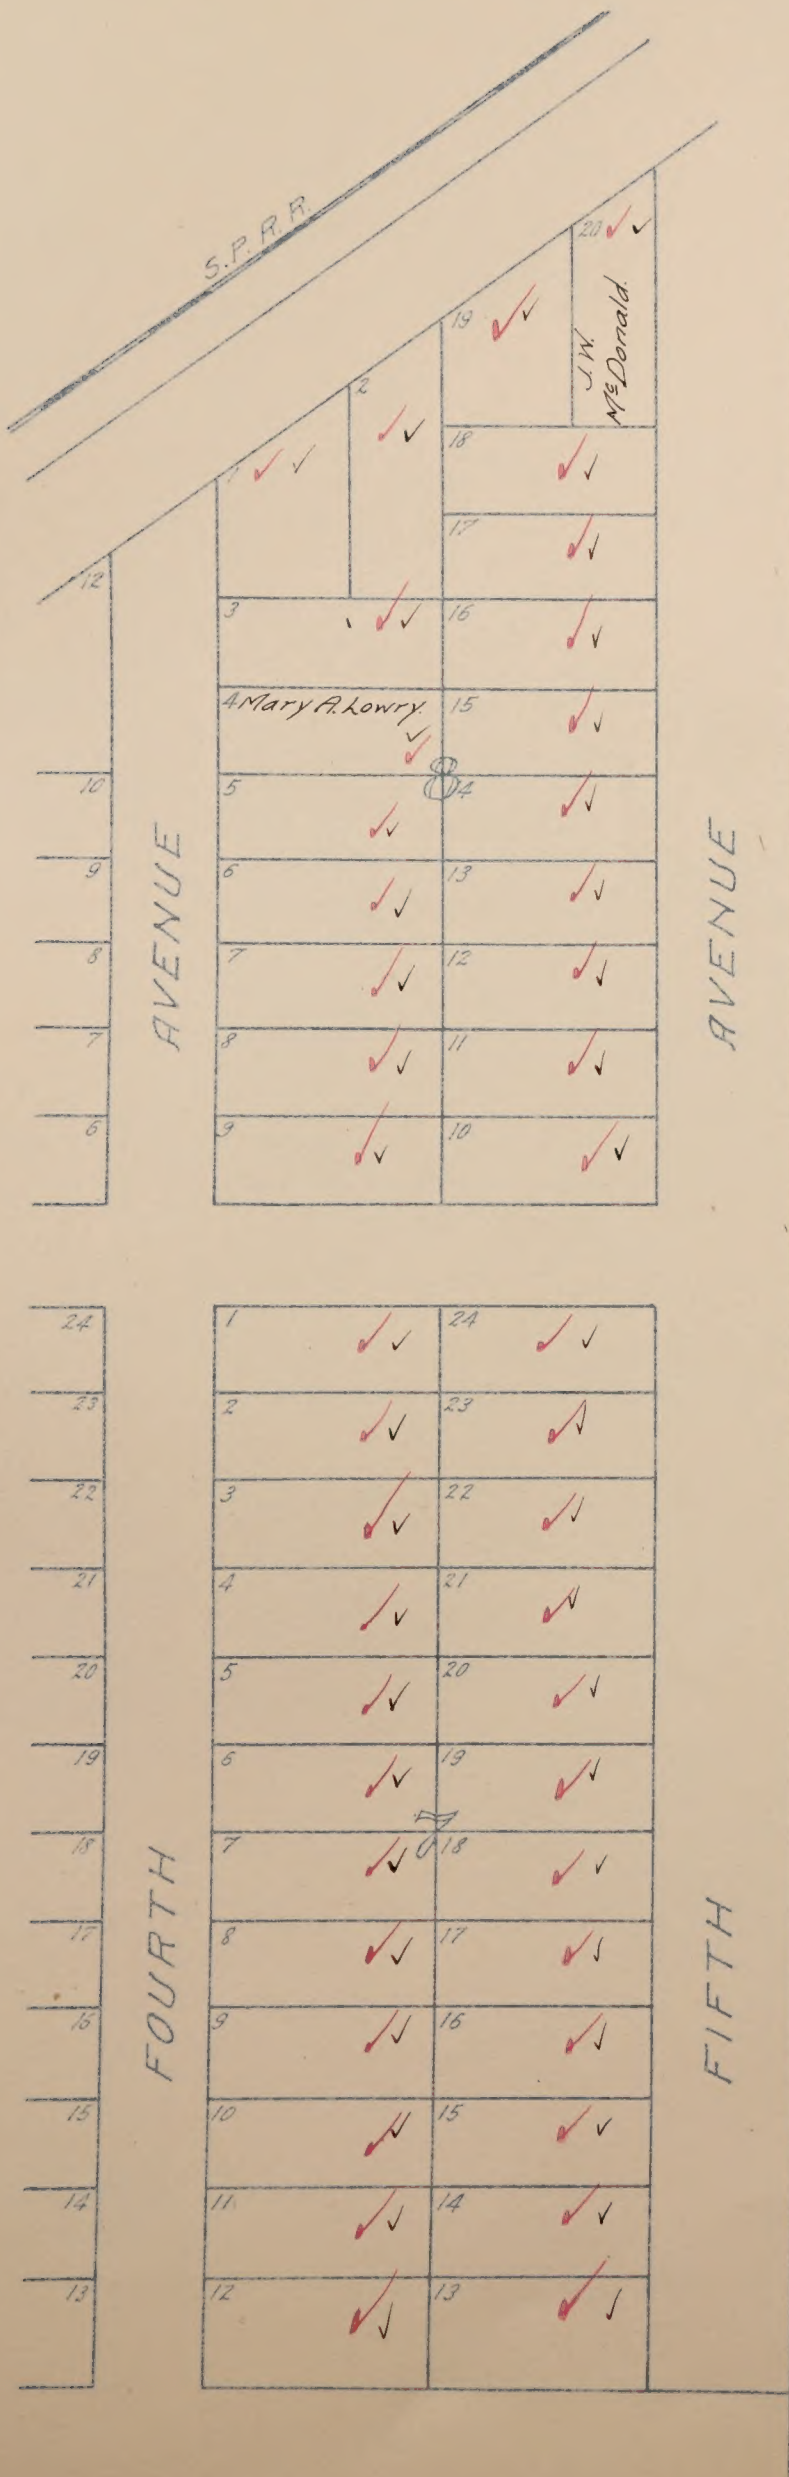

Central California Traction Company

BOULEVARD

TRACTION

AVENUE

AVENUE

CENTER

AVENUE

SOUTH

AVENUE

COLONY

AVENUE

FOURTH

FIFTH


SIXTH

SEVENTH

Alabama, S.D.

Blanks to Herald Realty Co. ✓✓
Amador Branch Southern Pacific Railroad

1 ✓✓	2 ✓✓	27 ✓✓
		26
		25
3 ✓✓	4 ✓✓	24

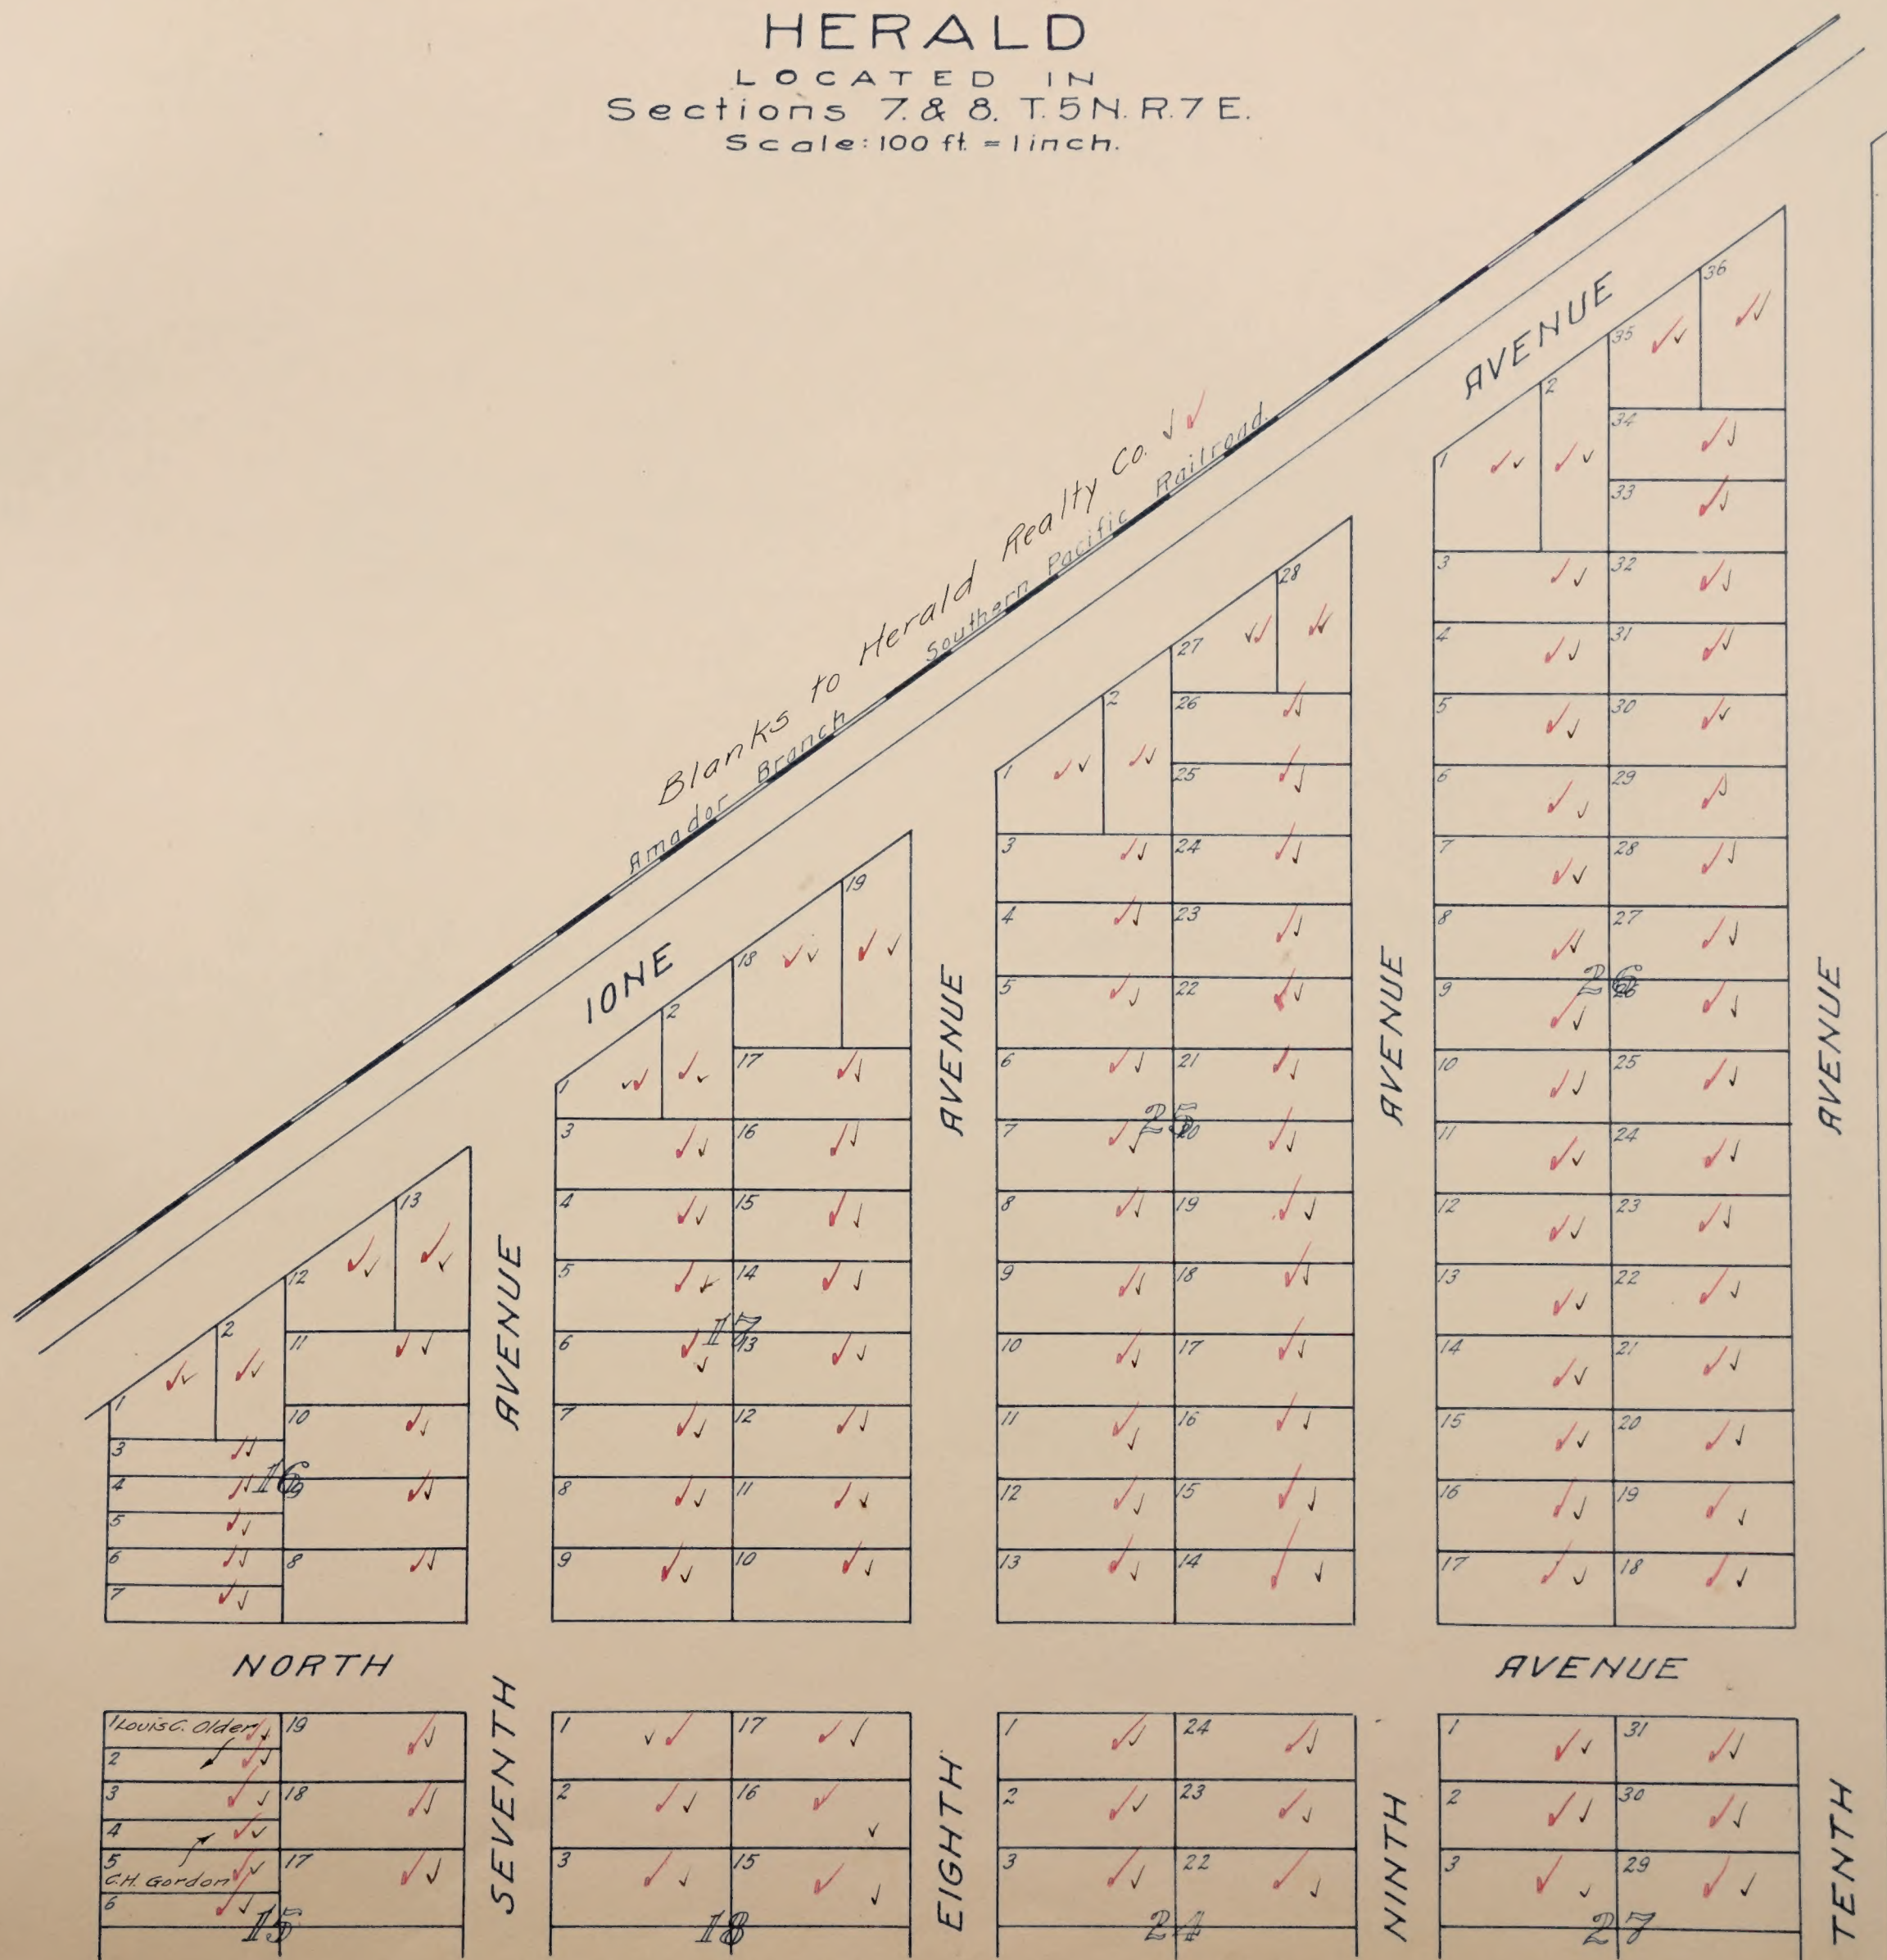

Blanks to Herald Realty Co. ✓✓

Black Ink-1919 Ownership
Red Ink-1920 Ownership

HERALD

SECTION
Sections 7 & 8, T. 10 N. R. 7 E.
Scale: 100 ft = 1 inch.

Alabama, S. L.



Mapped.

Black Ink-1919 Ownership
Red Ink-1920 Ownership

HEWITT SUBDIVISION NO.1

located in
Section 22 T.7N.R.5E.

Scale: 1"=400ft.

Sackson SD.

Blanks assessed to Henry Hewitt. ✓✓

15 P. A. Hogaboom ✓✓ 19 ⁵⁶⁷ A.	11 Carl Rodin ✓✓ 10 A. Leo Dietrich ✓✓ 10 ¹⁵⁰ A. 10 ¹⁸⁷ A. 10 ¹⁸⁷ A.	7 Peter Hansen ✓✓ 7 ⁶⁴⁰ A.	4 ✓✓ 19 ⁵¹⁷ A.
14 ✓✓ 20 ⁶⁶³ A.	10 ✓✓ 10 ¹⁸⁷ A.	✓✓ 12 ⁹²³ A.	3 ✓✓ 19 ⁶³⁵ A.
13 ✓✓ 10 ¹⁹ A.	9 ✓✓ 20 A.	6 Roy Springer ✓✓ 5 A. Albert E. & Agnes M. Bousfield ✓✓ 5 A. Adolph Feldt ✓✓ 5 A.	2 E. S. Miller ✓✓ 19 ⁶²³ A.
12 ✓✓ 20 ¹¹⁰ A.	8 ✓✓ 20 A.	5 ✓✓ 5 A.	1 ✓✓ 19 ⁶²⁴ A.
COUNTY			ROAD

Mapped.

Black Ink-1919 Ownership
Red Ink-1920 Ownership

HEWITT SUBD'N. NO. 2

located in
Sec's 25 & 26 T.7 N. R.5 E.
Scale: 1"=400 ft.

Elk Grove S.D.

Blanks assessed to Henry Hewitt. ✓

Hewitt Sub No. 3,

15 Meta A. Ipsen C.H; AA; MAY ✓✓ ✓✓	14 Meta A. Ipsen C.H; AA; MAY ✓✓ ✓✓
12 9 ⁹⁷⁸ (A.) ✓✓	13 10 ⁰⁴⁰ (A.) ✓✓
10 A.	10 ⁴⁴³ A.
8 ✓✓ 10 ⁸⁵⁸ A.	Carrie Ambjor ✓✓ 10 A.

20

✓✓

Not in Sub No. 2.

65⁴¹³ A.

19 ✓✓ 20 ⁸⁷⁰ A.	18 ✓✓ 20 ⁵⁴² A.
6 Harold Avery ✓✓ 20 A.	5 ✓✓ 19 ⁷⁴⁸ A.

4 ✓✓ 19 ⁷⁰⁵ A.	3 ✓✓ 19 ⁸³⁶ A.
2 Sullivan & Smith ✓✓ 10 A.	9 ⁹⁰² A.

Memo.

Black Ink - 1919 Ownership
Red Ink - 1920 Ownership

HEWITT SUBD'N NO. 3

located in
Sec. 26 T. 7 N. R. 5 E.
Scale: 1" = 300 ft.




Black Ink-1919 Ownership
Red Ink-1920 Ownership

HEWITT SUB'DN NO 4

located in
Sec 15 T.7N. R.5E.
Scale: 1"=500'

Jackson S.D.

Blanks assessed to Henry Hewitt. ✓

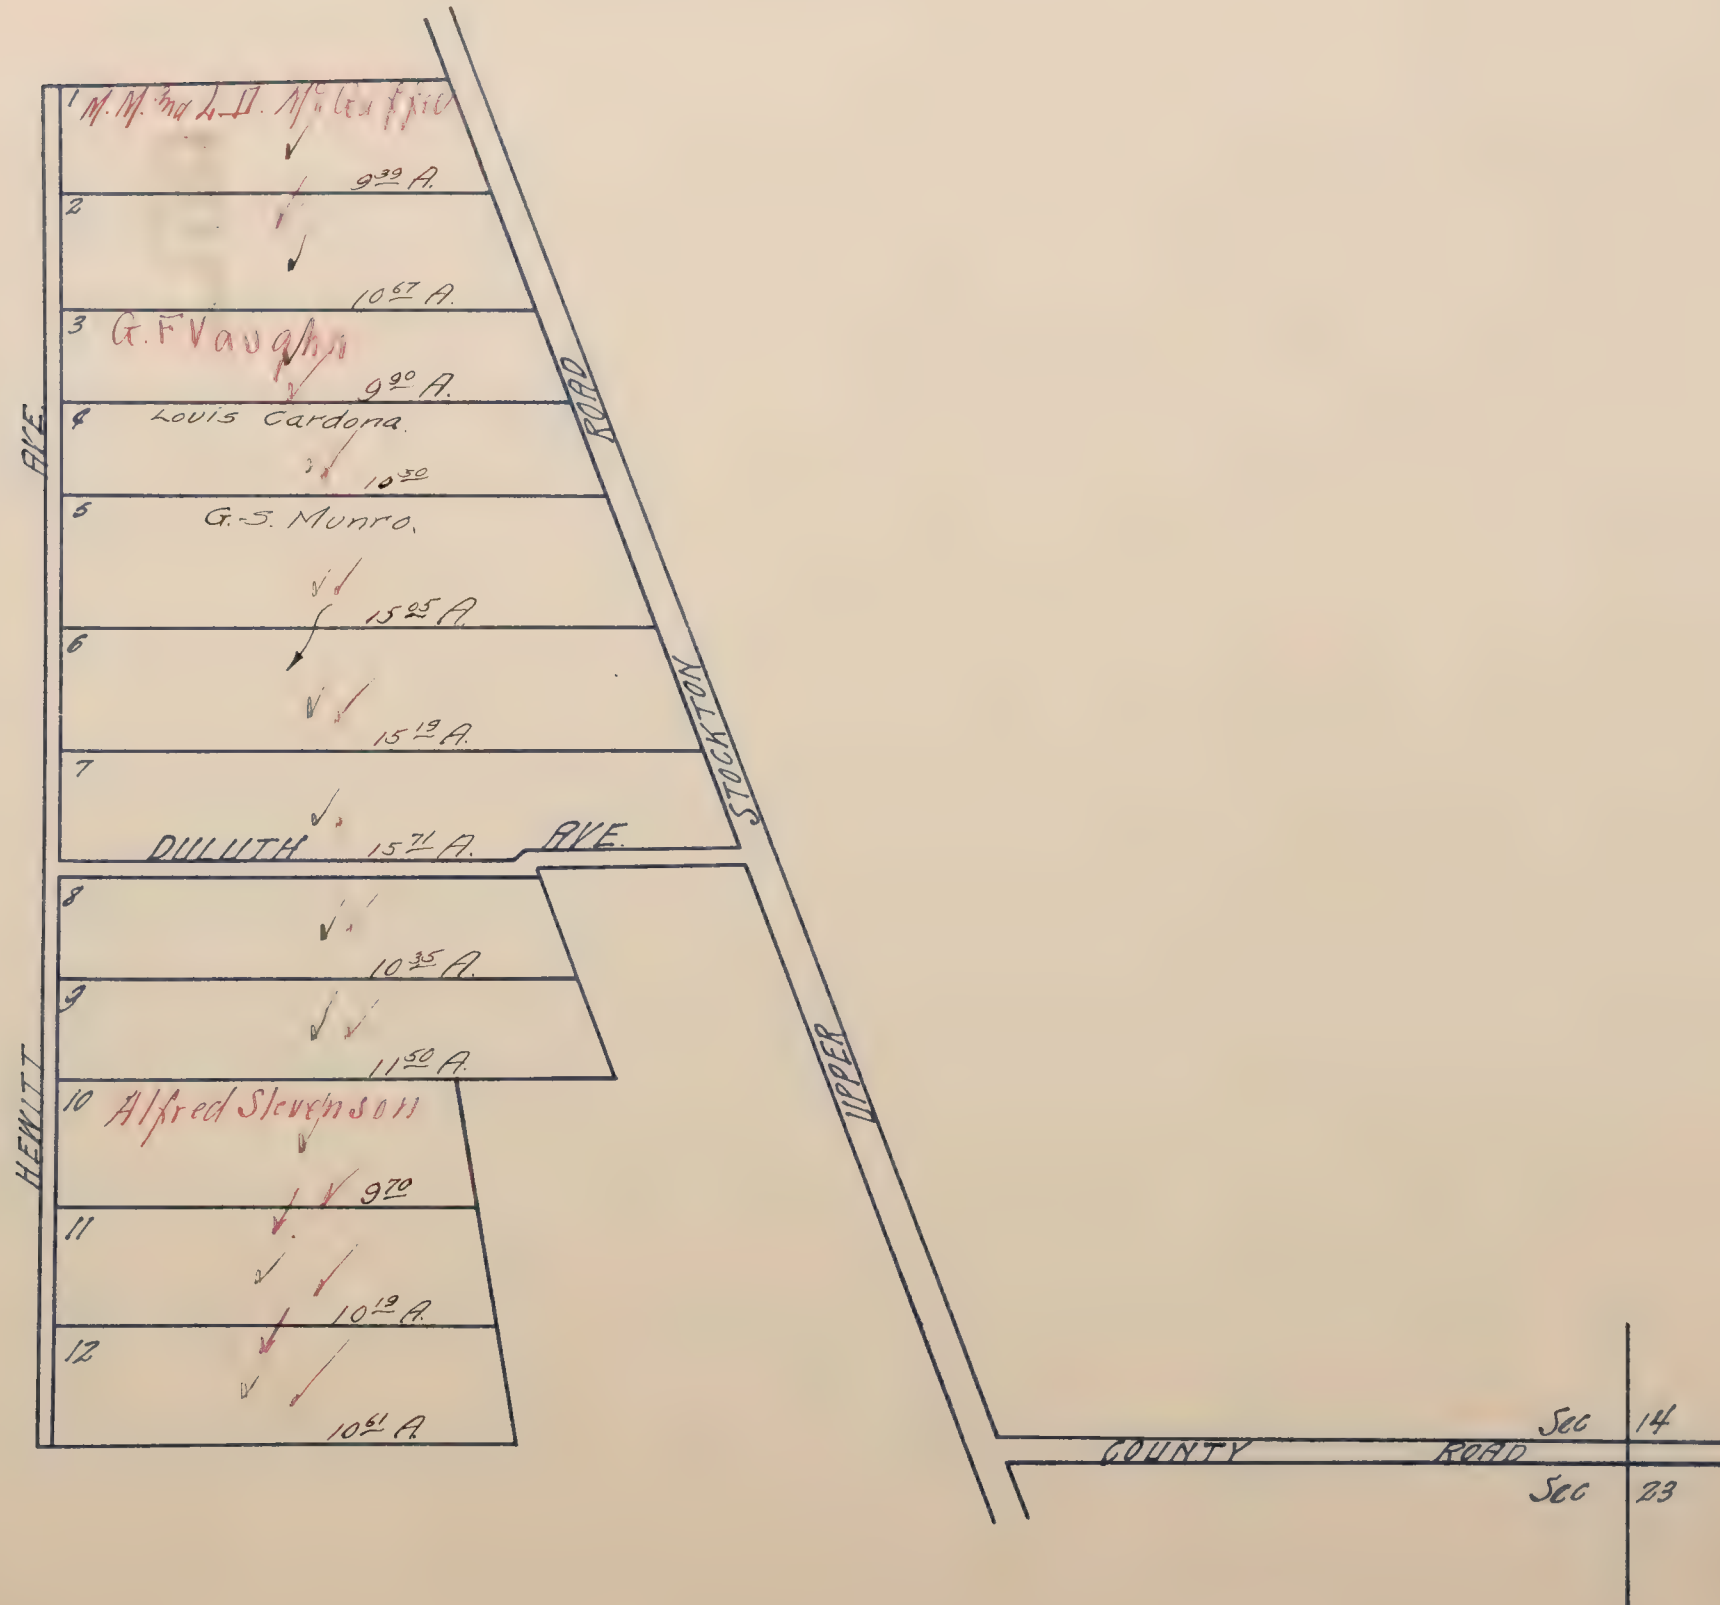

Mapped.

Black Ink-1919 Ownership

Red Ink-1920 Ownership

HILLSIDE TERRACE

LOCATED IN

N.E. 1/4 of Section 20, T.8 N.R.5E.

Scale: 1" = 60'

Fruit Ridge I.R.

Blanks assessed to Meehan & Combellach ✓



AMENDED PLAT OF
Black Ink-1910 Ownership
Red Ink-1920 Ownership
HOOD
LOCATED IN
S.L.S. No 439, 235 & 236 Secs 14 & 15 T6NR4E
Scale: 125' = 1" Richland S.D.
SHEET 1

all blanks below assessed to Hood Improvement Co.



HOOD

S.L.S. No. 429,235,236 in Sec. 14 & 15 T 6 N R 4 E.

Scale $1'' = 125'$

SHEET 2.

Red 1920 Ownership

Richland S.D.



MAIN LINE SACRAMENTO SOUTHERN R.R.

Mapped.

HUNGER TRACT NO.1

located in
S 1/2 Sec. 20 T. 8 N. R. 5 E.

Black Ink - 1910 Ownership
Red Ink - 1920 Ownership

Scale: 1" =

Blanks assessed to F. J. Hunger.

Fruit Ridge
S.D.

SACRAMENTO HEIGHTS

FRUIT RIDGE PARK.

PERRY AVENUE						
1 W.E. Yeaw ✓✓	2 ✓✓	3 J.H. and A. H. ✓✓	4 E.B. & G.A. Bartle ✓✓	5 ✓✓	6 ✓✓	7 ✓✓
ROAD						
14 ✓✓	13 ✓✓	12 Raimondo Bertolani ✓✓	11 C.V. & S. Wilson ✓✓	10 Marvella A. Smith ✓✓	9 ✓✓	8 ✓✓
COUNTY						
15 ✓✓	16 ✓✓	17 ✓✓	18 ✓✓	19 ✓✓	20 ✓✓	21 ✓✓
COLOMA AVENUE						
28 ✓✓	27 ✓✓	26 ✓✓	25 ✓✓	24 ✓✓	23 ✓✓	22 ✓✓

HUNGER

INWOOD


Mapped.

Black Ink-1919 Ownership
Red Ink-1920 Ownership

INWOOD COLONY

LOCATED IN
Sec. 26, T. 10 N., R. 7 E.
Scale: 150' = 1"

Granite S.D.

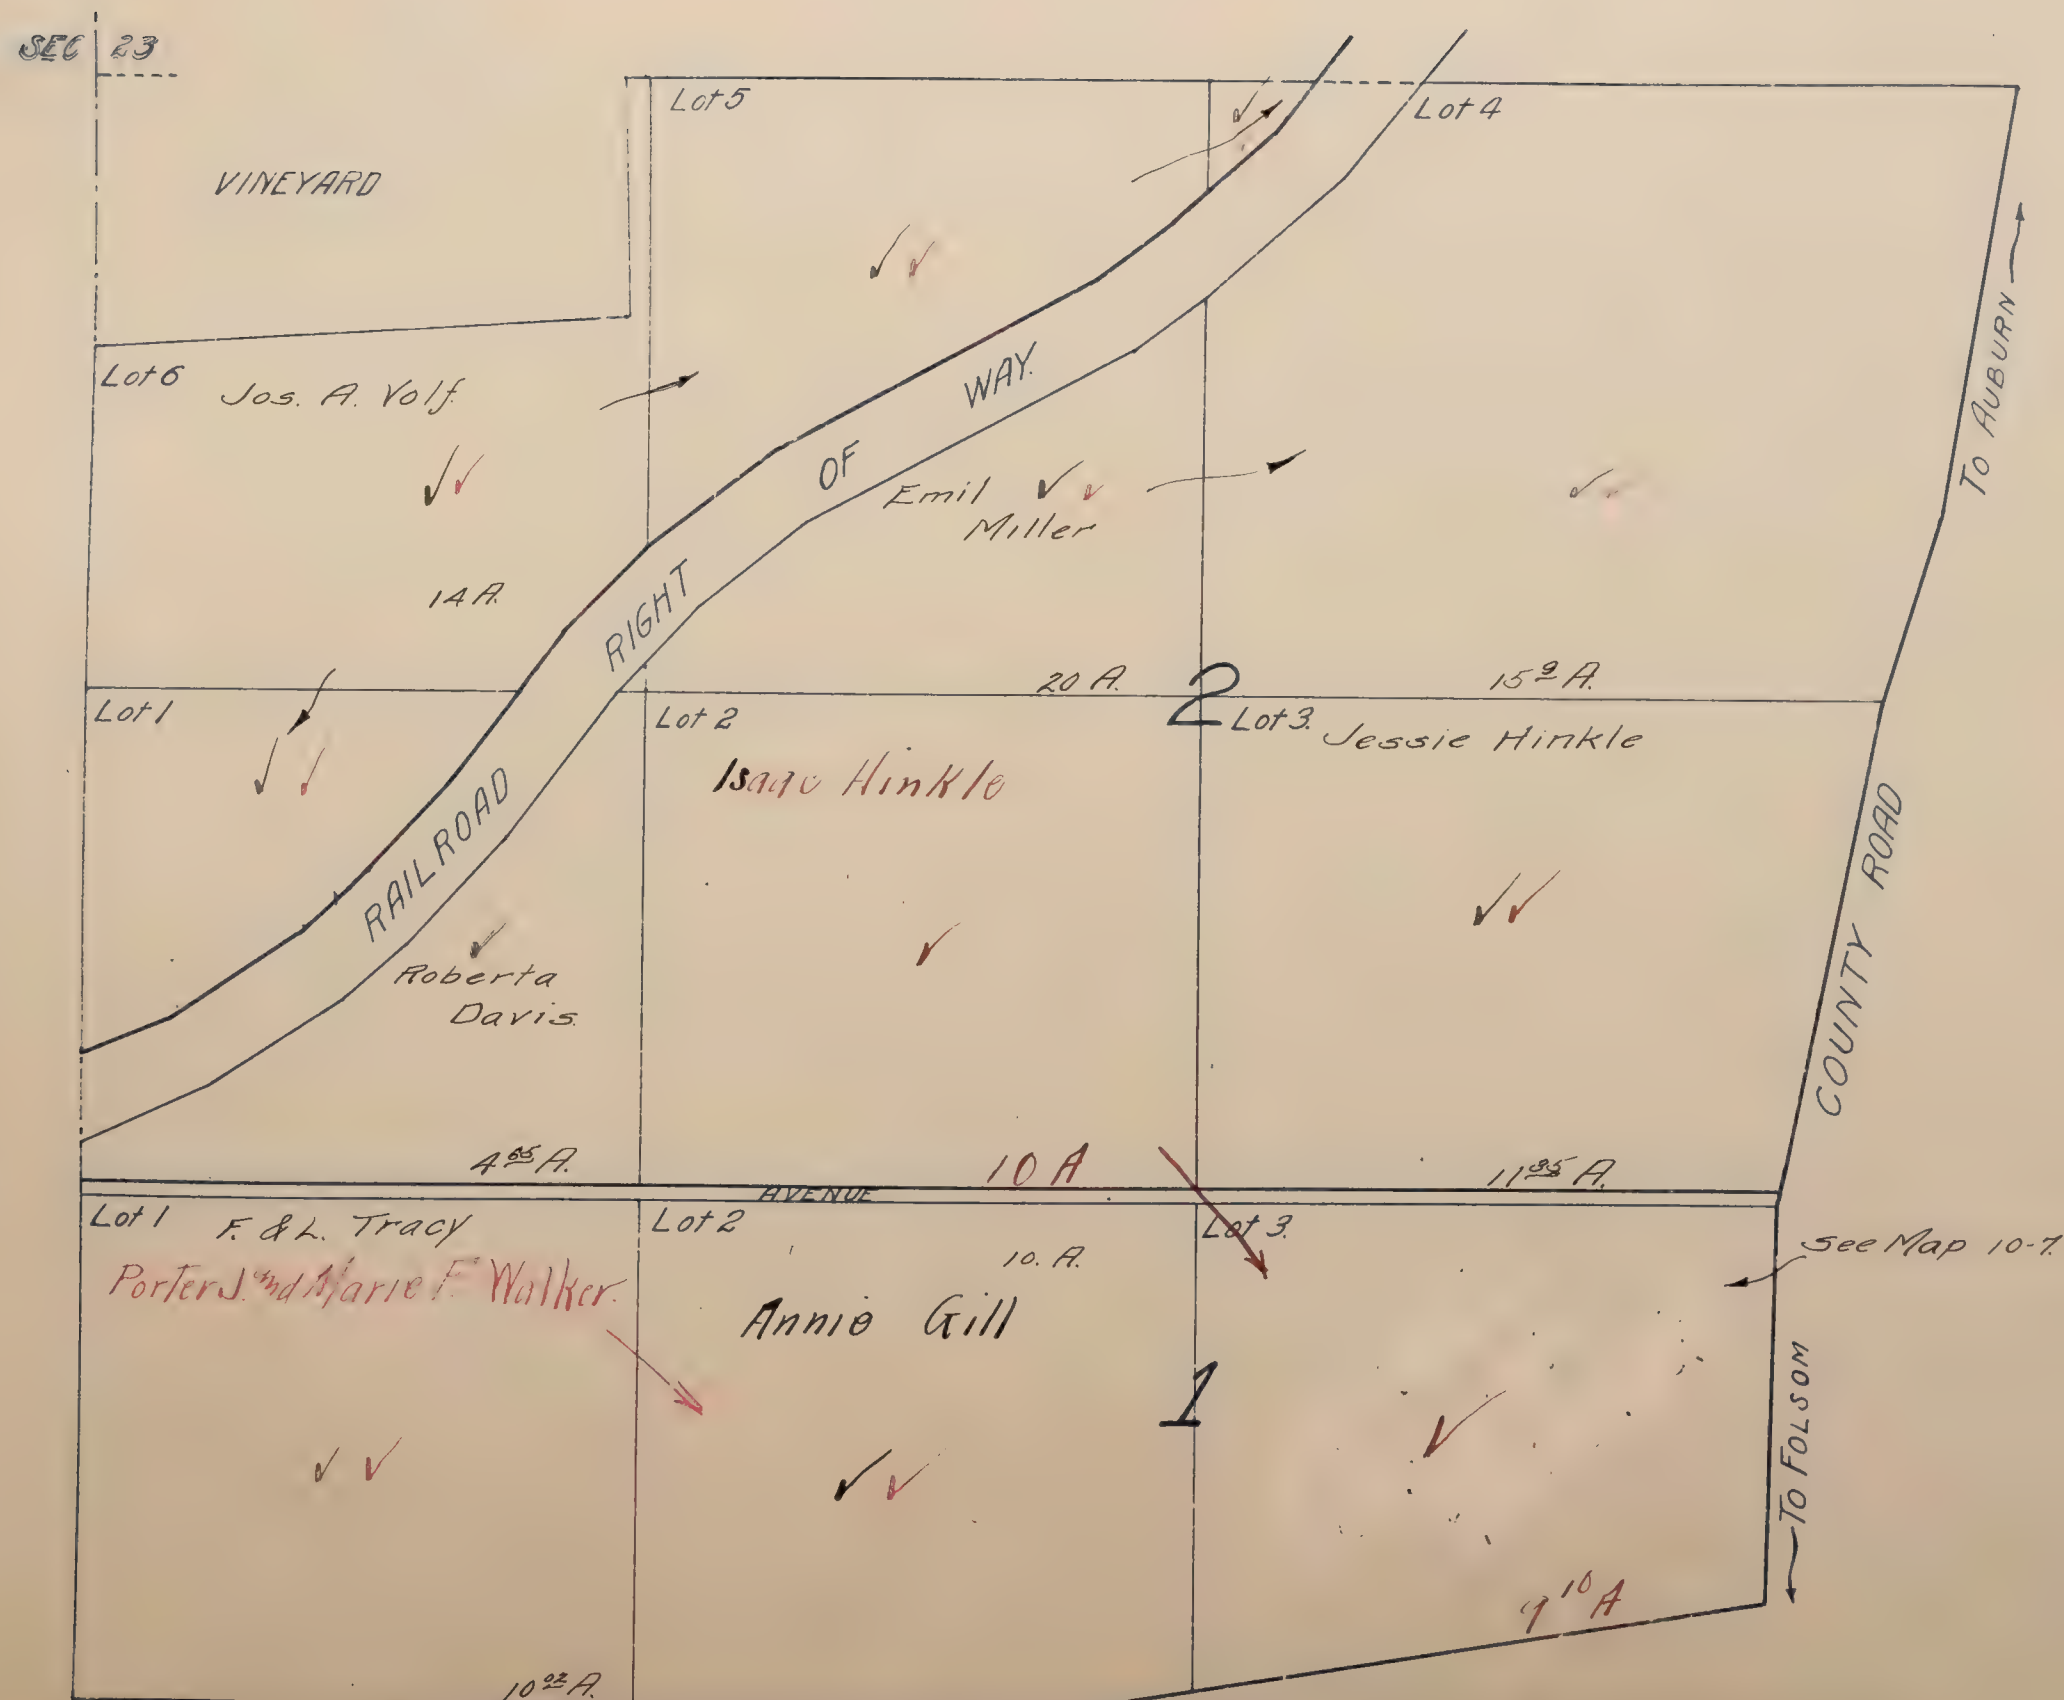

INWOOD

ISLETON

Scale 50 feet = 1 inch.

Black Ink-1919 Ownership
Red Ink-1920 Ownership

SACRAMENTO

RIVER

Isleton S.D.

WHARF

Creamery

PUBLIC SCHOOL

ST.

BLOCK 2

40'	Ida P. Gardiner et al.						40'
✓	✓	✓	✓	✓	✓	✓	
1	2	3	4	5	6	7	

BLOCK 3

40'	D.W. Earl.		40'
✓	✓	✓	
1	2	3	

School

Charles L. Gardiner ✓
60'x160' E. of Blk 3.

ST.

SECOND

ST.

40'	40'	40'	40'	40'	40'	40'
✓	✓	✓	✓	✓	✓	✓
2	3	4	5	6	7	

Ida P. Gardiner	W.M. Hutton	O.C. Wilson	Ida P. Gardiner et al.
✓	✓	✓	✓
1	2	3	4

40'	40'	40'
✓	✓	✓
1	2	3

60'	60'
✓	✓
Ethel E. Gardiner	J. H. Leimbach

BLOCK 6

32'	40'	40'	40'	40'	40'
✓	✓	✓	✓	✓	✓
12	11	10	9	8	

BLOCK 5

40'	40'	40'	30'	30'	40'
✓	✓	✓	✓	✓	✓
16	15	14	13	12	11

40'	40'	40'
✓	✓	✓
4	5	6

THIRD

ST.

Lot 40'x180'
Sofia Jensen ✓

Alice M. Bryan
Henrietta C. Hansen ✓

Lot 50'x120' ✓
Mrs. C. A. Perkins.

ISLETON

Mapped.


Black Ink-1919 Ownership
Red Ink-1923 Ownership

JACKMAN TRACT

BEING THE
S.W. 1/4 of Sec. 19, T.8N., R.6E

Scale: 400' = 1"

Sierra S.D.

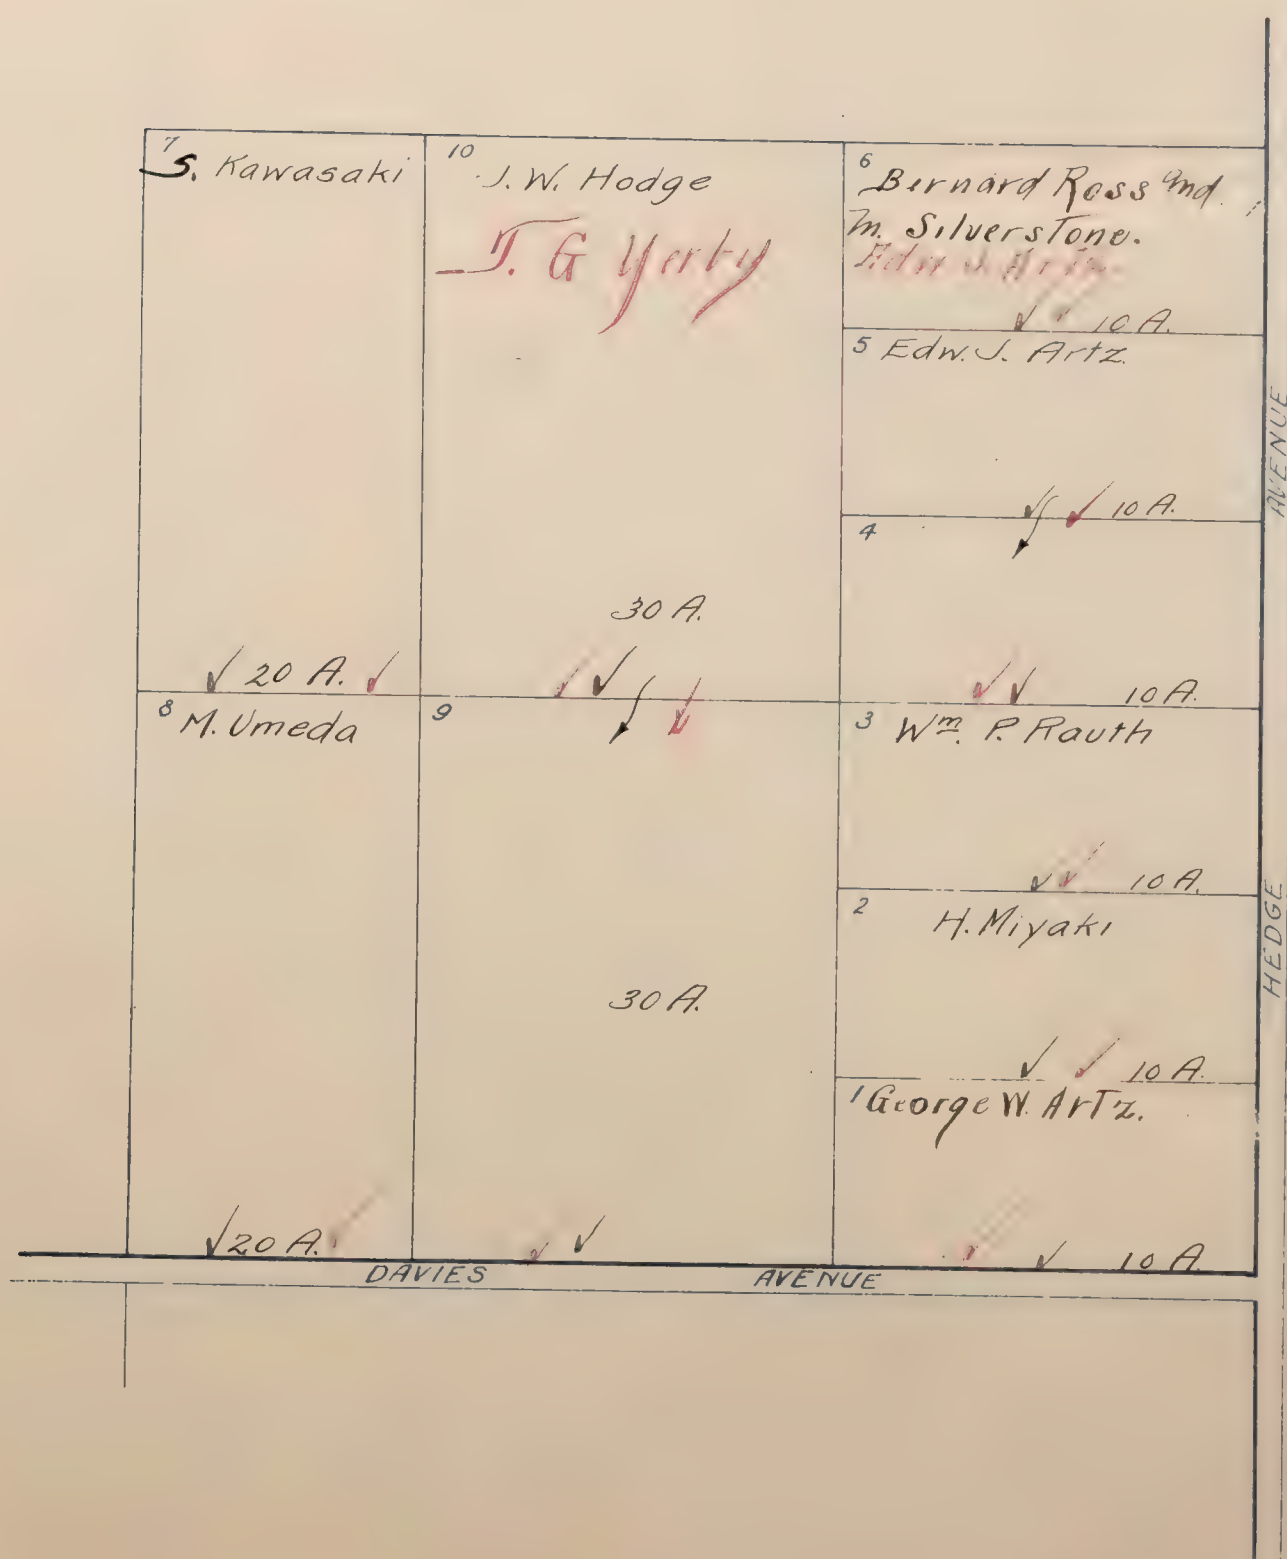

Black Ink-1919 Ownership
Red Ink-1923 Ownership

JENSEN VILLA

LOCATED IN

N.W. 1/4 of Sec. 19, T.8N.R.5E.

Scale: 1"=60'

Blanks assessed to Anna M. Jensen

SHOP SITE

AVENUE

WESTERN

1	2	3
✓ ✓	✓ ✓	✓ ✓
4 Giovanni Inghilleri ✓		
5	✓ ✓	
6	✓ ✓	
7	✓ ✓	
8 Standard Realty & Dev. Co. ✓		
9	✓ ✓	
10	✓ ✓	


11	12	13
✓ ✓	✓ ✓	✓ ✓
14 ✓		
15 ✓		
16 J. C. Jensen ✓		
17 ✓		
18 ✓		
19 Anton Madsen ✓		
20 ✓		

1	2	3	4
✓ ✓	✓ ✓	✓ ✓	✓ ✓
5 ✓			
6 ✓			
7 B ✓			
8 ✓			
9 ✓			
10 ✓			
11 ✓			
12 ✓			

SUNSET

AVENUE

1	2	3	4	5	6	7	8	9	10	11
✓ ✓	✓ ✓	✓ ✓	✓ ✓	✓ ✓	C ✓	✓ ✓	✓ ✓	✓ ✓	✓ ✓	✓ ✓

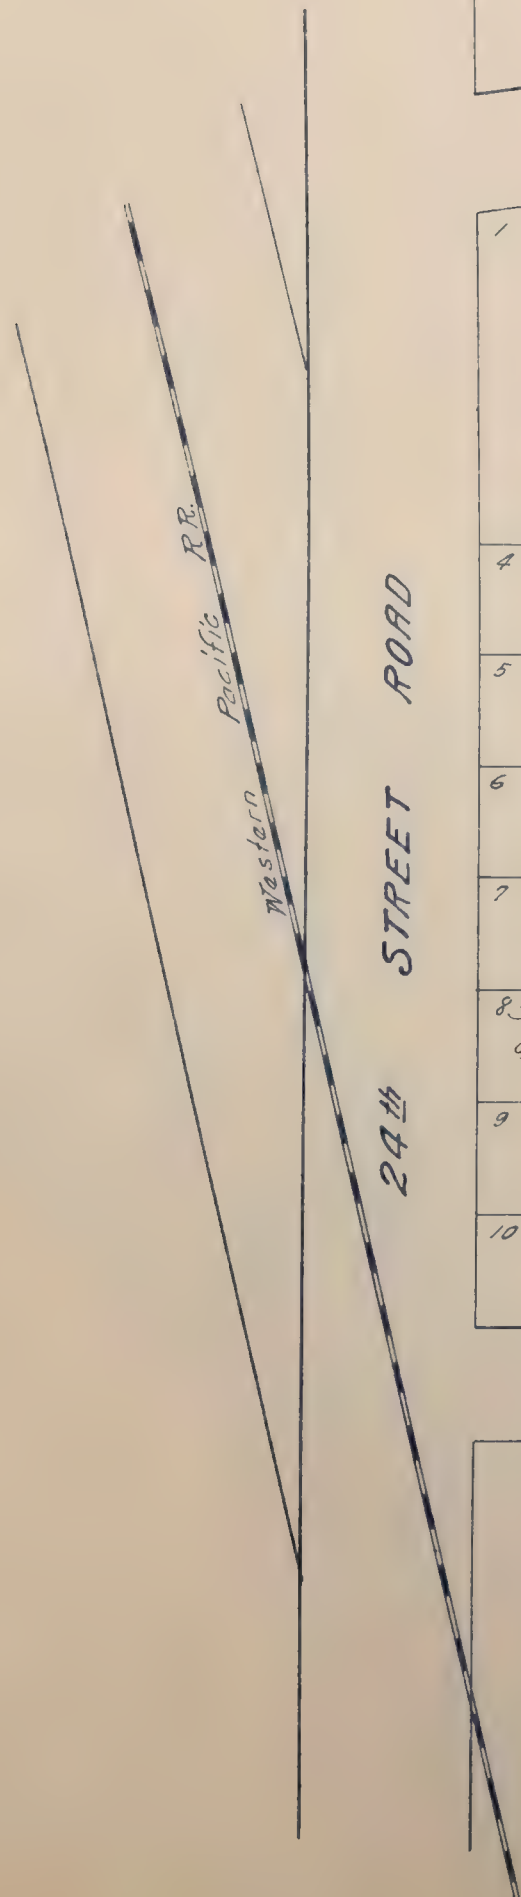


Black Ink-1919 Ownership
Red Ink-1920 Ownership

JOHNSON HEIGHTS

LOCATED IN
S 1/2 of S20.6. T2N R5E
Scale 1"=100'

Blanks to G.A. White ✓
All lots 5A, unless otherwise noted.

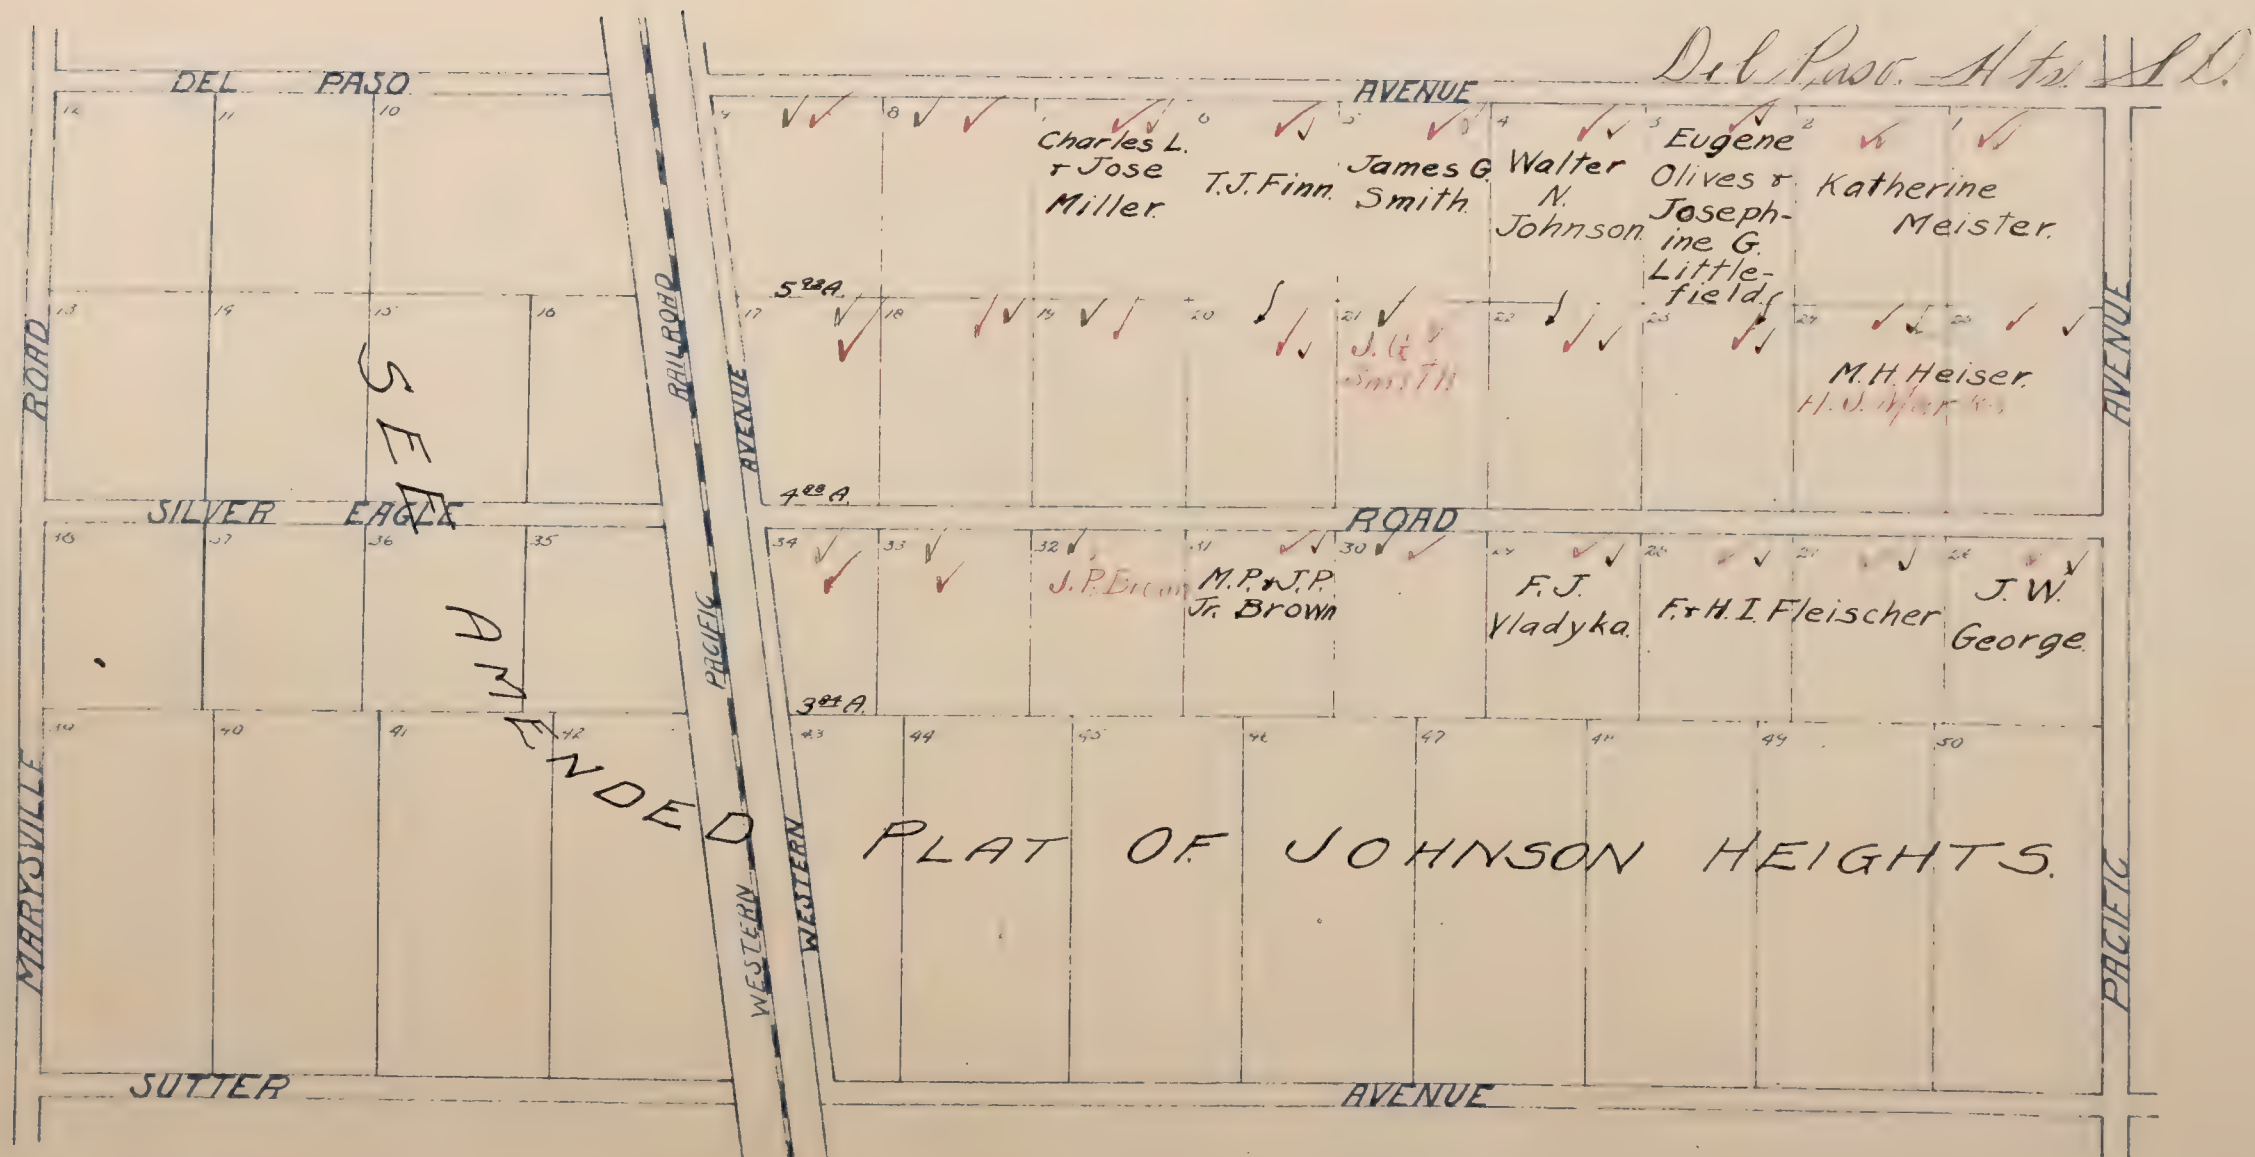


Mapped.

Black Ink-1919 Ownership
Red Ink-1932 Ownership

AMENDED PLAT OF
JOHNSON HEIGHTS

LOCATED IN
S ½ of Sec. 3 - T.9N.R.5E.

Scale: 450' = 1"

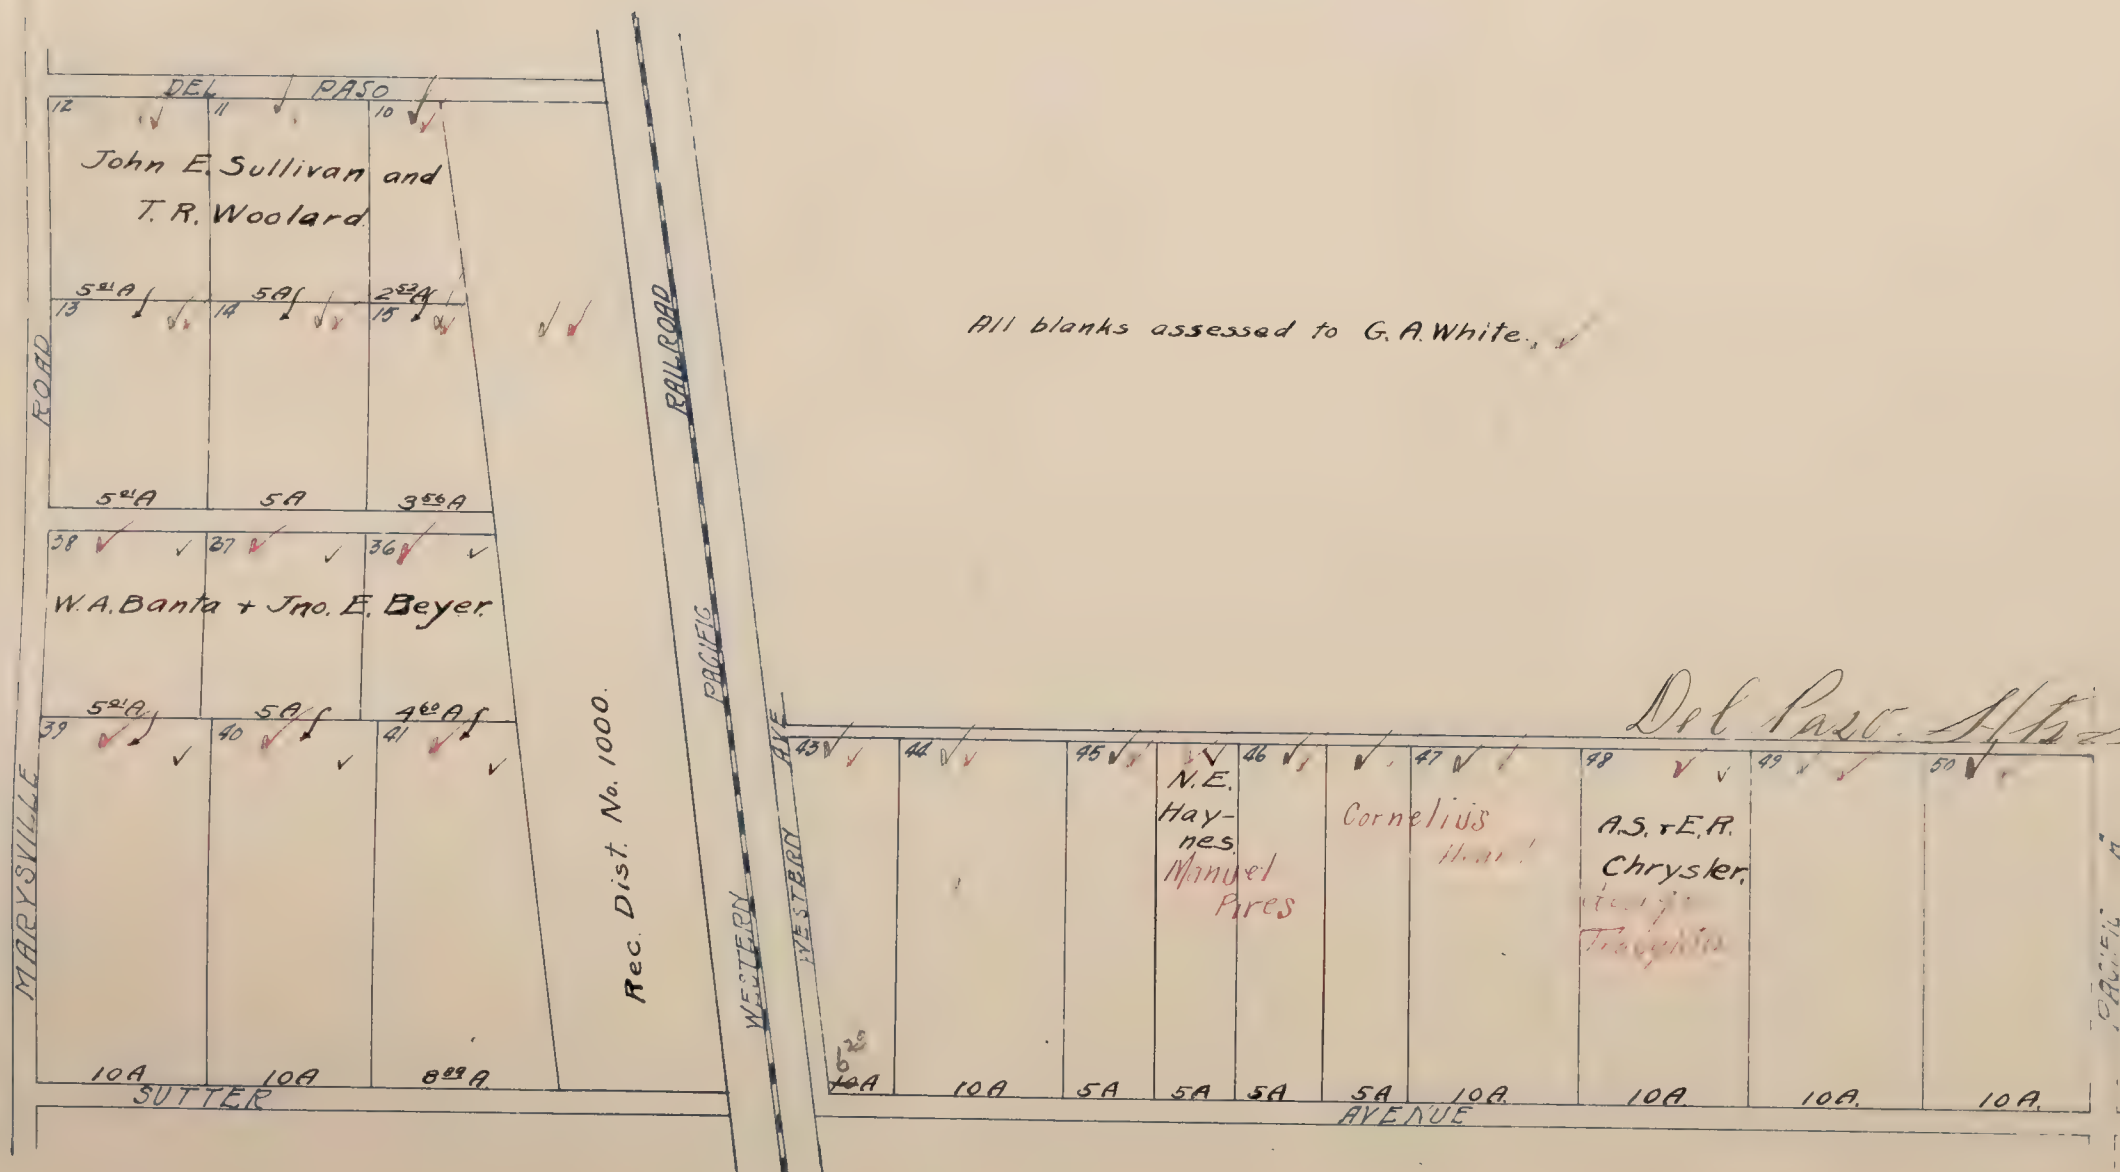

KENNEDY ACRES


BROOKE REALTY CO'S SUBDIVISION 107.

Scale 200 feet = 1 inch

Washington S.D.

Black Ink - 1910 Ownership
Red Ink - 1920 Ownership

KENNEDY

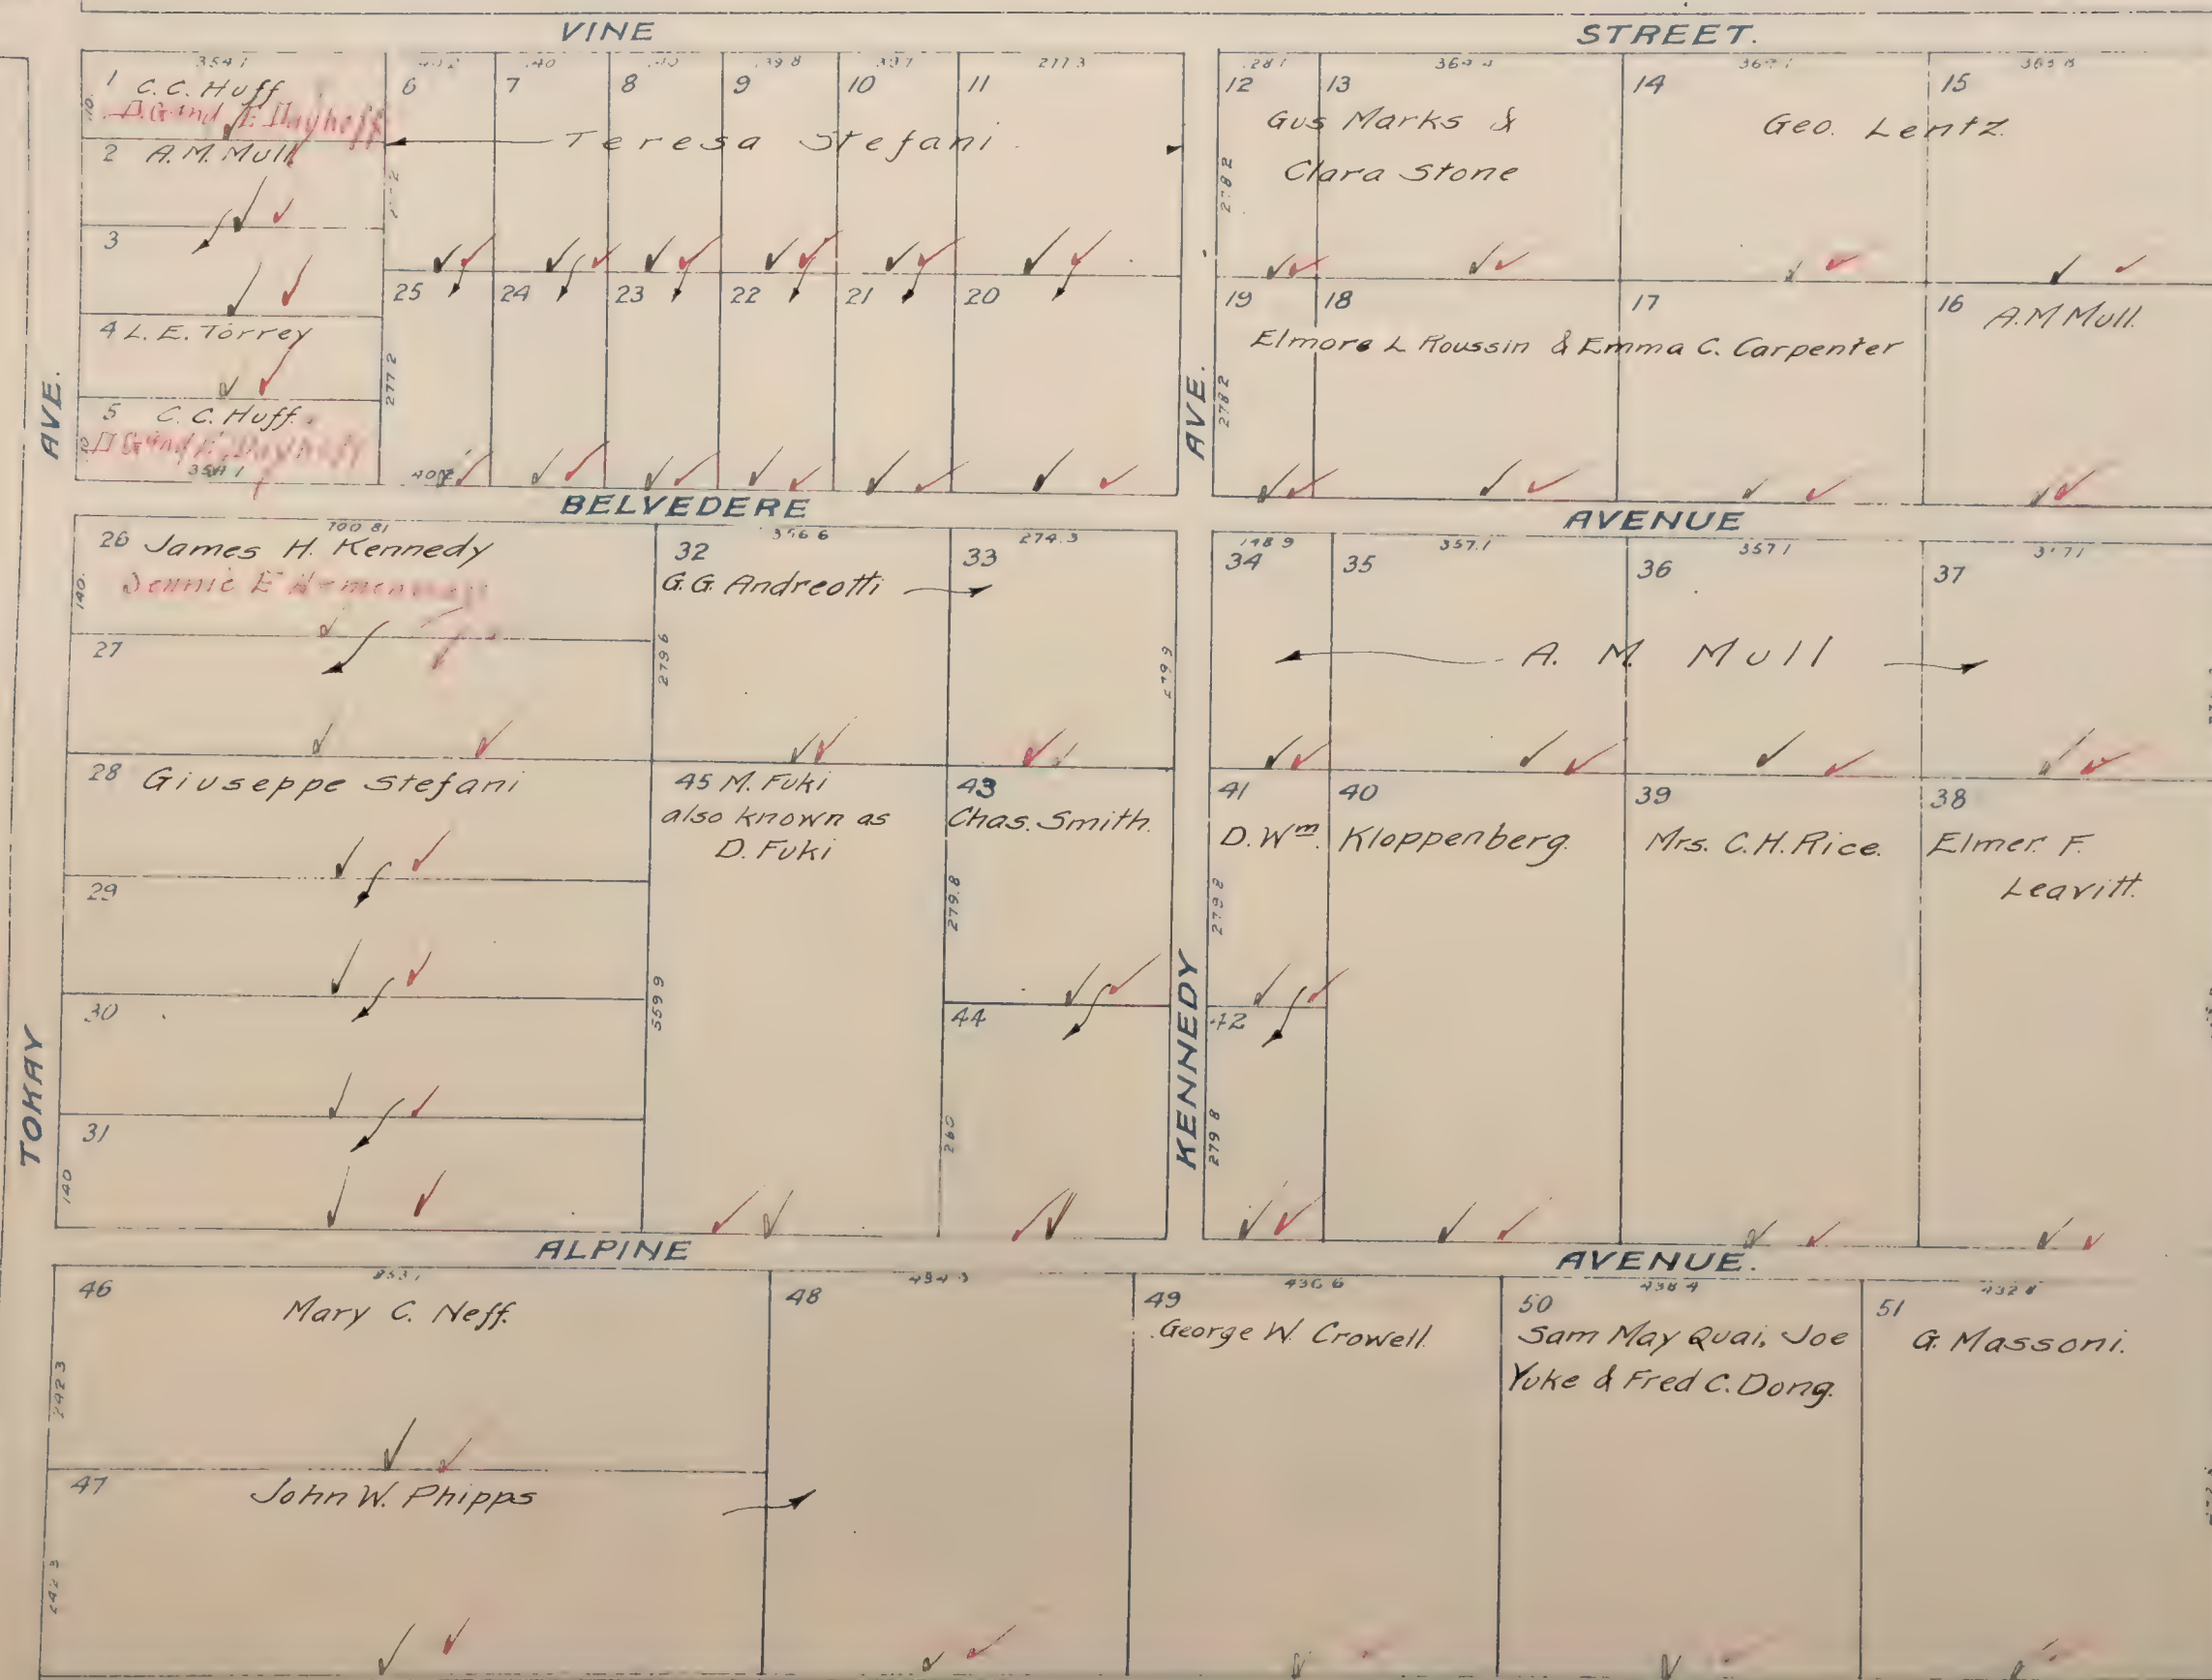

Mapped

Black Ink - 1919 Ownership
Red Ink - 1920 Ownership

KIESSIG TRACT

LOCATED IN
NW 1/4 of NE 1/4 of Sec. 31 T8N R3E.

Map of
~~Enterprise~~ (S. 11.)

COUNTY		ROAD	
1. H. J. Jones	2. Clarence C. Harner & Mabel Woerner	3. H. J. Jones	4. F. L. Dean
✓ ✓ 5A.	✓ ✓ 5A.	✓ ✓ 5A.	✓ ✓ 5A.
KIESSIG AVENUE			
8. Harry Kiessig	7. Etta L. Sherer	6.	5.
✓ ✓ 5A.	✓ ✓ 5A.	✓ ✓ 5A.	✓ ✓ 4 1/4 A.

Mapped.


Black Ink-1919 Ownership
Red Ink-1920 Ownership

KILDONAN OAKS

located in
Section 22 T7N R.6E.
Scale: 1"=300ft

Pleasant Grove SD

Blanks assessed to Cath. Thompson ✓

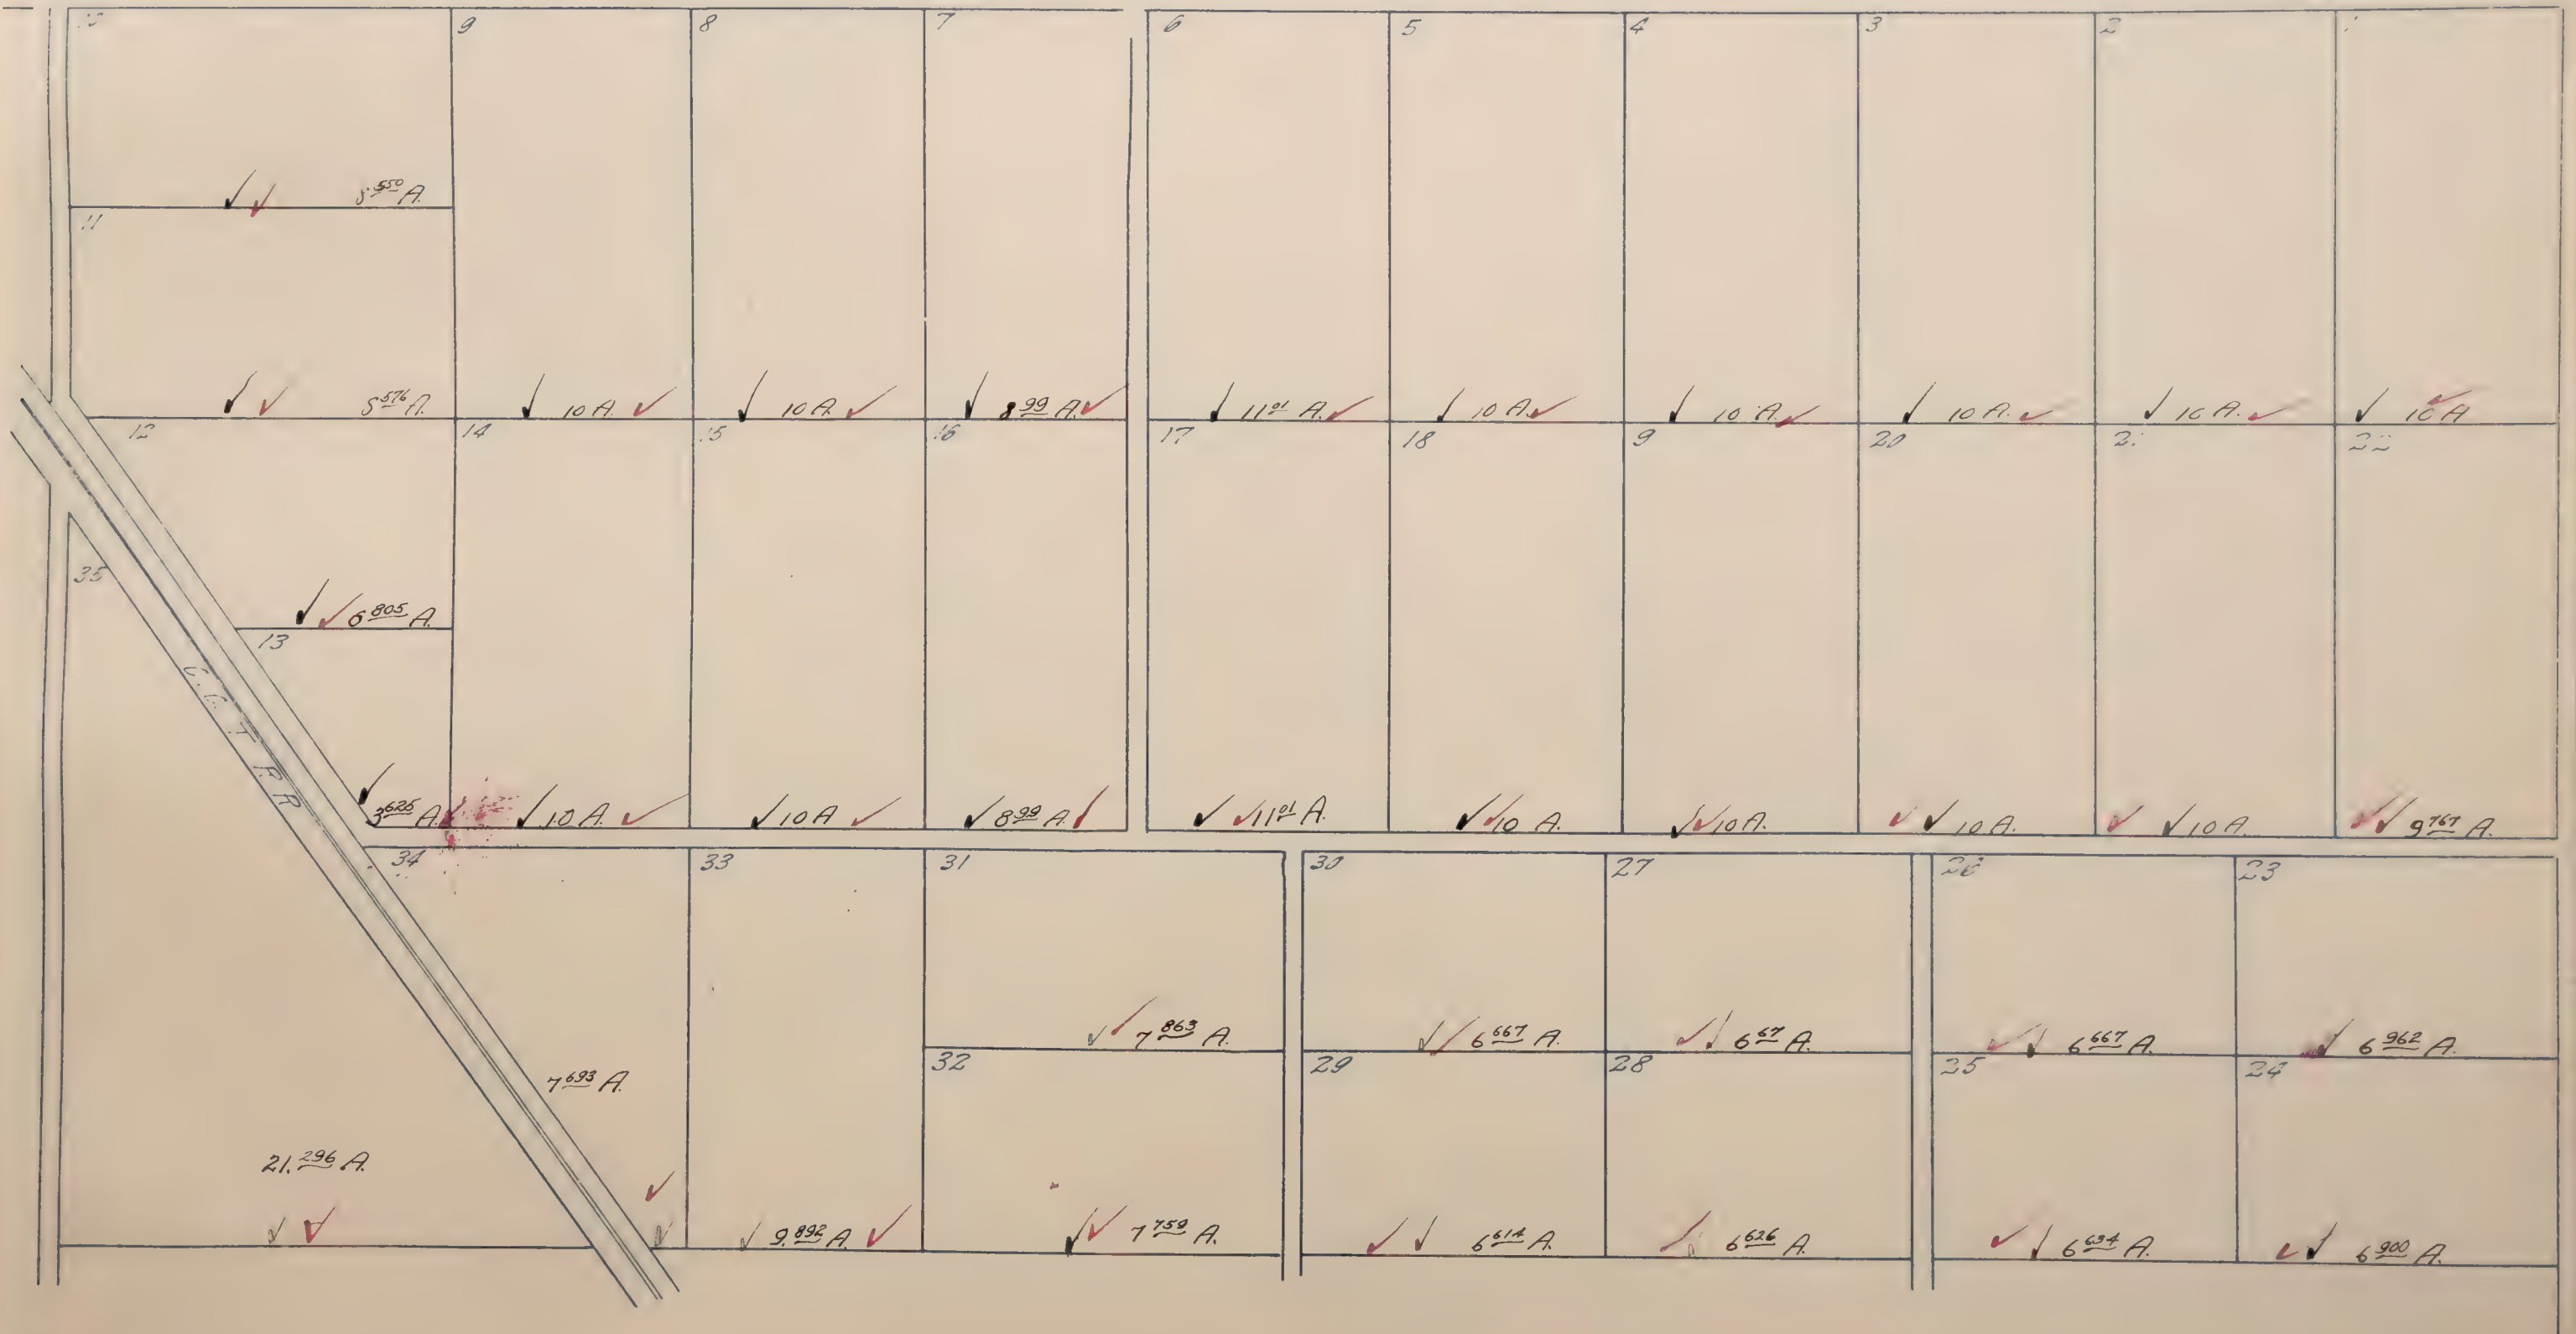

Black Ink-1919 Ownership
Red Ink-1920 Ownership


LAKE HOUSE ACRES
OR
BROOKE REALTY CO'S. SUBDIVISION NO 113.
LOCATED IN THE
N.E. 1/4 of Sec. 33, T.8N., R.5E.
Scale: 200' = 1"



Black Ink-1919 Ownership
Red Ink-1920 Ownership

AMENDED MAP OF
LAKE HOUSE ACRES
OR
BROOKE REALTY CO'S. SUBDIVISION NO. 125.
LOCATED IN THE
NE. 1/4 of Sec 33, T.8N., R.5E.
Scale: 200' = 1"

Blanks assessed to John Jacob Frank Julius Louis &
Albert Young & Bertha Schraft. ✓✓

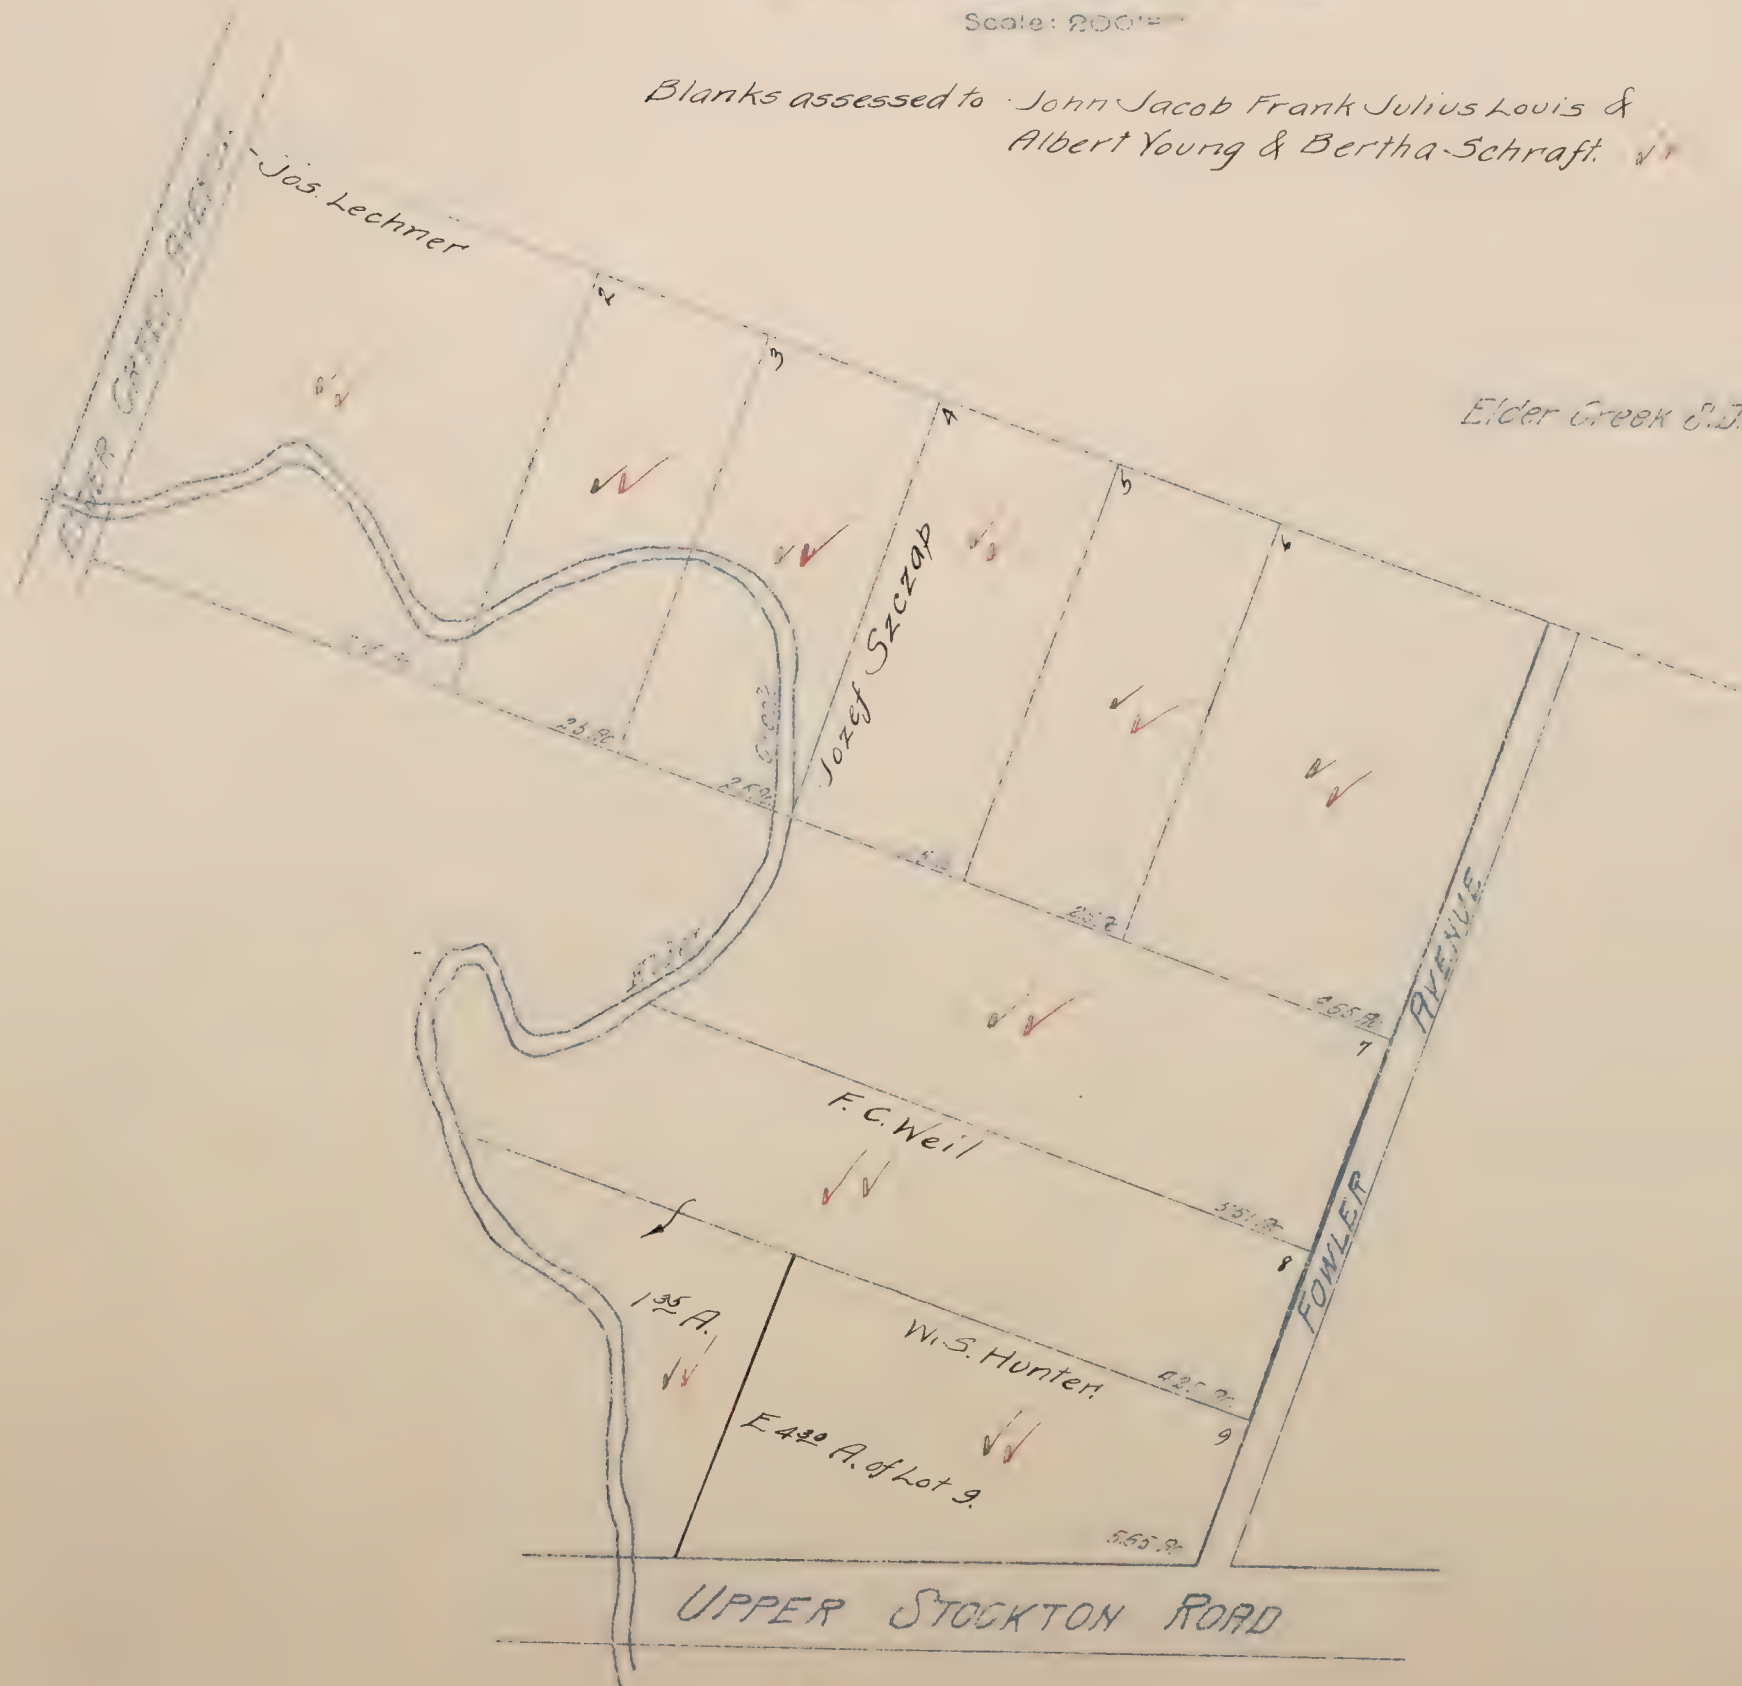

Mapped.

Black Ink-1919 Ownership
Red Ink-1920 Ownership

LAUREL HIGHTS

BEING

Lot 37, Block 27 in the LOUISIANA TRACT

LOCATED IN THE

N.E 1/4 of Sec. 19 T.8N., R.5E.

Scale: 30' = 1"

*Trust Richard
Goldberg J.D.*

LAUREL

AVENUE

HICKORY
STREET

1 Eugene C. ✓ Crosby	2 R. M. ✓ Tenbrook	3 Susan C. ✓ Hendrix	4 F. M. Harlan ✓	5 Eugene C. ✓ Crosby	6 W. S. Ives ✓	7	8 Elliott ✓ Cooper
✓	✓	✓	✓	✓	✓	✓	✓

LAUREL

Mapped.

LEMON HILL ANNEX

N. $\frac{1}{2}$ of S.W. $\frac{1}{4}$ SEC. 27 T. 8 N R. 5 E.

Scale 4 chains = 1 inch

Black Ink = 1919 Ownership
Red Ink = 1920 Ownership

Elder Creek S.D.

1 R.J. Fitzsimmons	2 Rosa Fiolo 1920	3 Tararo Cuccia	4 Mrs. W.B. Fox	5 Geo. B. Adams	6 Martin Sapunar	7 Kasper Thaler	8 John Engstrom
✓	✓	✓	✓	✓	✓	✓	✓
16	15 Bell M. Goldstein	14	13	12 Angelo Lazzarini Albert Lazzarini	11 P. Berriesford	10 Kasper Thaler	9 C.M. Goethe
✓	✓	✓	✓	✓	✓	✓	✓


LEMON HILL TRACT

S. 1/2 SECTION 28 T. 8 N. R. 5 E.

Scale 4 chains=1 inch.

Black Ink-1919 Ownership
Red Ink-1910 Ownership

Elder Creek S.D.

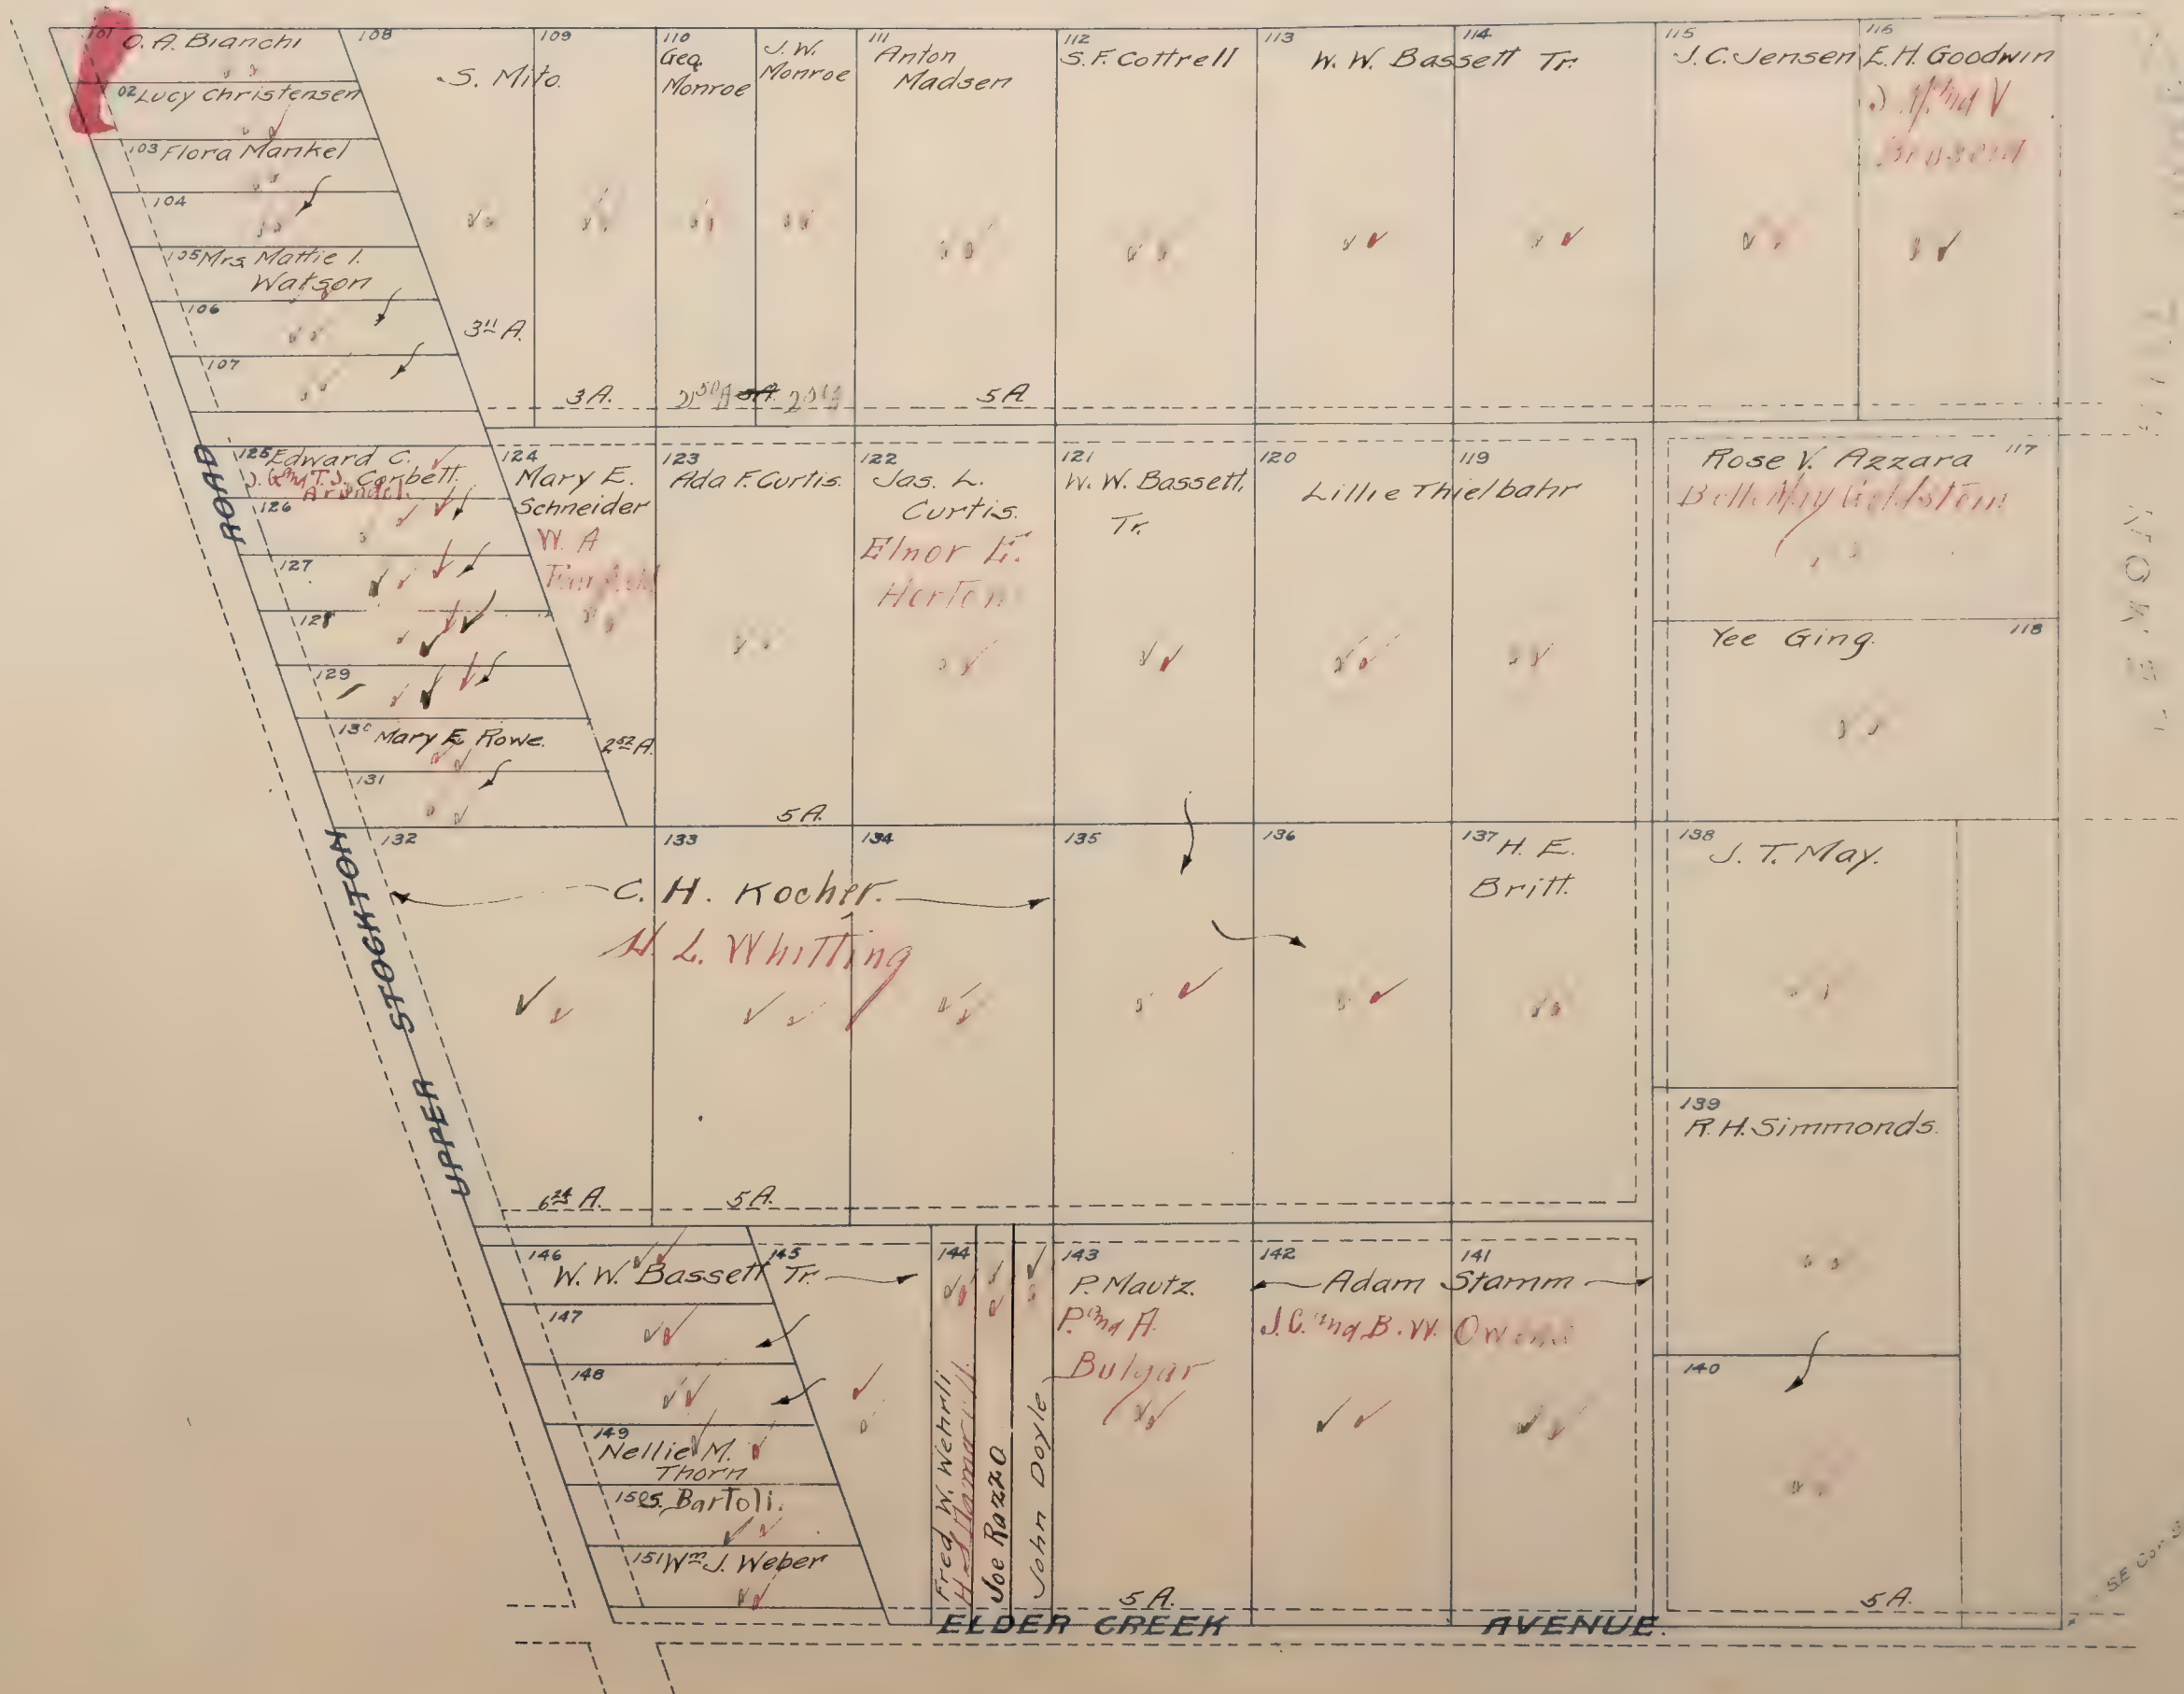

LE MORRIS SQUARE

located in
Section 15 RANCHO DEL PASO

Scale: 1"=40'
Black Ink-1919 Ownership
Red Ink-1920 Ownership

Blanks to Elizabeth Mahan & Mary L O'Neil

North East 1/4

EL CAMINO

AVE

ST

17th

AVE

OLIVE

Alley

1 ✓✓	2 ✓✓	3 ✓✓	4 ✓✓	5 ✓✓
------	------	------	------	------


6 ✓✓	15 ✓✓
7 ✓✓	14 ✓✓
8 ✓✓	13 ✓✓
9 ✓✓	12 ✓✓
10 ✓✓	11 ✓✓

16 ✓✓
17 ✓✓
18 ✓✓
19 ✓✓
20 ✓✓
21 ✓✓
22 ✓✓
23 ✓✓

L.M. LINCOLN EST.

located in
Sections 14-23 T8N.R4E
Scale 1"=200ft

Sutter SD

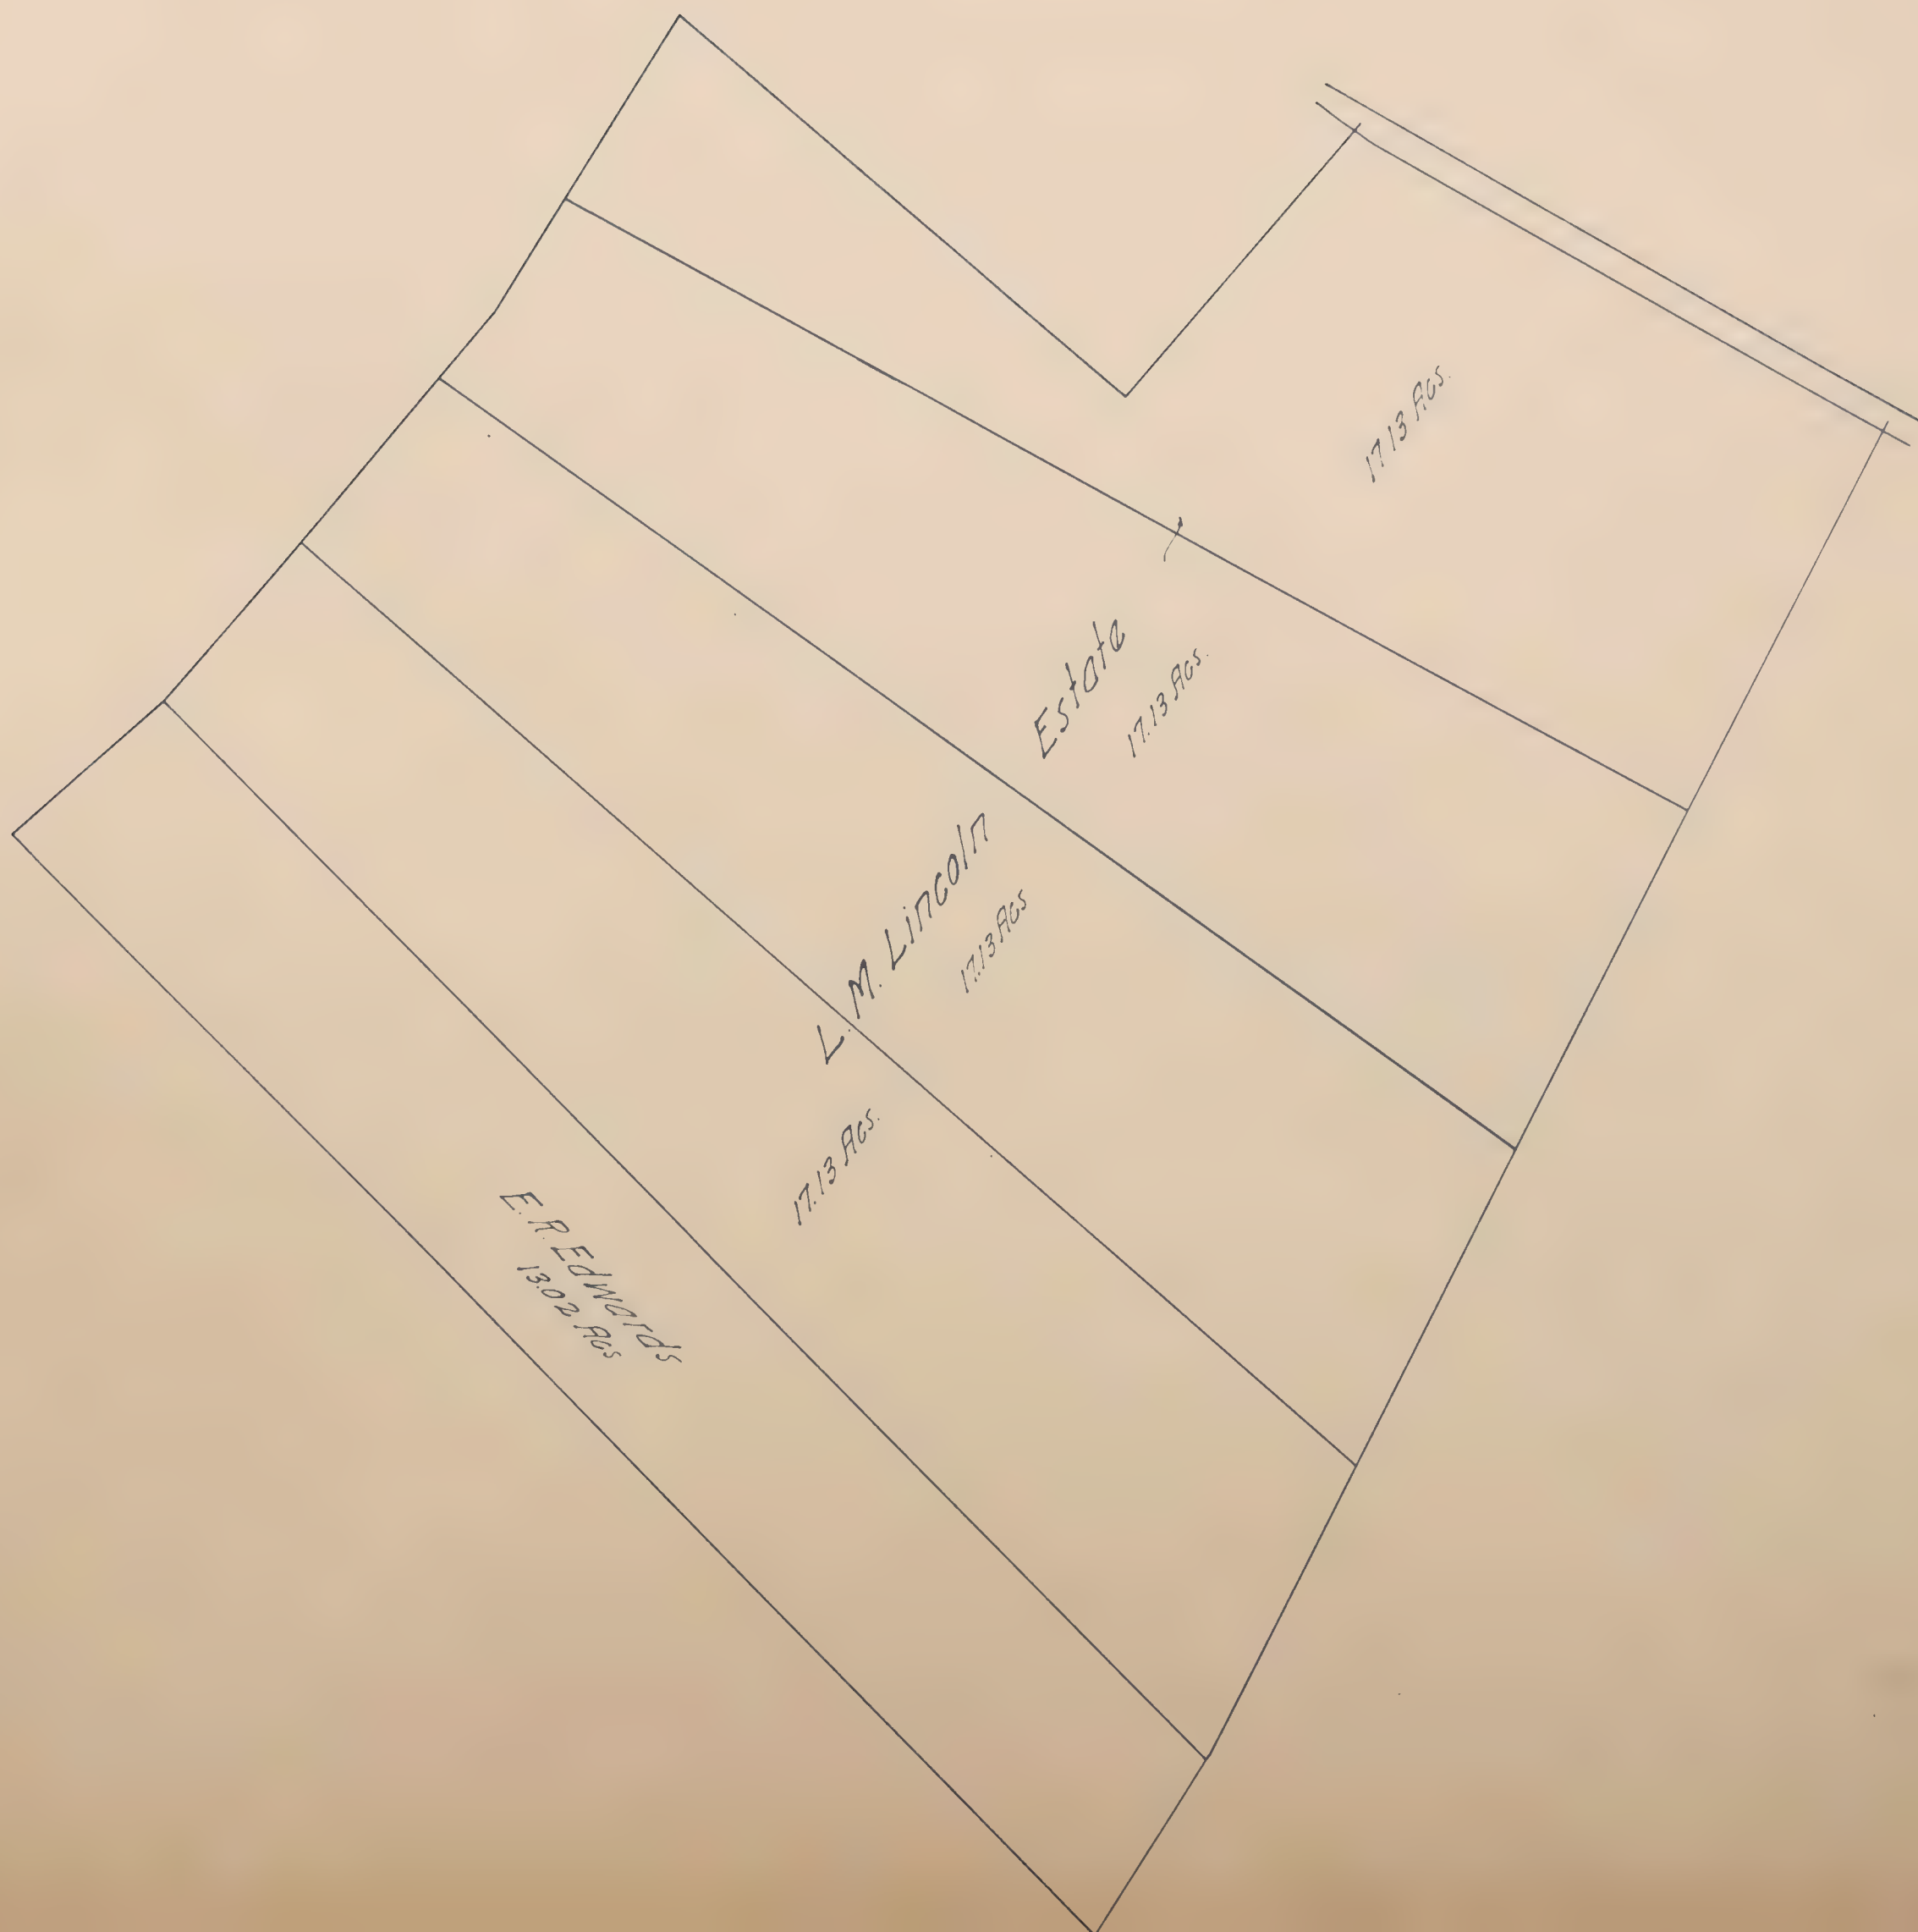

Mapped.

Black Ink-1919 Ownership
Red Ink-1939 Ownership

LINDA VISTA SUBDIVISION

Sub 23 & 8 North Sacramento
Rancho Del Paso Co.
Scale 1"=100'

H. J. Smith

Blanks to North Sacramento Land Co

SUB NO. 3
BLOCK 8




Mapped.

Black Ink=1910 Ownership
Red Ink=1920 Ownership

LOS AMERICANOS ACRES

LOCATED IN
Rancho Rio De Los Americanos
Scale 300'=1" — Brighton, CA

Blanks assessed to C.M. Goethe. ✓

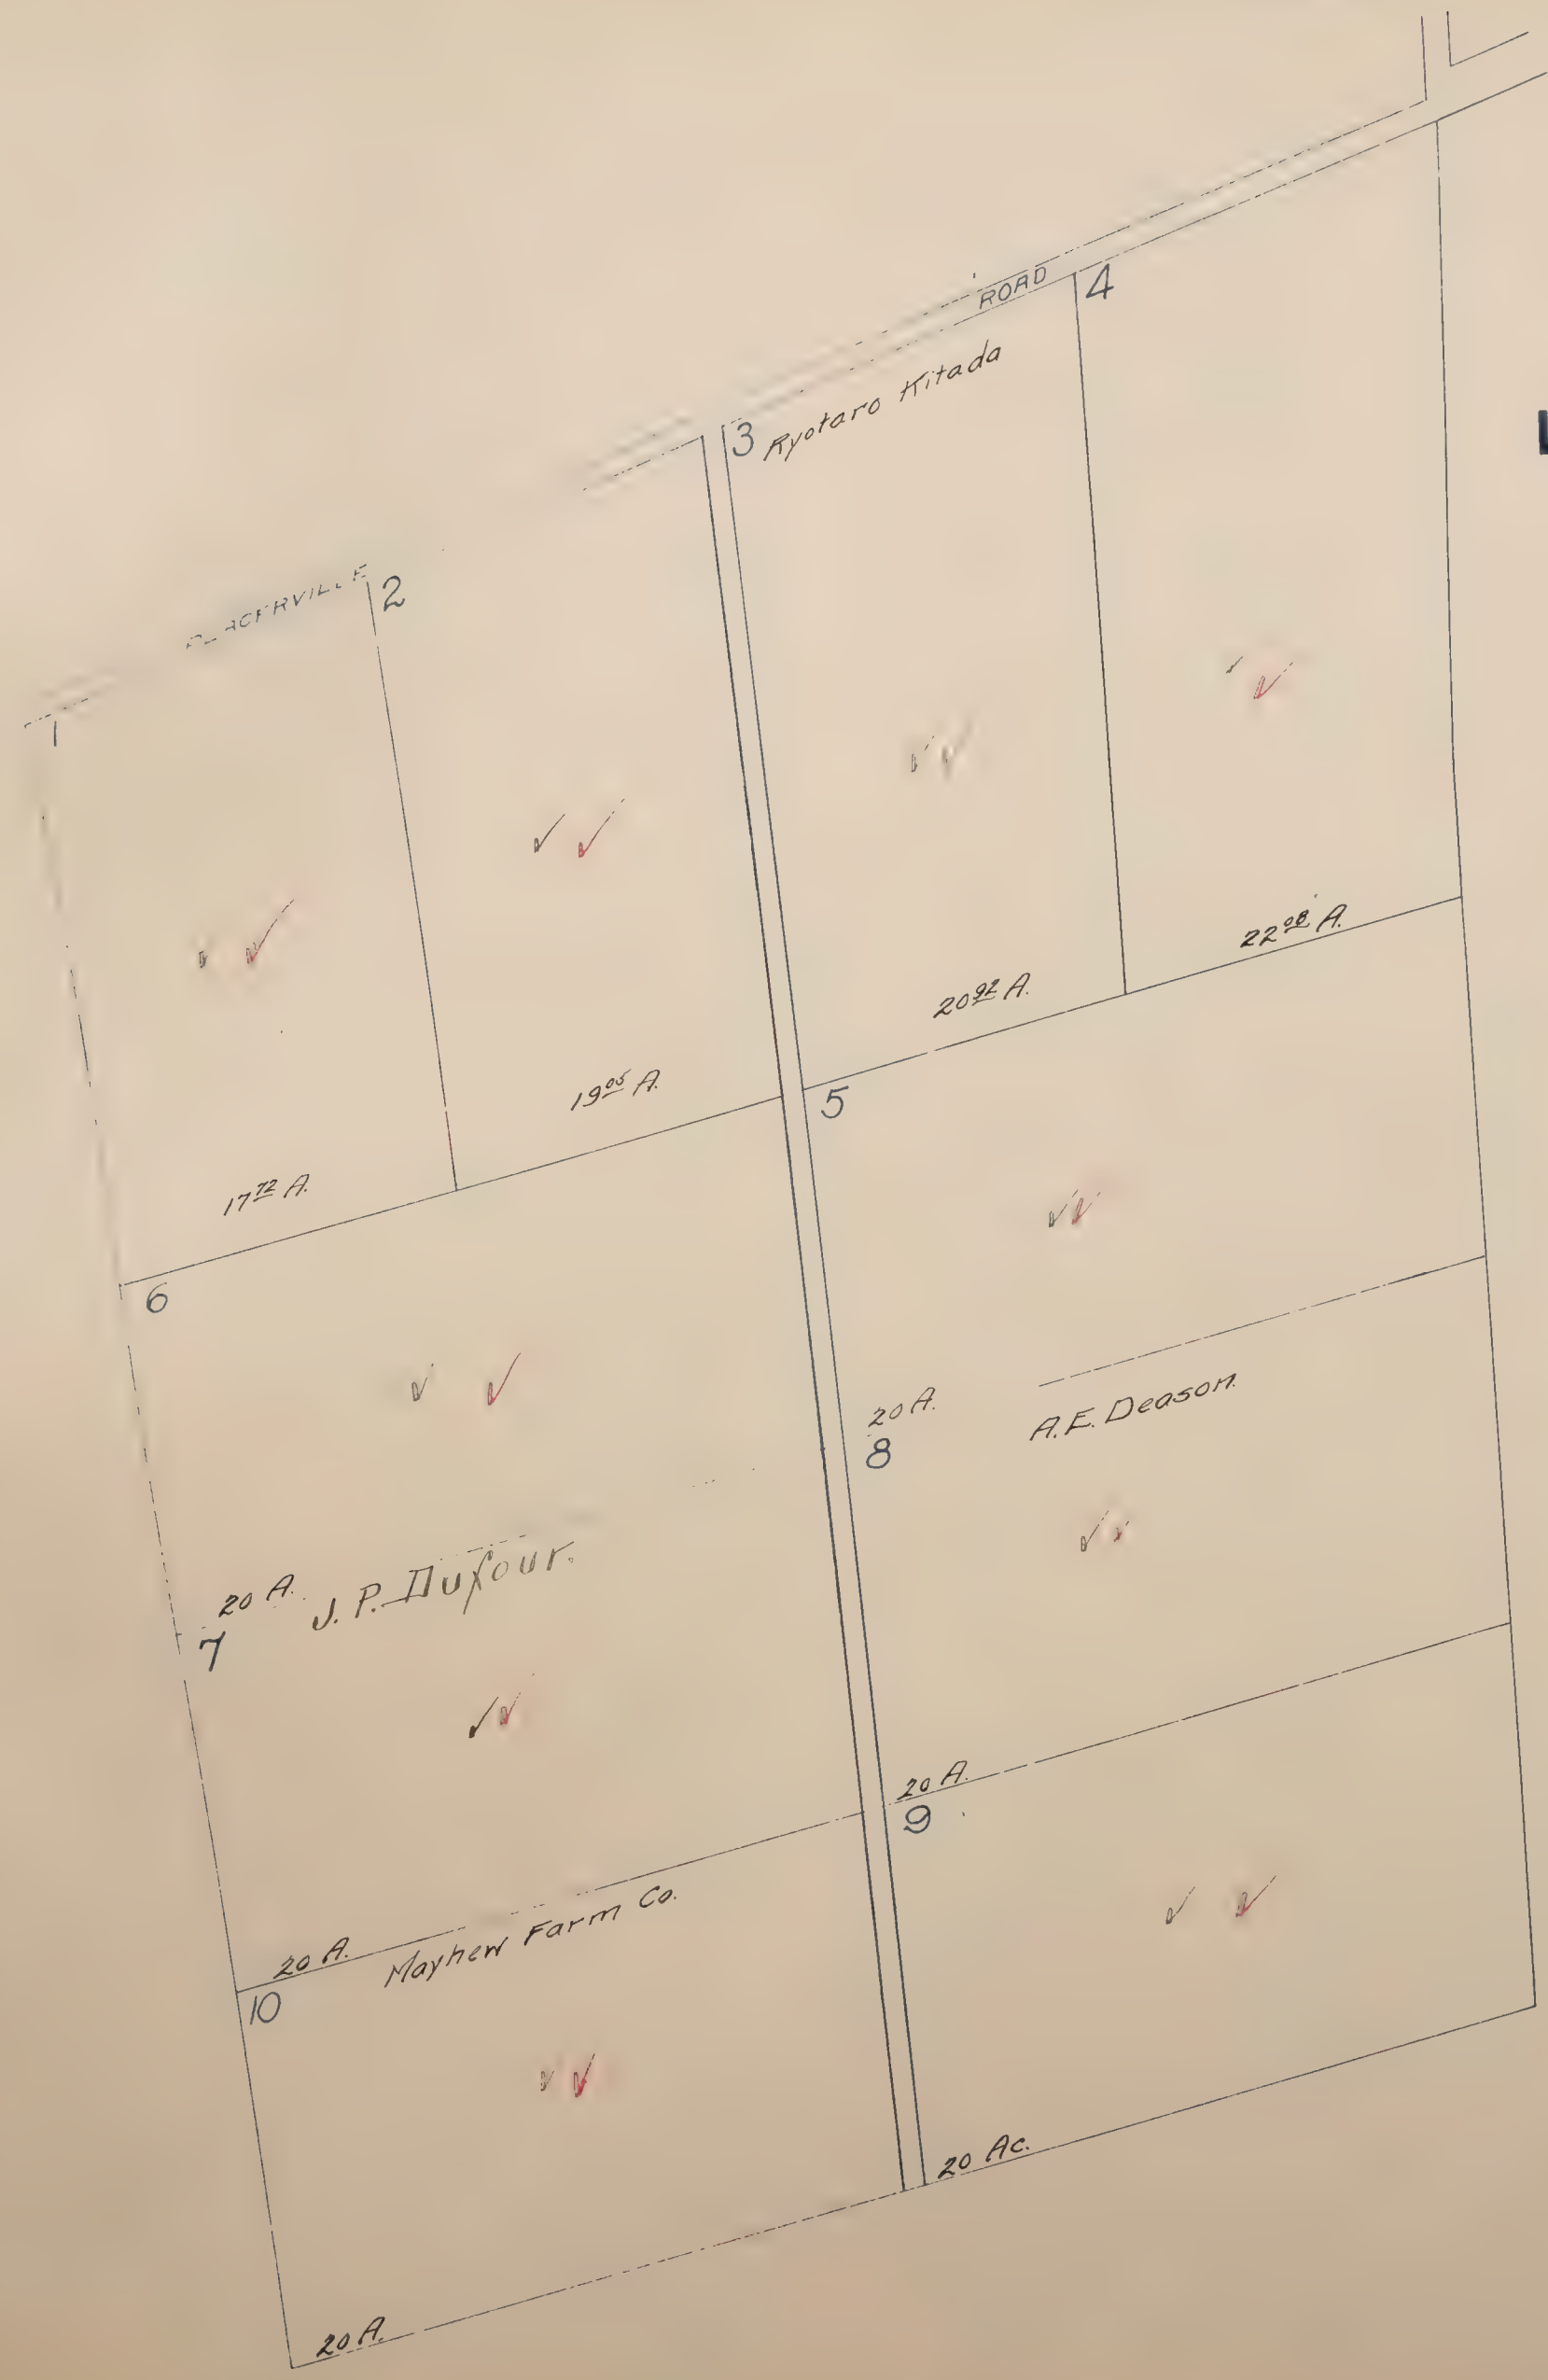


Black Ink-1919 Ownership
Red Ink-1919 Ownership

LOUISIANA TRACT.

N.E. 1/4 SEC. 19 T. 8 N. R. 5 E.

Scale 6 chains = 1 inch

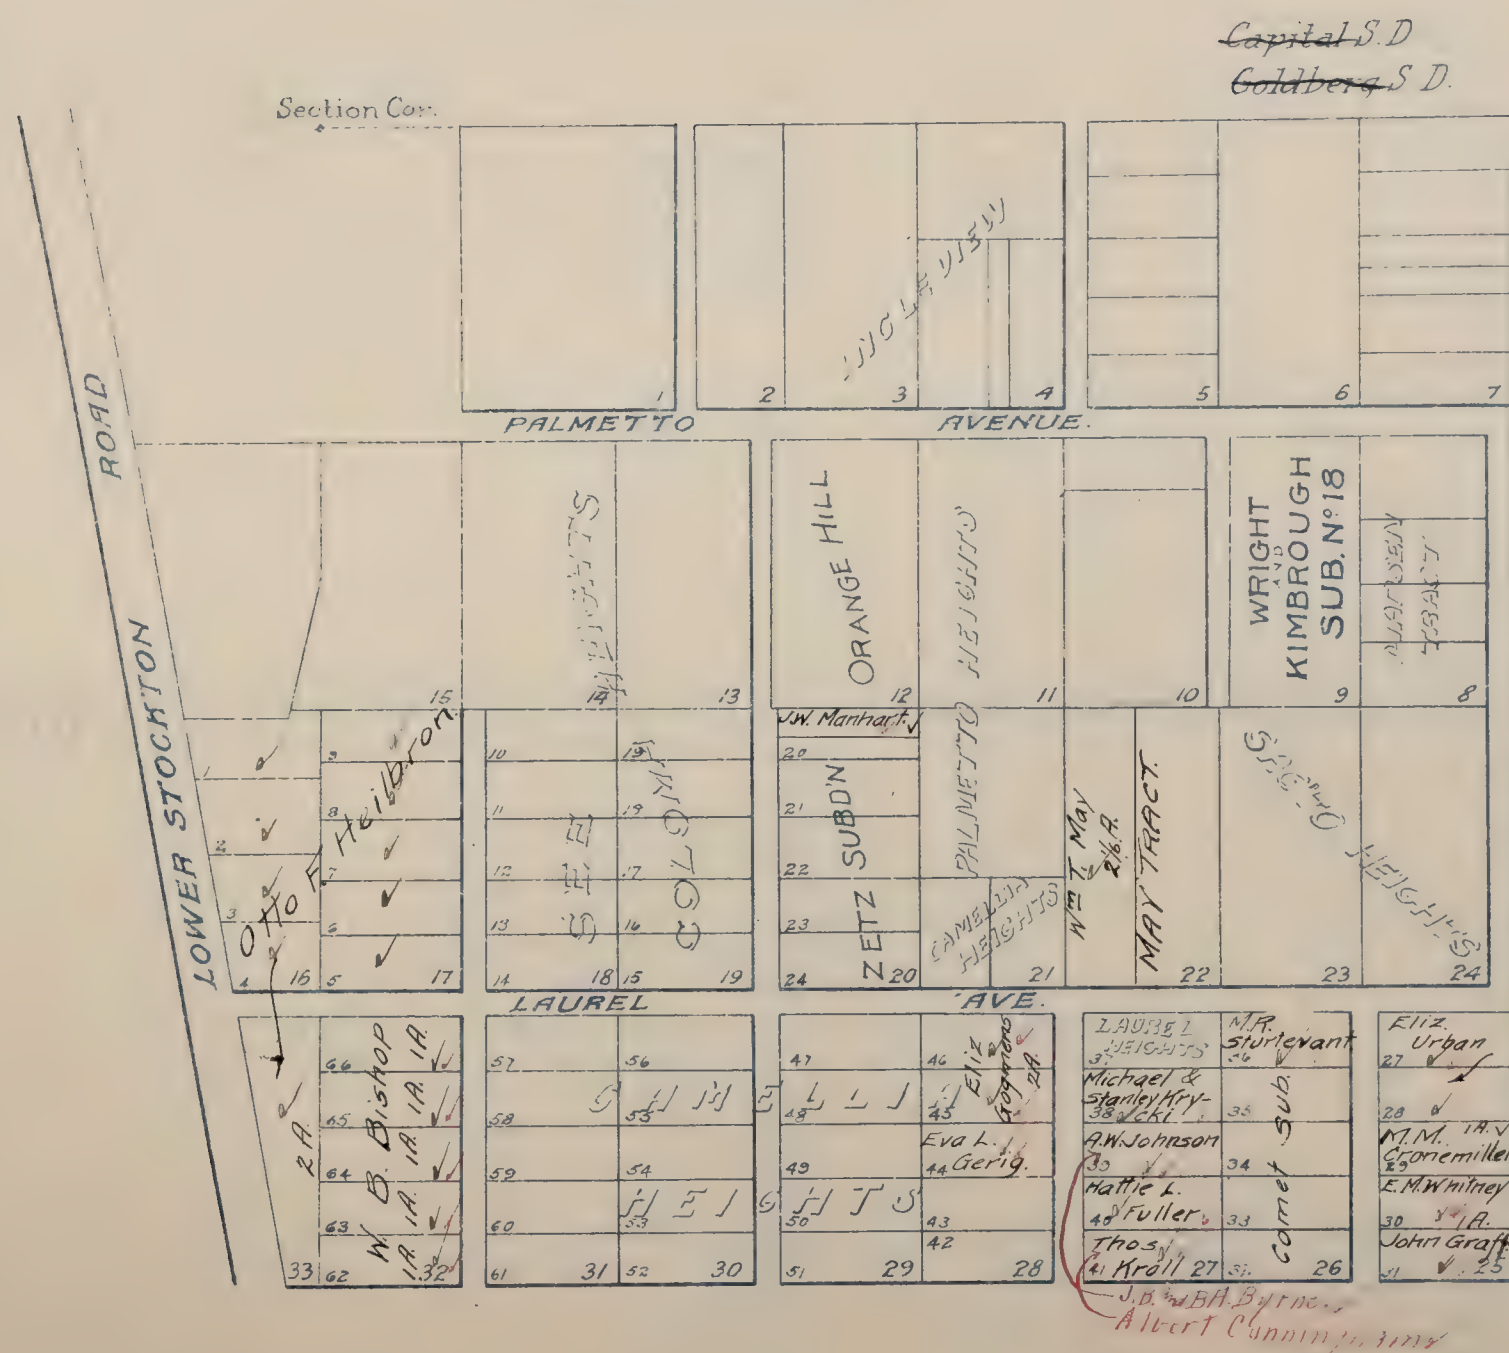


Mapped.

Black Ink-1919 Ownership
Red Ink-1929 Ownership

LUCERNE MEADOWS

LOCATED IN
Sec's 22-23 of T.7N.R.5E.
Scale: 1" = 5 Chains

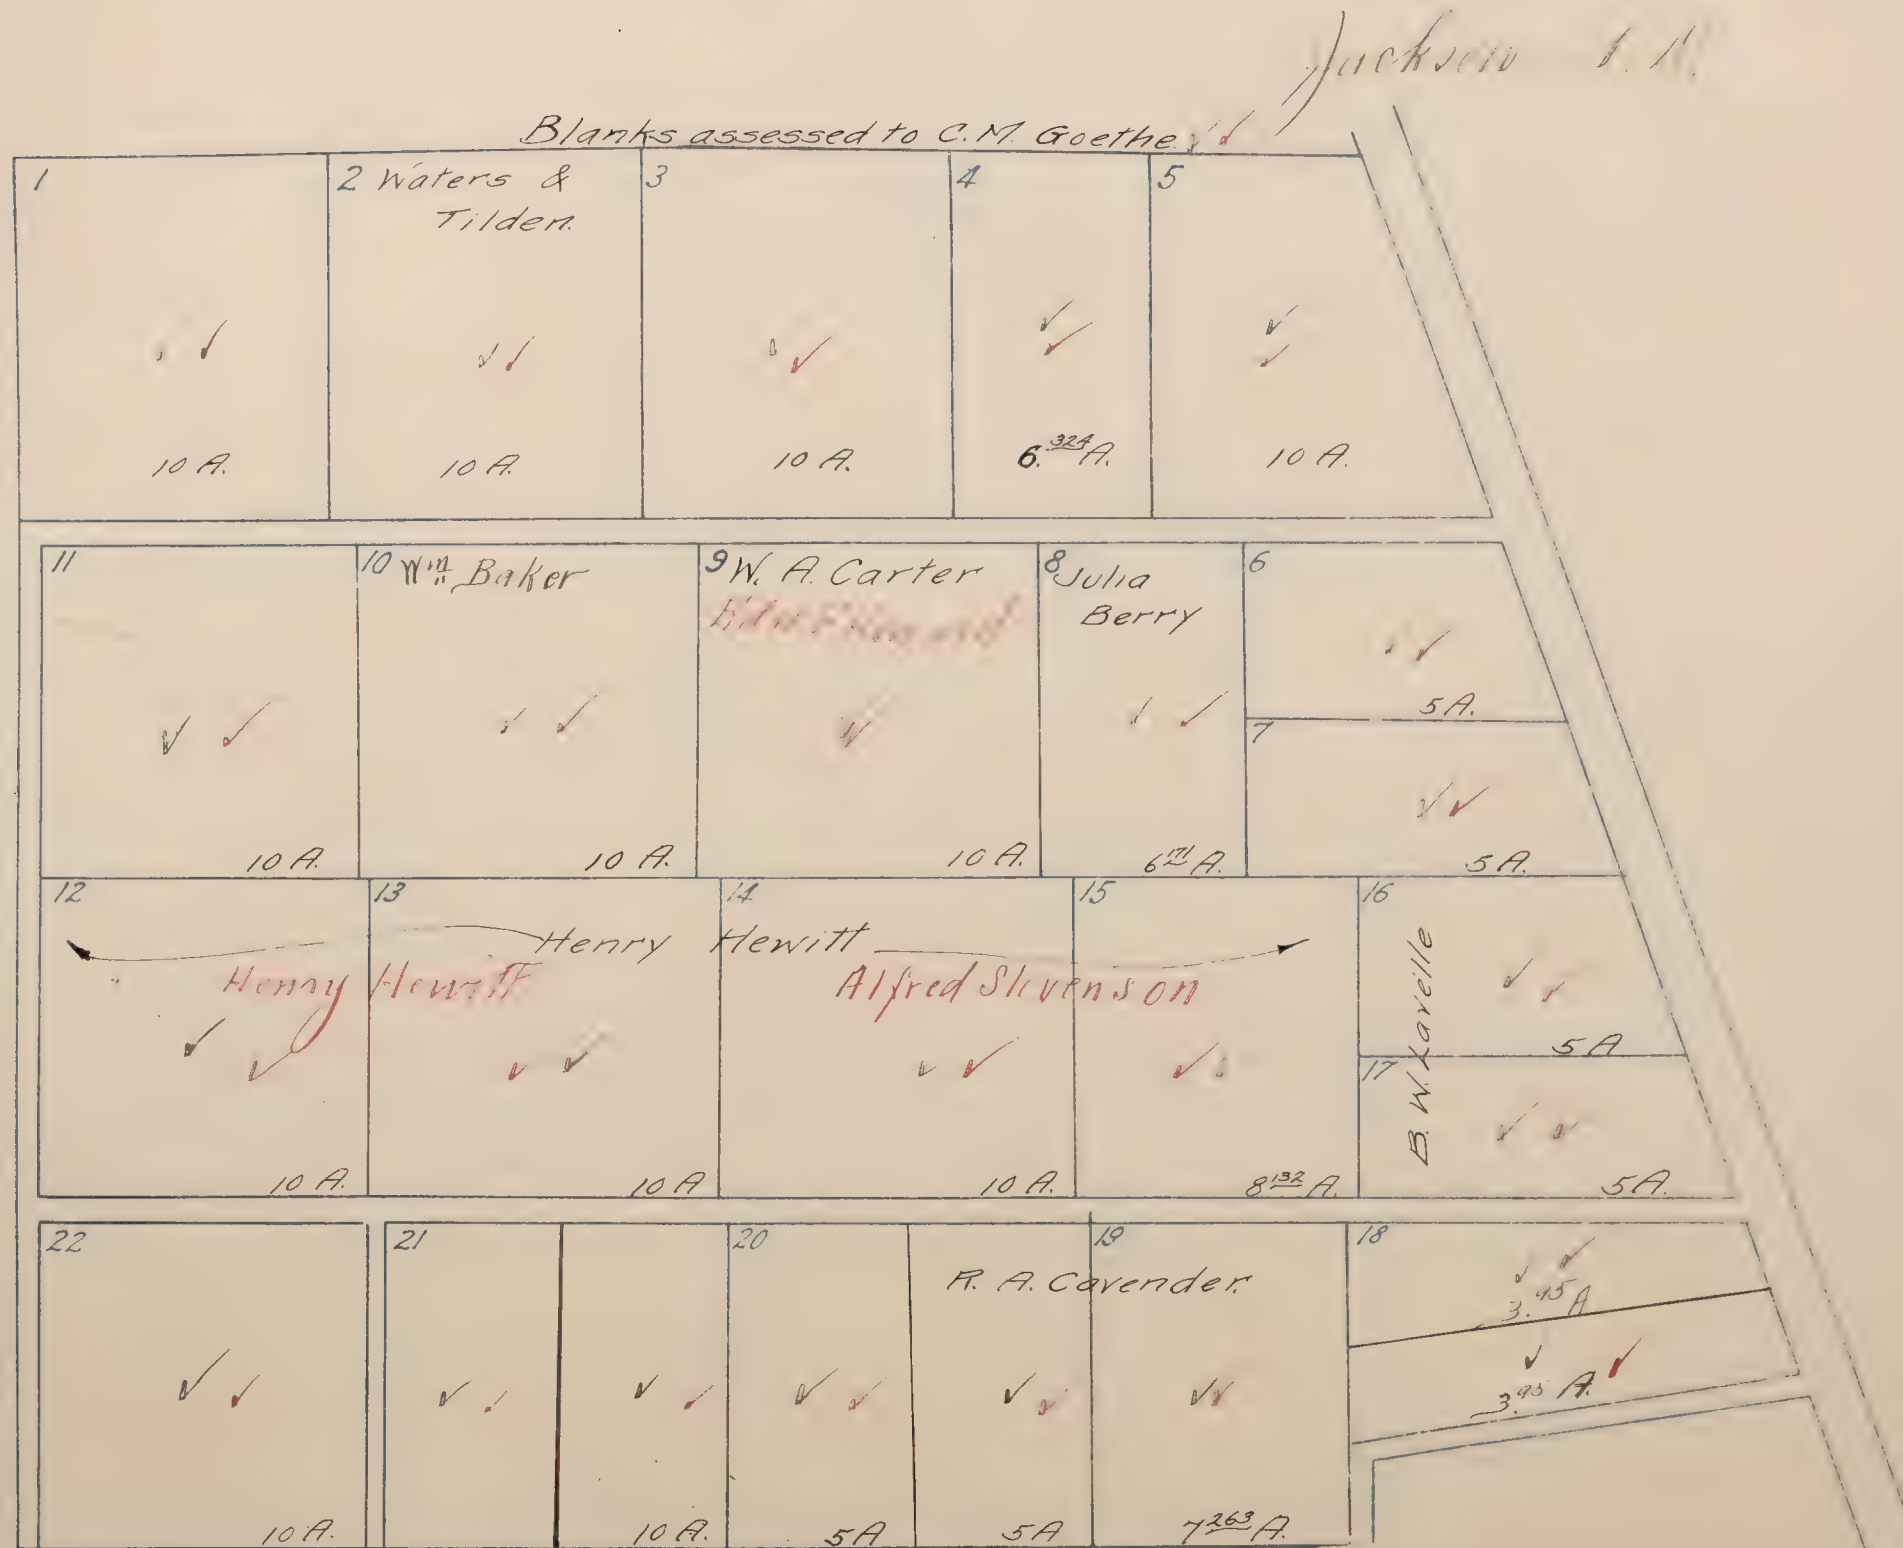

Mapped.

MANLOVE ACRES


located in
N.E. 1/4 Section 13 T8N R5E.
Scale 1"=150ft.

Washington S.D.

Black Ink-1910 Ownership
Red Ink-1920 Ownership

Blanks to Calif. Railroadmen's Realty Co.
FOLSOM
S.P.R.R.

All lots 1 A. unless otherwise noted.

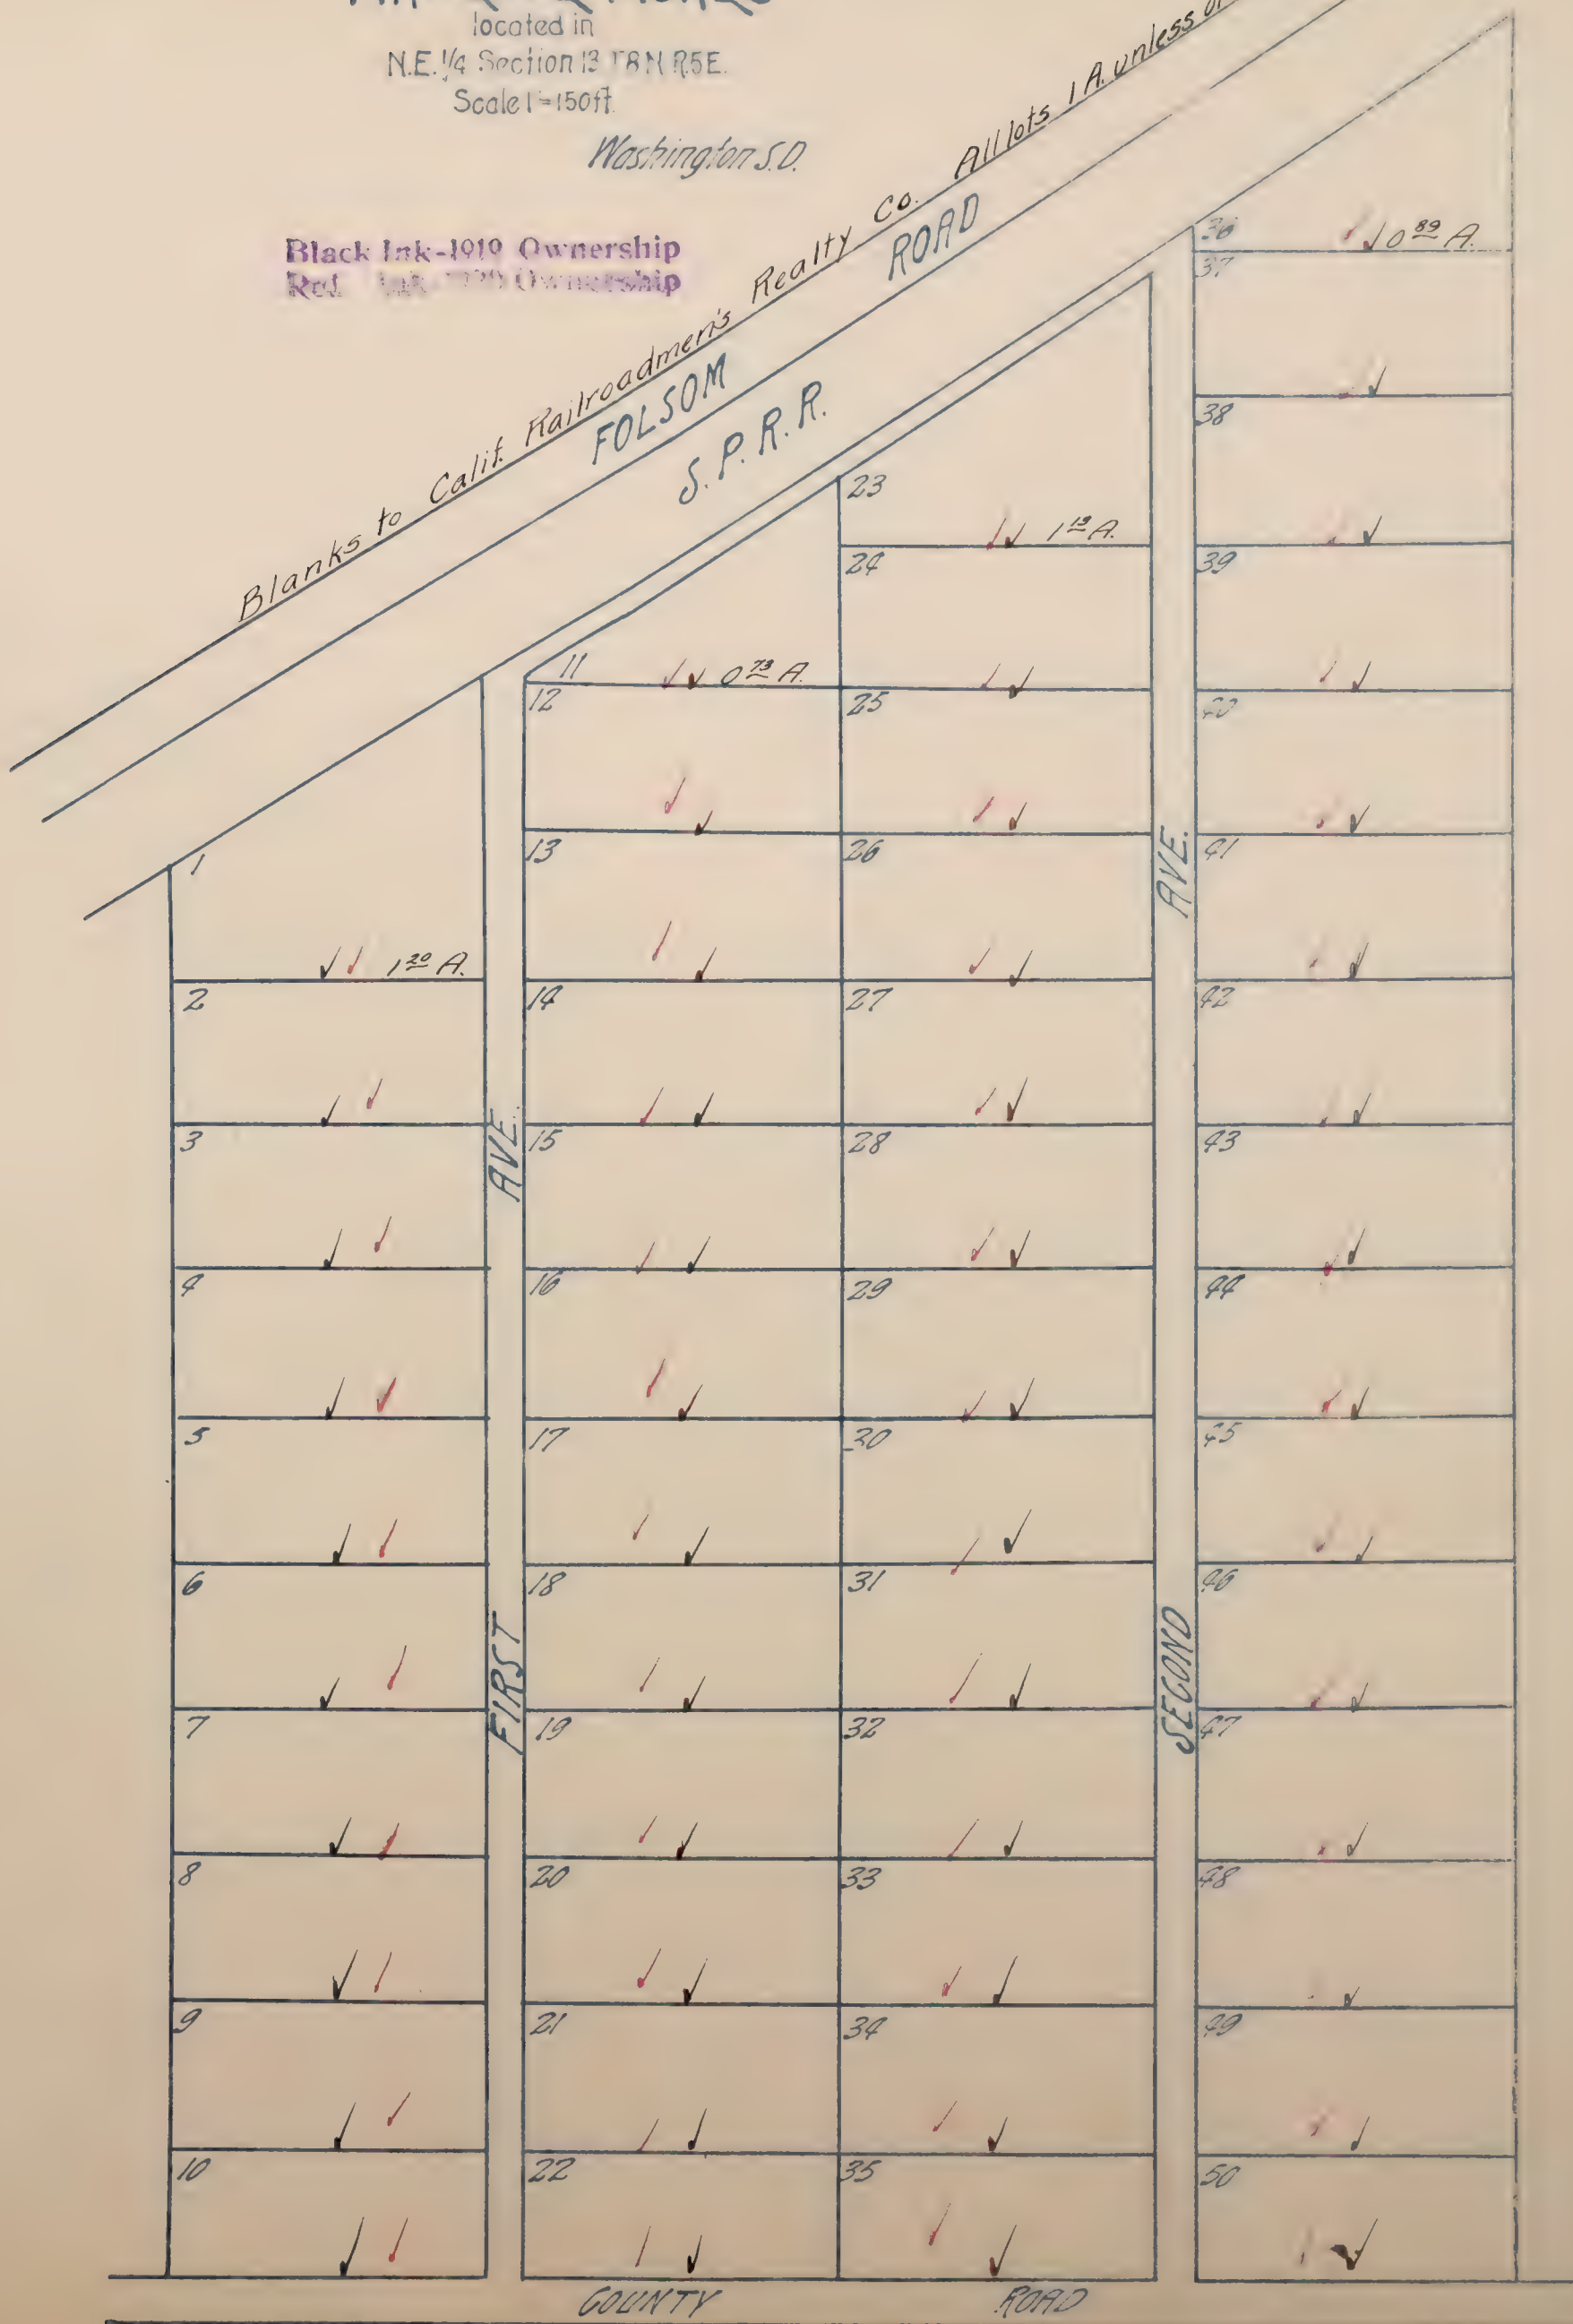

MARYLAND SUBDIVISION

Sec. 12

TO NRC

Scale 300' = 1"

Nov 21

Black Ink-1919 Ownership
Red Ink-1920 Ownership

Blanks assessed to W.T. Foster & A.H. Gostick Lots 1 to 13. ✓
 " " " W.T. Foster & A.H. Gostick 14 to 25. ✓
 Merkley & Sheehan

All Lots 10 Acres unless otherwise noted.



Maryland

PALMETTO AVE


Black Ink-1919 Ownership
Red Ink-1920 Ownership

MAY TRACT

being part of
Lots 10-22 of Louisiana Tract

Scale: 1"=100'

Blanks to W. T. May ✓

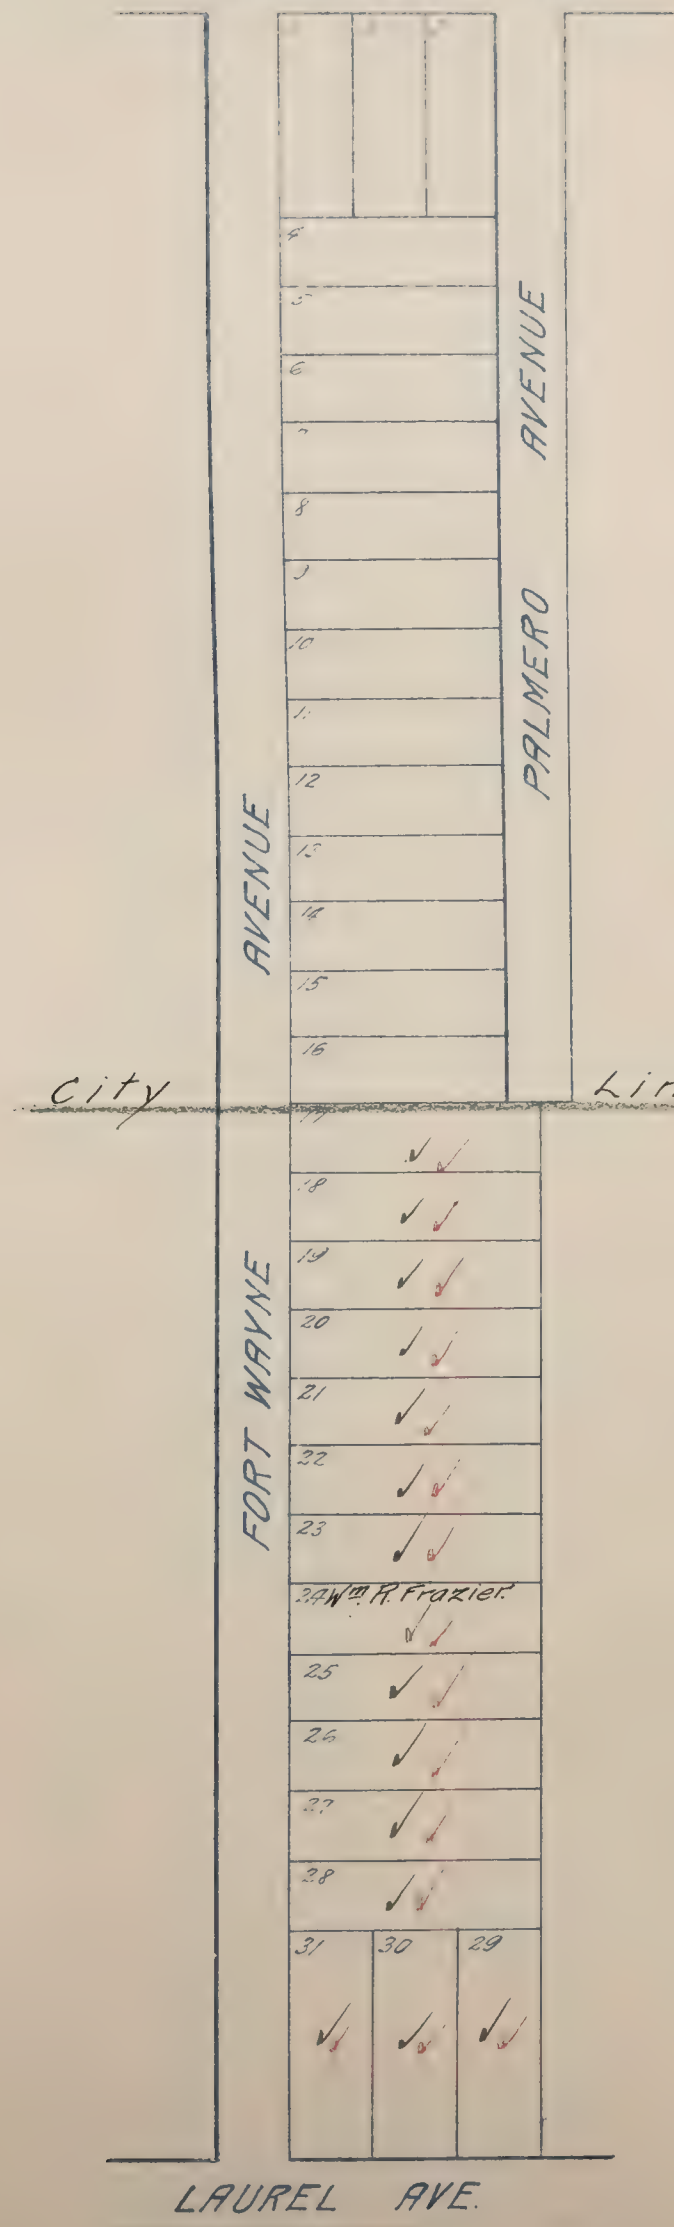

LAUREL AVE

Mapped.

Black Ink-1919 Ownership
Red Ink-1919 Ownership


MEAD TRACT

LOCATED IN
N 1/2 of S.W. 1/4 of Sec. 24, T.8N., R.5E.

Scale: 120' = 1"

Blanks assessed to Frank Mead. ✓✓

Freemont S.D.

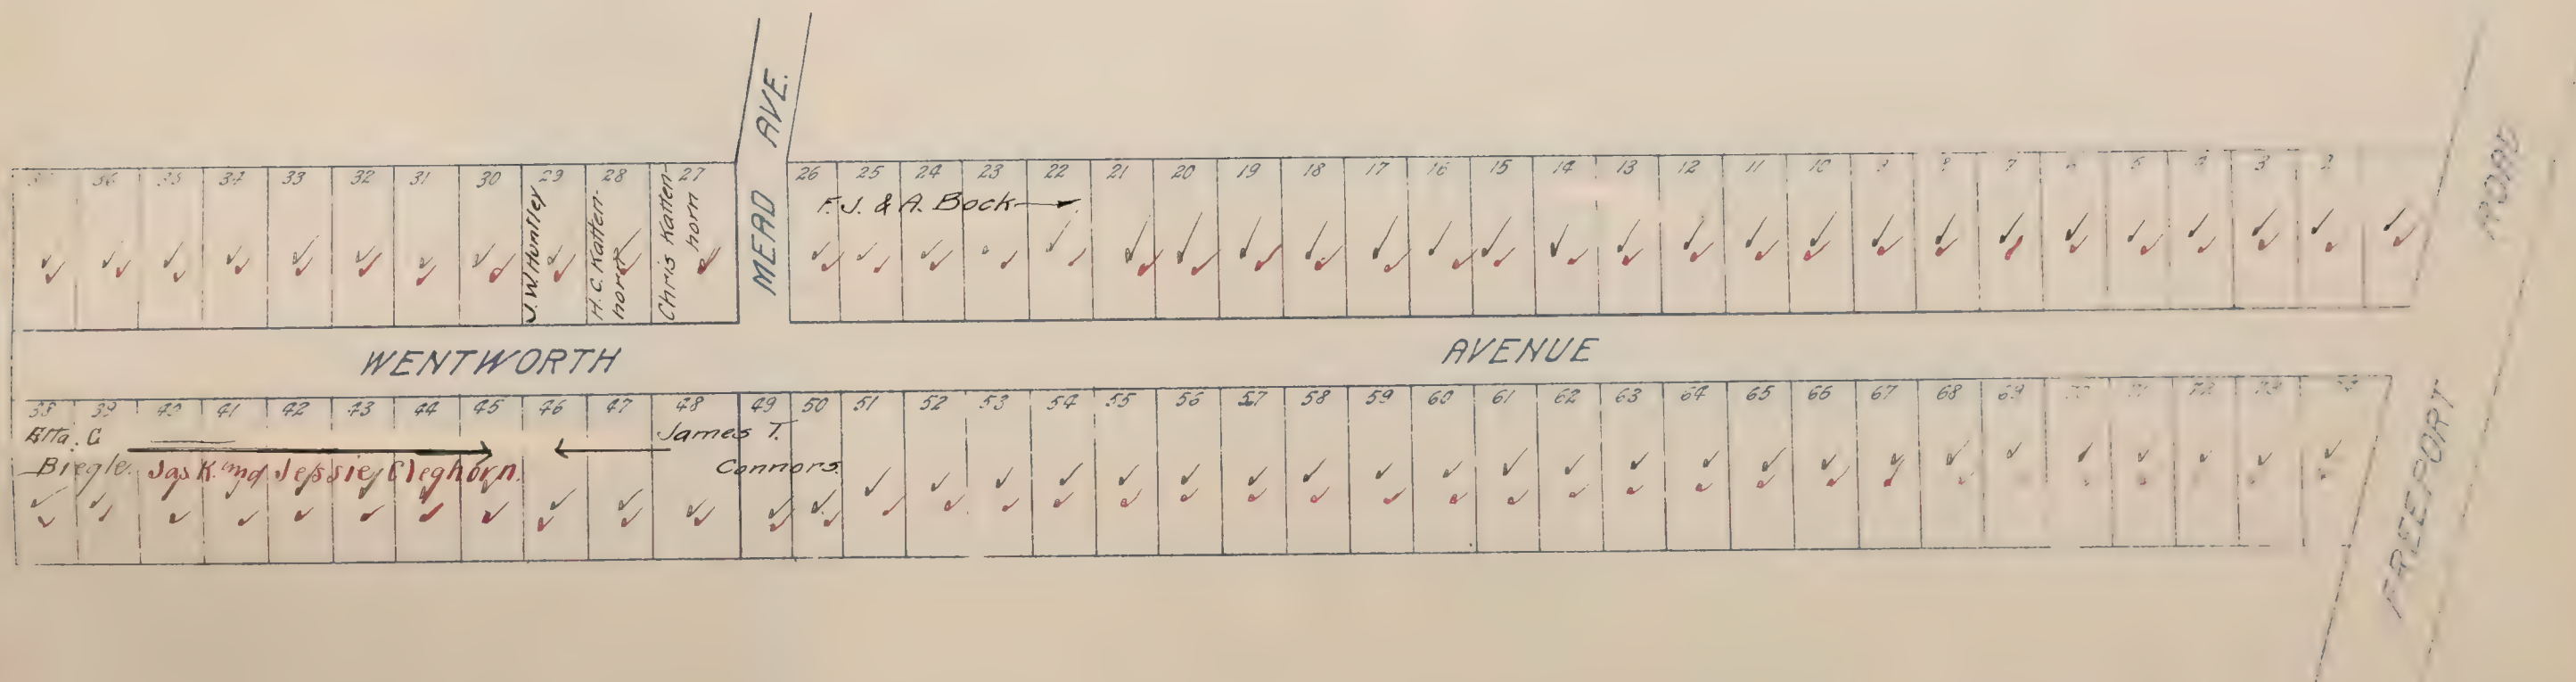

Black Ink - 1910 Ownership
Red Ink - 1920 Ownership

MEAD SUBD. No 2

LOCATED IN
N.W. 1/4 of Sec. 24, T.8N R.4E.
Scale: 1" = 80'

Freemont S.D.
Grant Ridge S.D.

Blanks to Frank Mead

SUTTERVILLE

ROAD

1	✓✓	28	✓✓
2	✓✓	27	✓✓
3	✓✓	26	✓✓
4	✓✓	25	✓✓
5	✓✓	24	✓✓
6	✓✓	23	✓✓
7	✓✓	22	✓✓
8	✓✓	21	✓✓
9	✓✓	20	✓✓
10	✓✓	19	✓✓
11	✓✓	18	✓✓
12	✓✓	17	✓✓
13	✓✓	16	✓✓
14	✓✓	15	✓✓

COURT
MARION

AB. H. Simpson

Mapped.


MEADOW VIEW COLONY

LOCATED IN
SECTIONS 7 & 8 T11N R1E
SCALE 60' = 1"

FIGURE 10

Blanks assessed to J. J. Sheehan and F. O'Brien Jr. Trs. ✓✓

Black Ink-1919 Ownership
Red Ink-1920 Ownership

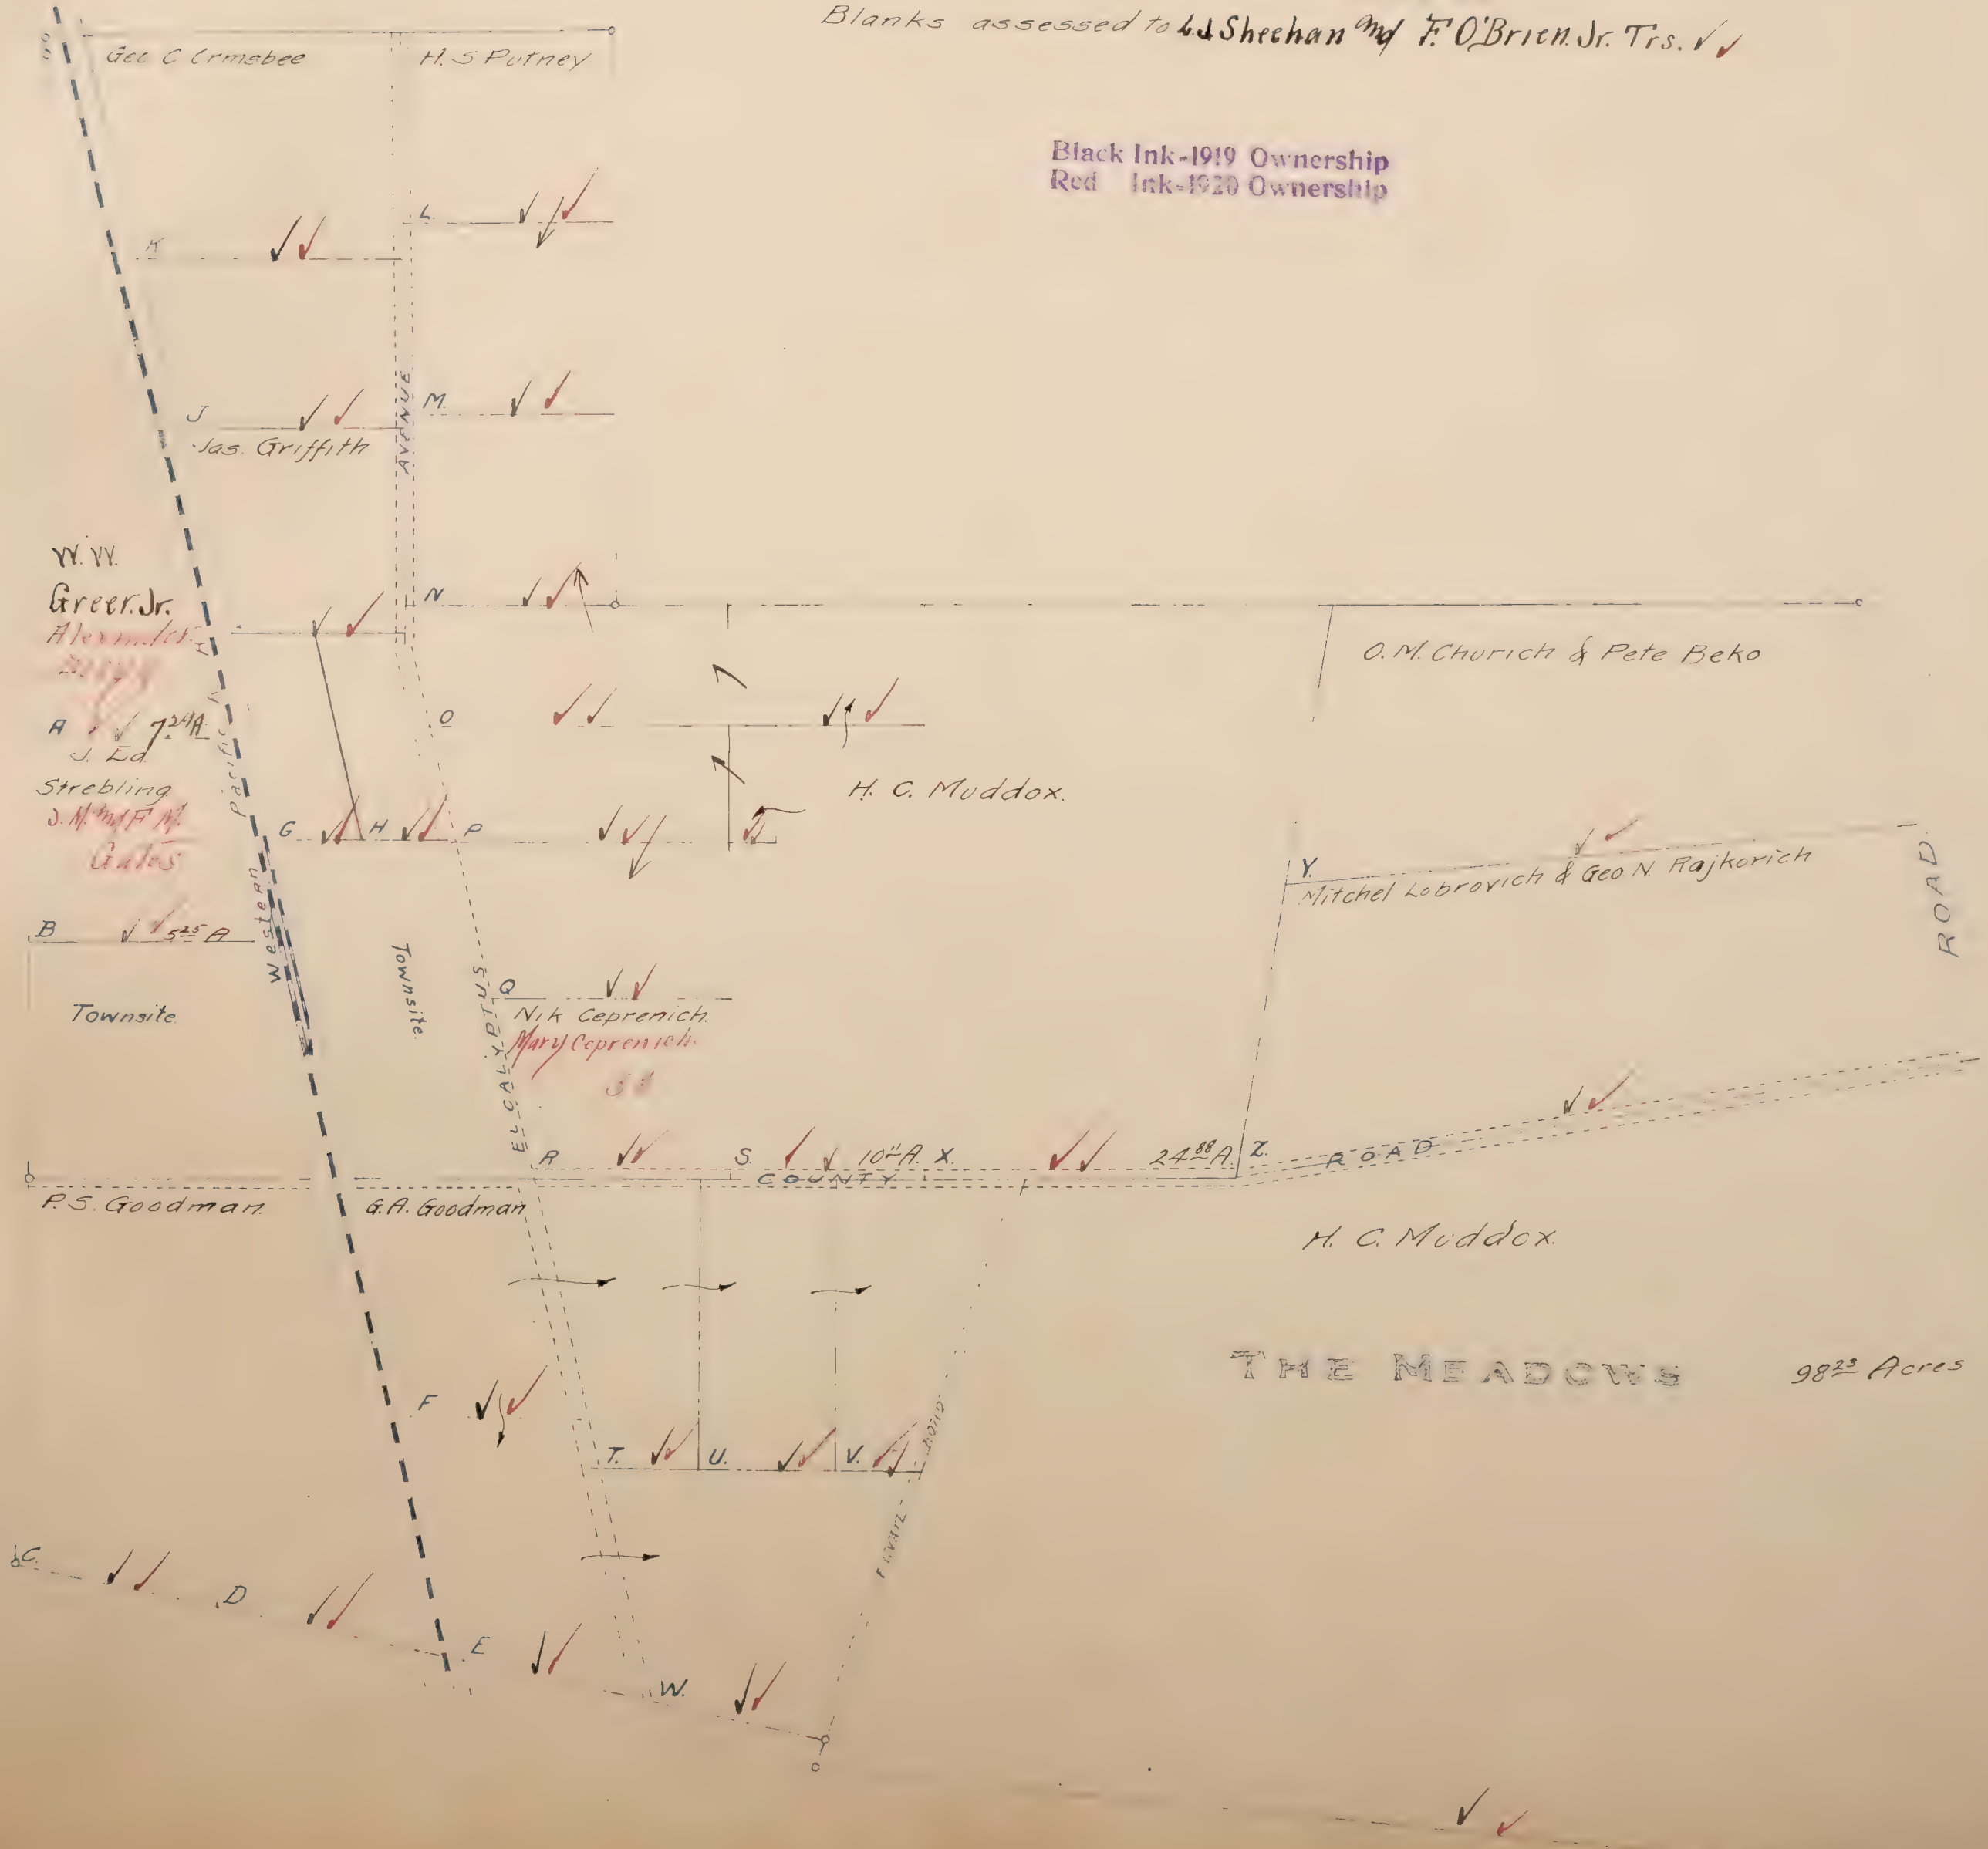


Mapped.

MEADOW VIEW COLONY

Black Ink-1919 Ownership
Red Ink-1920 Ownership

Blanks to L.J. Sheehan and F.J. O'Brien Jr. Trs. ✓

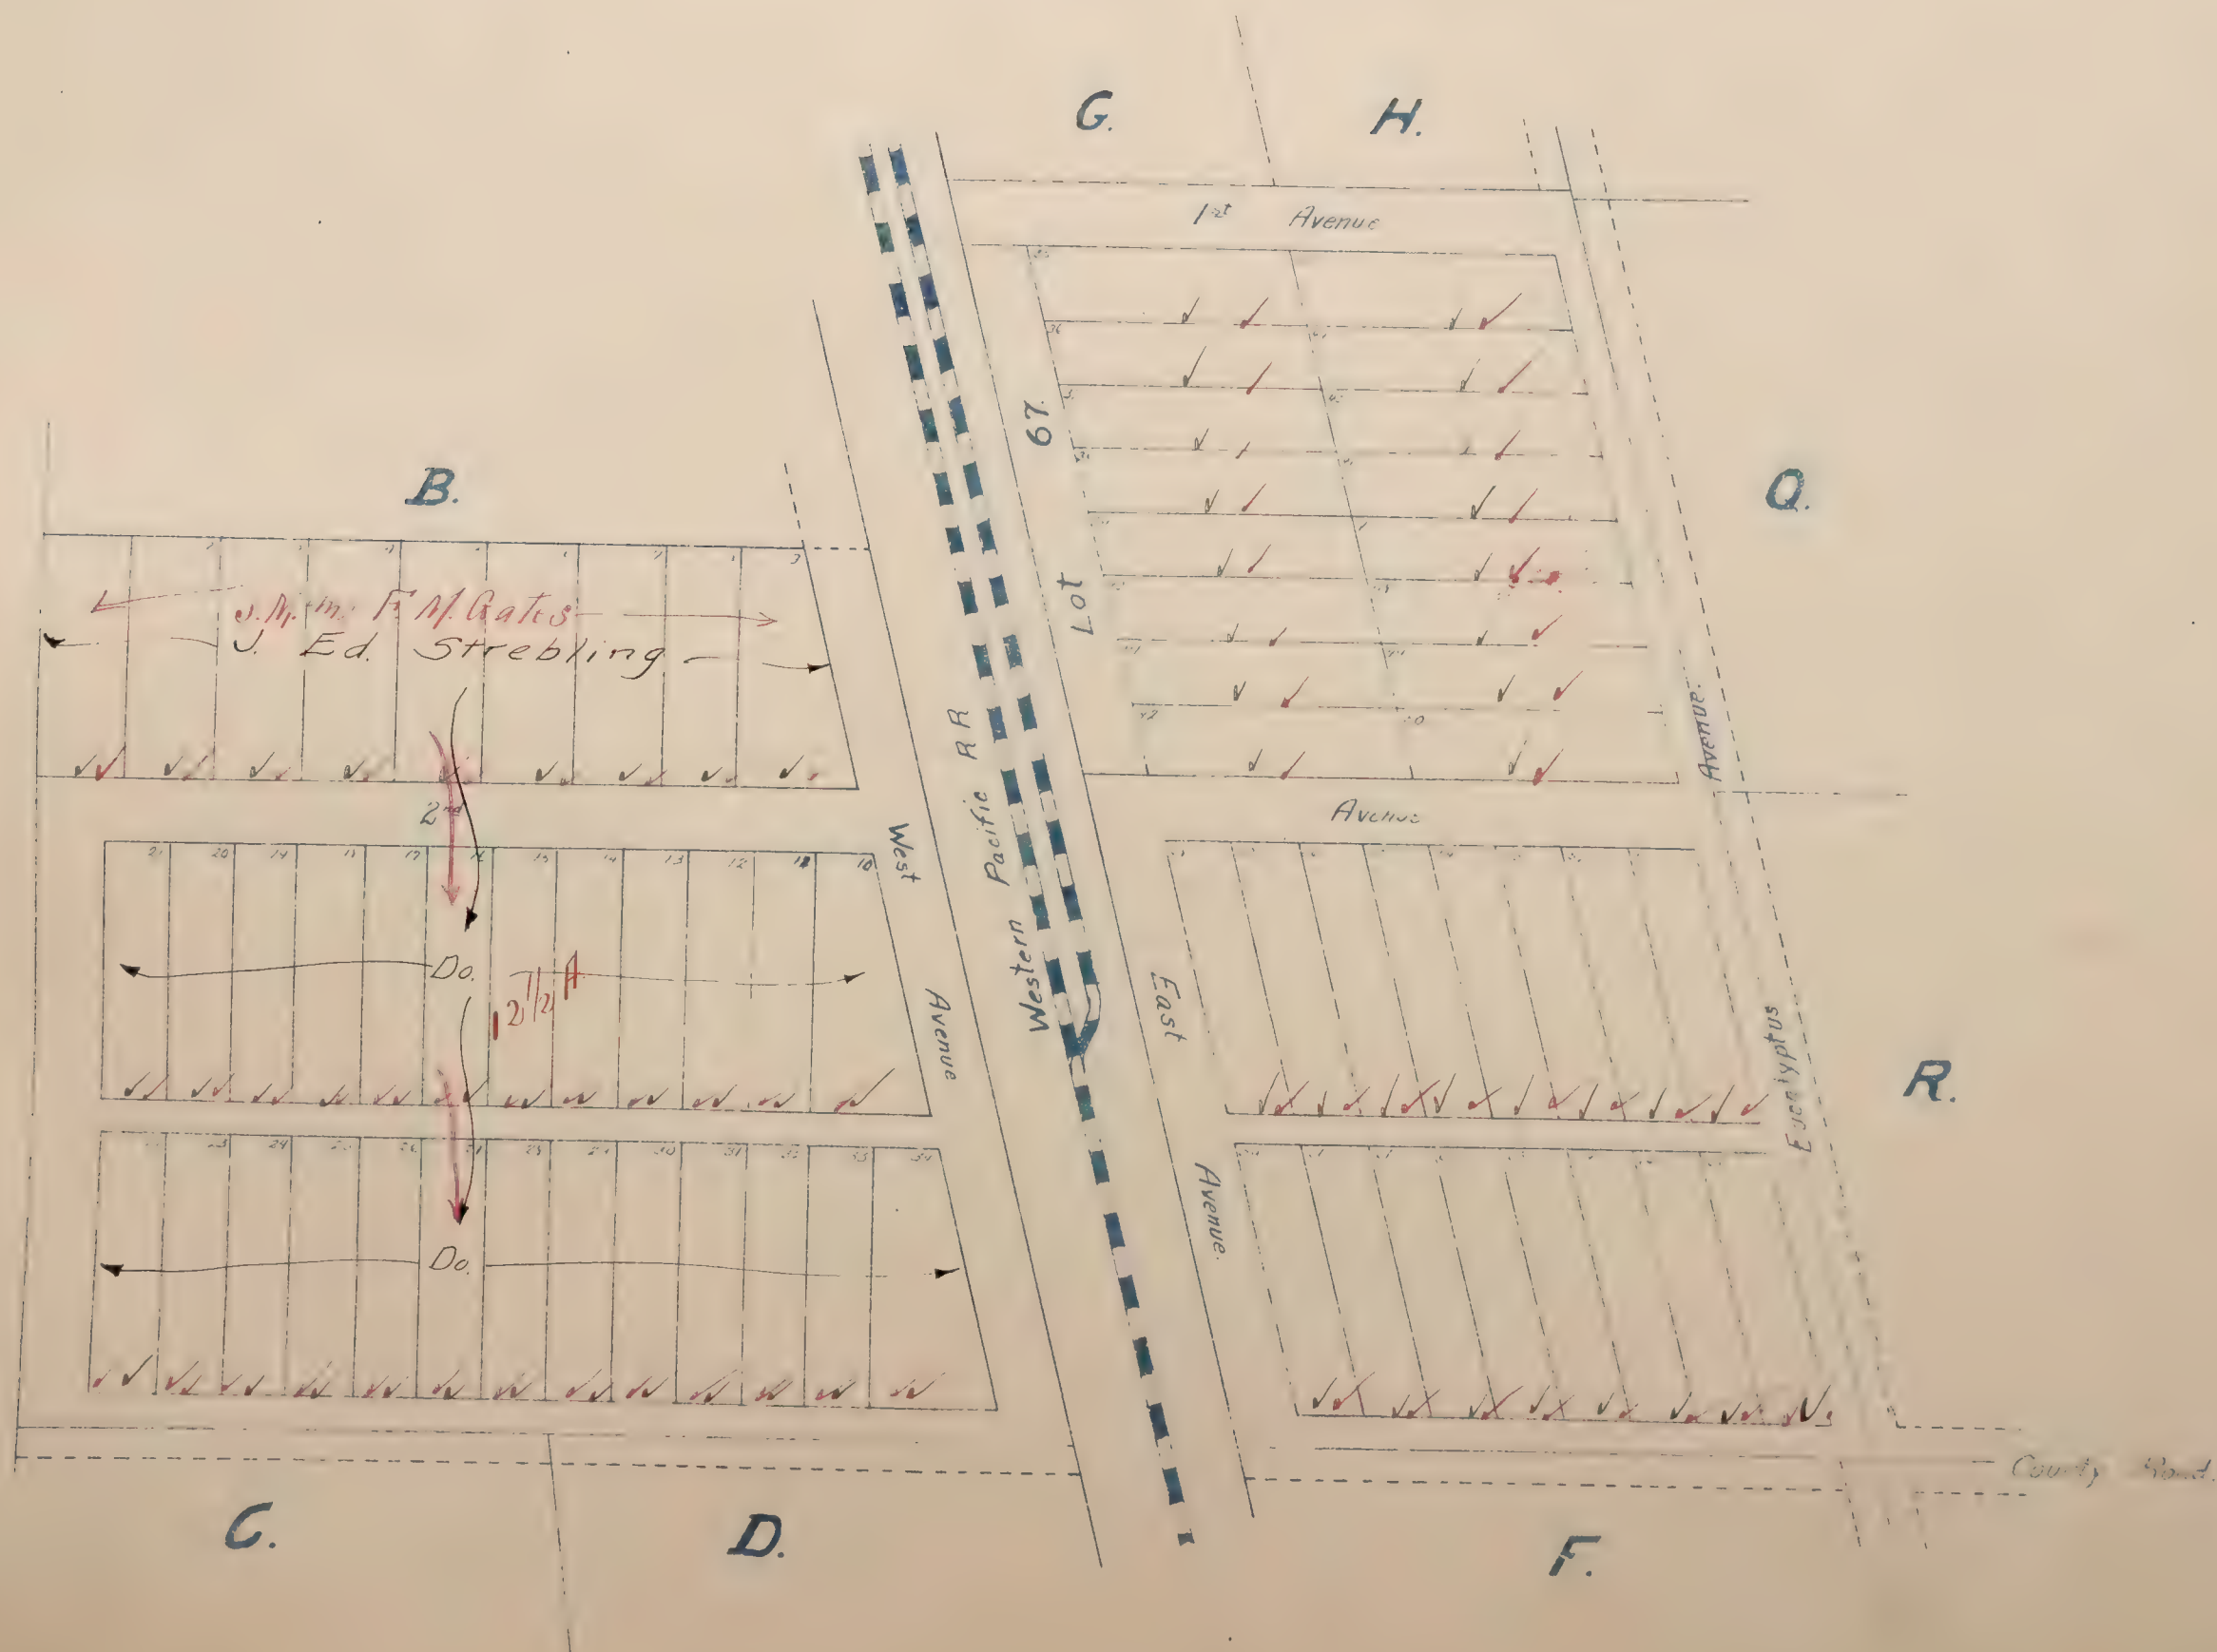

Black Ink - 1979 Ownership
Red Ink - 1980 Ownership

MIRA VISTA

N.W. 1/4 Section 15, T.8 N. R. 5 E. Lots #2 + 3 of
Davis Tract.

Junction S.D.

REDDING AVENUE

BRIGHTON TOWNSEITE.

Black Ink-1910 Ownership
Red Ink-1910 Ownership

MOULTON TRACT

LOCATED IN THE
N.E. 1/4 of Sec. 36, T.8N., R.4E.

Scale: 3 Chs. = 1"

Pacific S.D.

Blanks assessed to D. H. Moulton ✓

1 Edwin V. Hartzell	22 Wm McCall	23
✓ ✓ 2 ⁵⁰ A.	✓ ✓ 2 ⁵⁰ A.	✓ ✓ 2 ⁵⁰ A.
2 Victor Scudera	21	24
✓ ✓ 2 A.	✓ ✓	✓ ✓
✓ ✓ 1/2 A.	20	25
3	✓ ✓	✓ ✓
✓ ✓	19	26
4	✓ ✓	✓ ✓
✓ ✓	18	27
5	✓ ✓	✓ ✓
✓ ✓	17	28
6	✓ ✓	✓ ✓
✓ ✓	16	29
7	✓ ✓	✓ ✓
✓ ✓	15	30
8	✓ ✓	✓ ✓
✓ ✓	14	31
9	✓ ✓	✓ ✓
✓ ✓	13	32
10	✓ ✓	✓ ✓
✓ ✓	12	33
11	✓ ✓	✓ ✓
✓ ✓	✓ ✓	✓ ✓

PRIVATE LANE

EDDIE STREET

24TH STREET

CORDOVA ROAD


MC CARTY'S EAST SACRAMENTO FIVE ACRE TRACTS

BEING

THE $5\frac{1}{2}$ OF THE SW $\frac{1}{4}$ OF SEC. 14 - T8N R5E. M.D.B. & M.

SCALE: 1 IN. = 200 FT.

All Blanks to H. C. McCarty

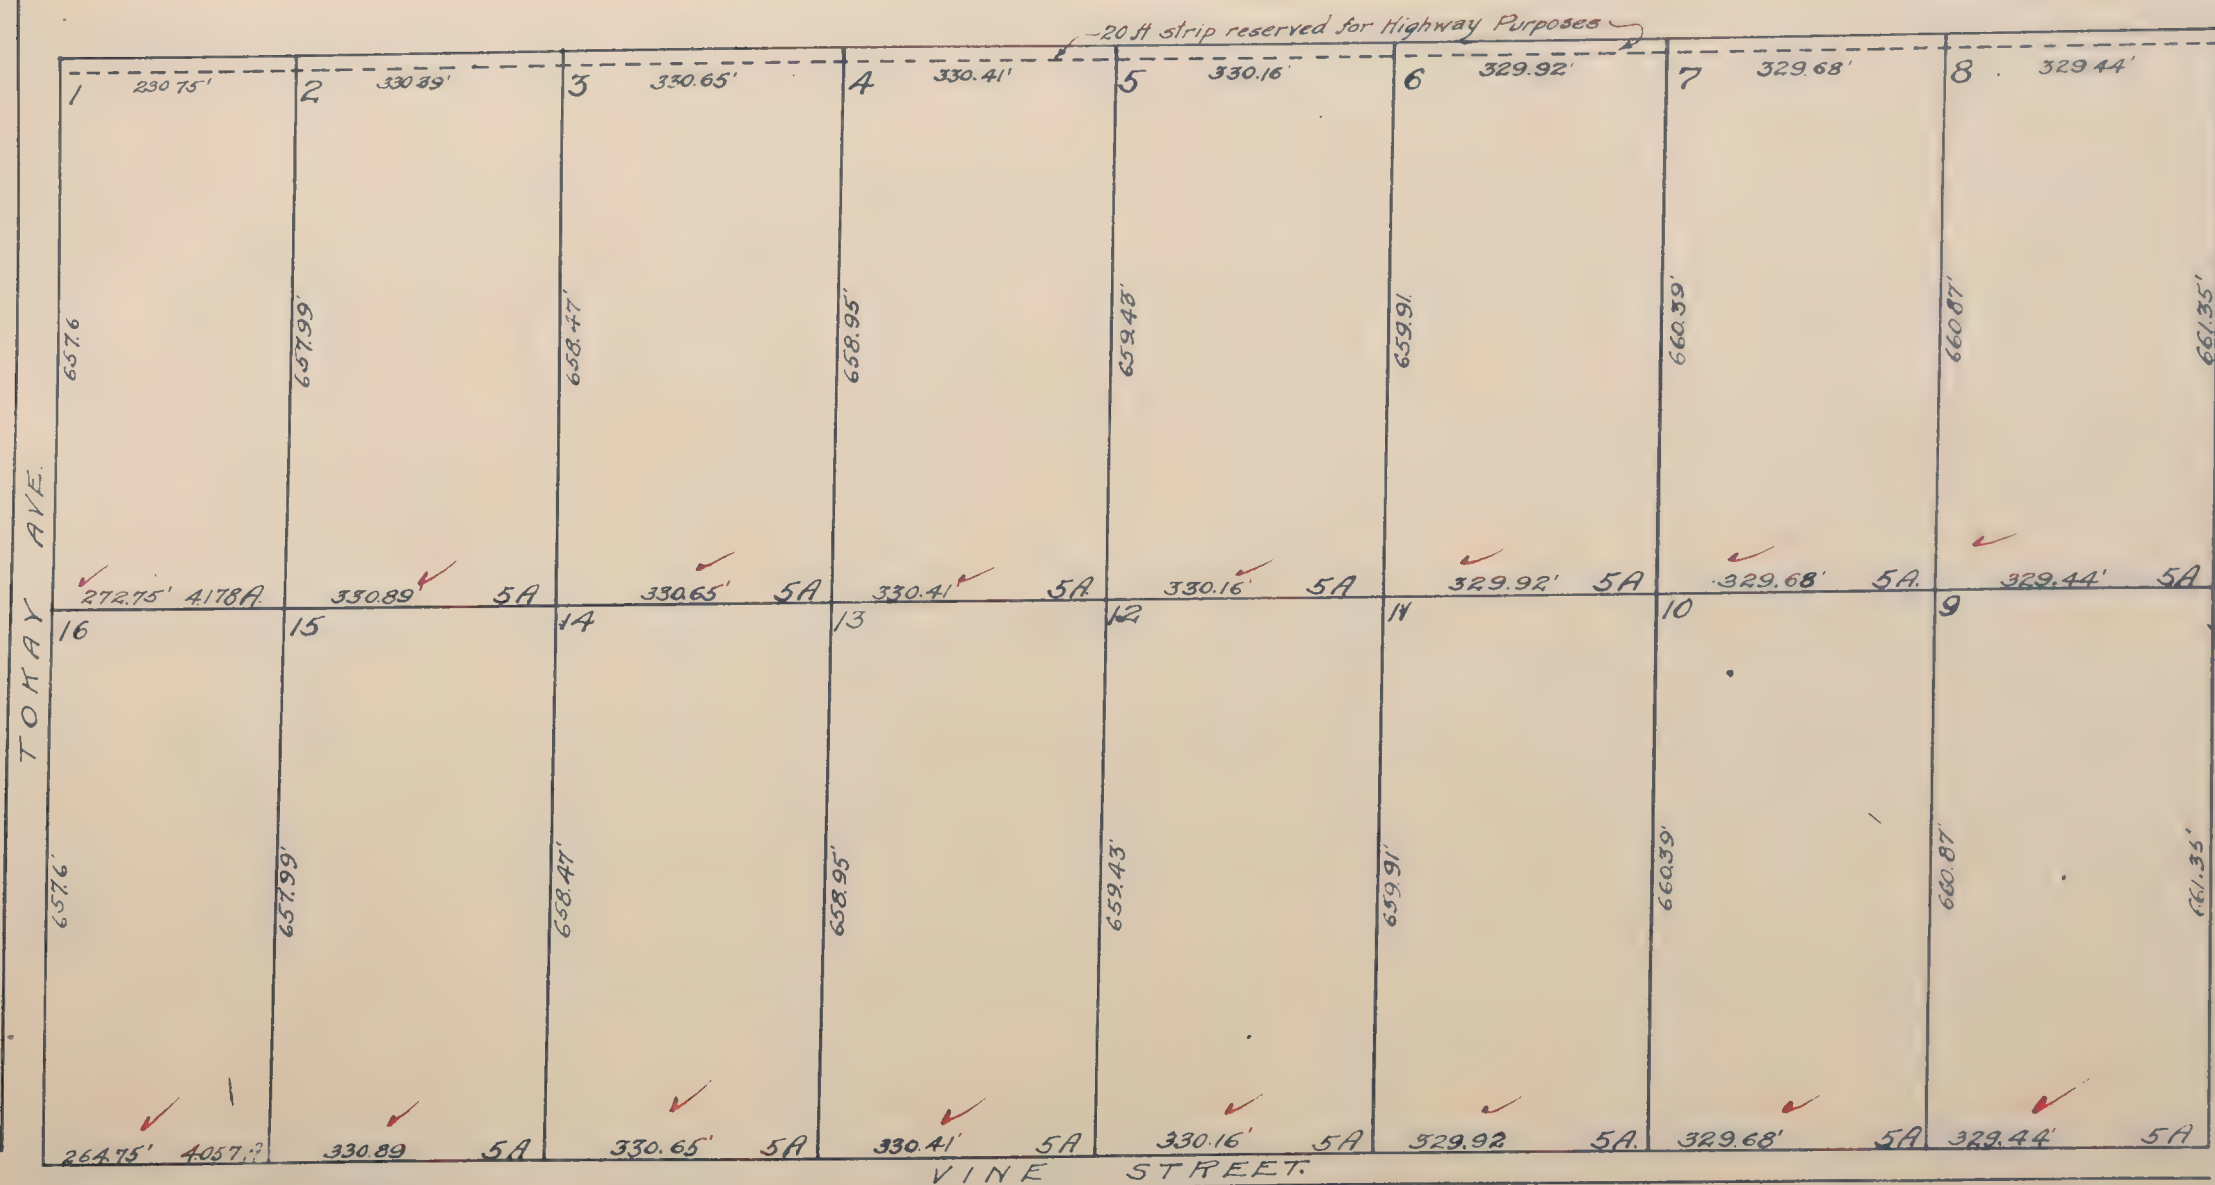

McCAULEY ADD'N TO GALT


LOCATED IN
W. 1/2 of Sec. 26, T.5N., R.6E.

Black Ink-1910 Ownership
Red Ink-1920 Ownership

Scale: 6chs. = 1"

Blanks assessed to G. M. Steele and F. C. Carey

All Lots 5 Acres unless otherwise noted

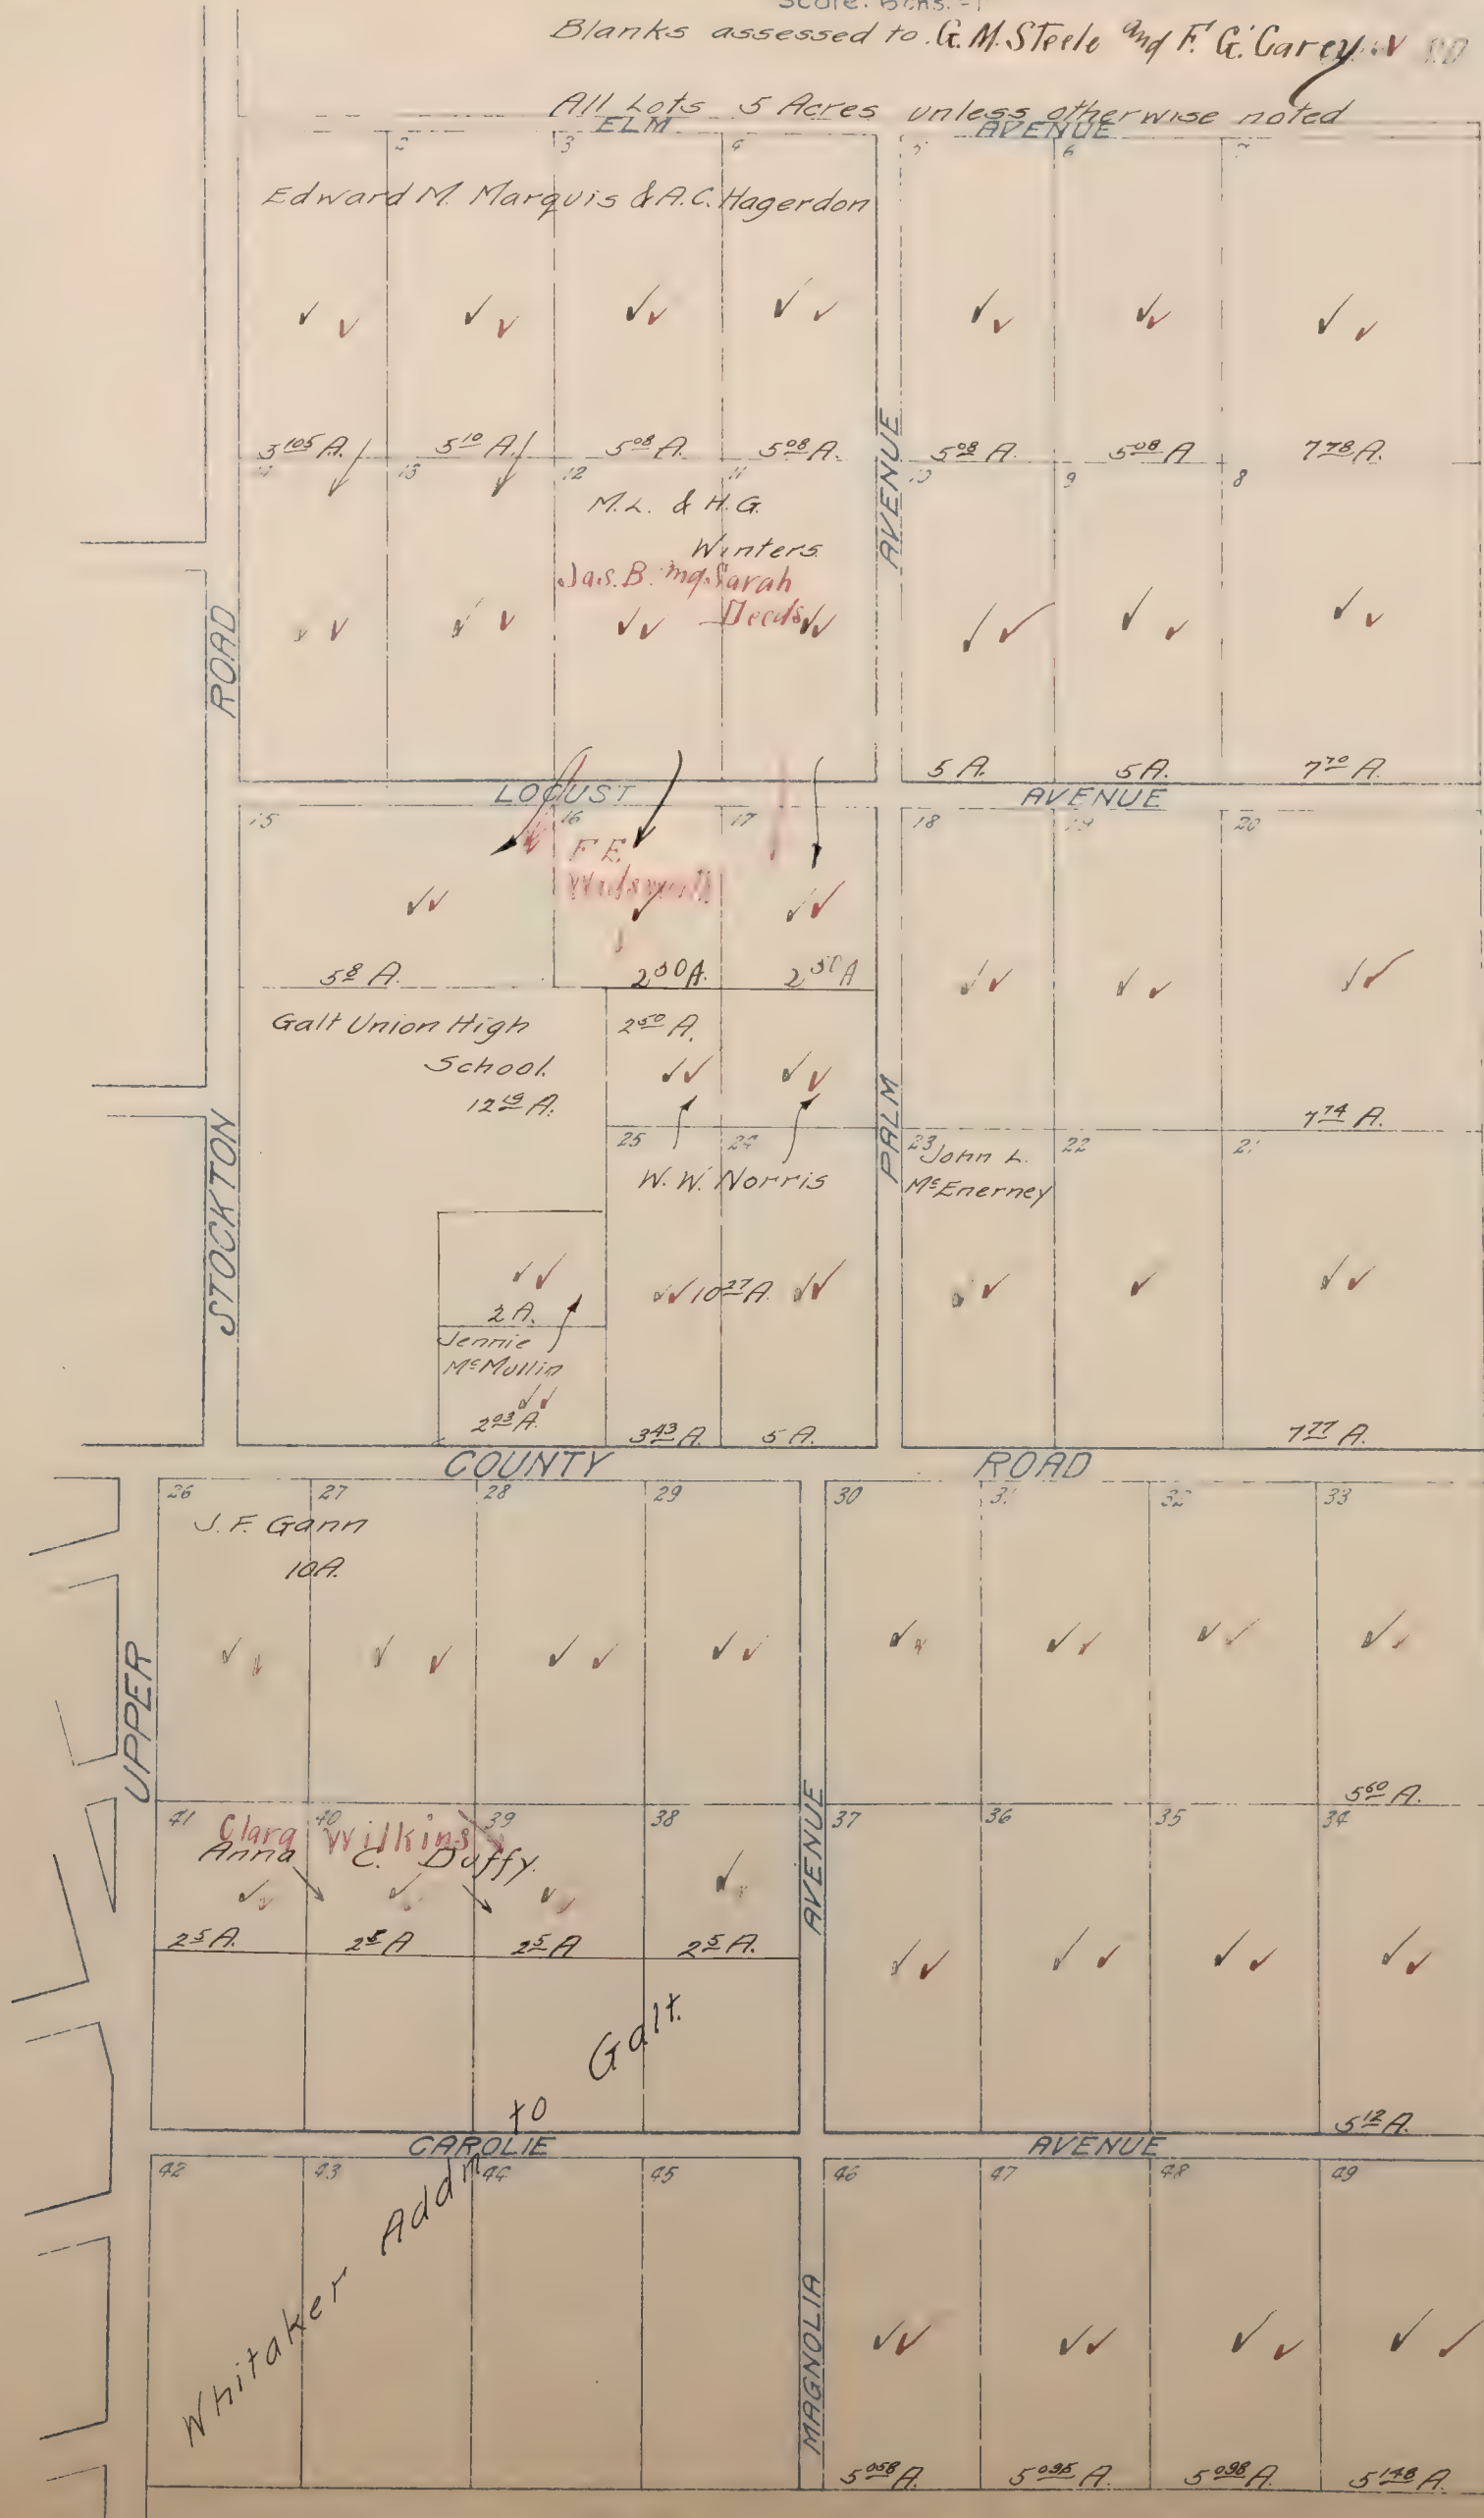

G A L T

UPPER

Whitaker Addn

Galt

MAGNOLIA

AVENUE

ROAD

COUNTY

J. F. Gann
10A.

Clara Wilkins
Anna C. Duffy

CAROLIE

MAGNOLIA

AVENUE

ROAD

COUNTY

J. F. Gann
10A.

Clara Wilkins
Anna C. Duffy

CAROLIE

MAGNOLIA

AVENUE

ROAD

COUNTY

J. F. Gann
10A.

Clara Wilkins
Anna C. Duffy

CAROLIE

MAGNOLIA

AVENUE

ROAD

COUNTY

J. F. Gann
10A.

Clara Wilkins
Anna C. Duffy

CAROLIE

MAGNOLIA

AVENUE

ROAD

COUNTY

J. F. Gann
10A.

Clara Wilkins
Anna C. Duffy

CAROLIE

MAGNOLIA

AVENUE


ROAD

COUNTY

NATOMAS COMPANY OF CALIFORNIA
 MAP OF
 NATOMAS GOODLAND SUBDIVISION
 IN section 10-T10N R4E. M.Q.N.

Scale 1 Inch = 600 Feet.

Blanks to
 NATOMAS COMPANY OF CALIFORNIA ✓

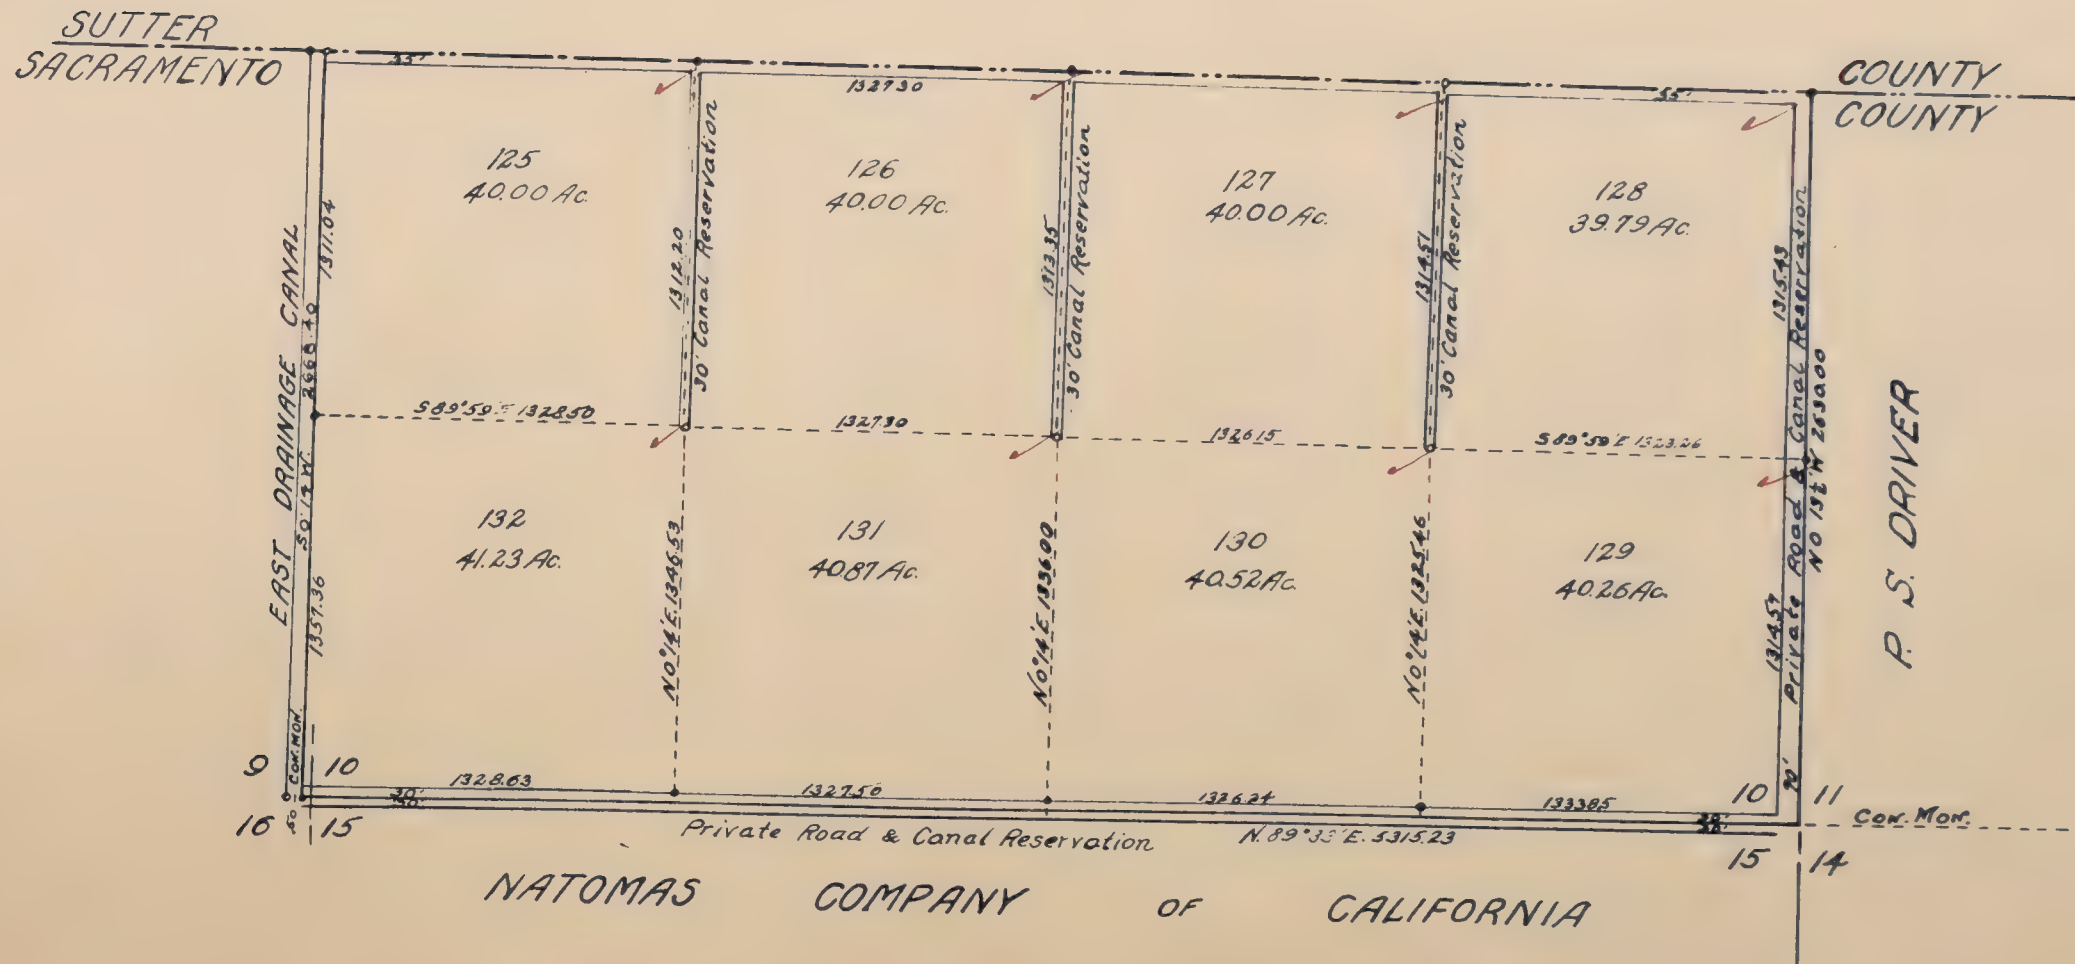

NATOMA SUBDIVISION

Scale 8 chains = 1 mile

Black Ink - 1910 Ownership
Red Ink - 1920 Ownership

Granite S.D.

Blanks assessed to Natomas Con. of Calif. in Acreage.



Natomas Sub.

NATOMAS RIVERSIDE SUBD. NO. 3.

Located in Secs 4, 5, 6, 7, 8, 9, 15, 16, 17 - T9N R4E & Sec 12 - T9N R3E.

Sacramento County - California


Scale 1 inch = 600 ft

Blanks to Natomas Co. of Calif. v

NATOMAS ELKHORN SUBDIVISION

American Basin I.M.

Black Ink - 1919 Ownership
Red Ink - 1920 Ownership

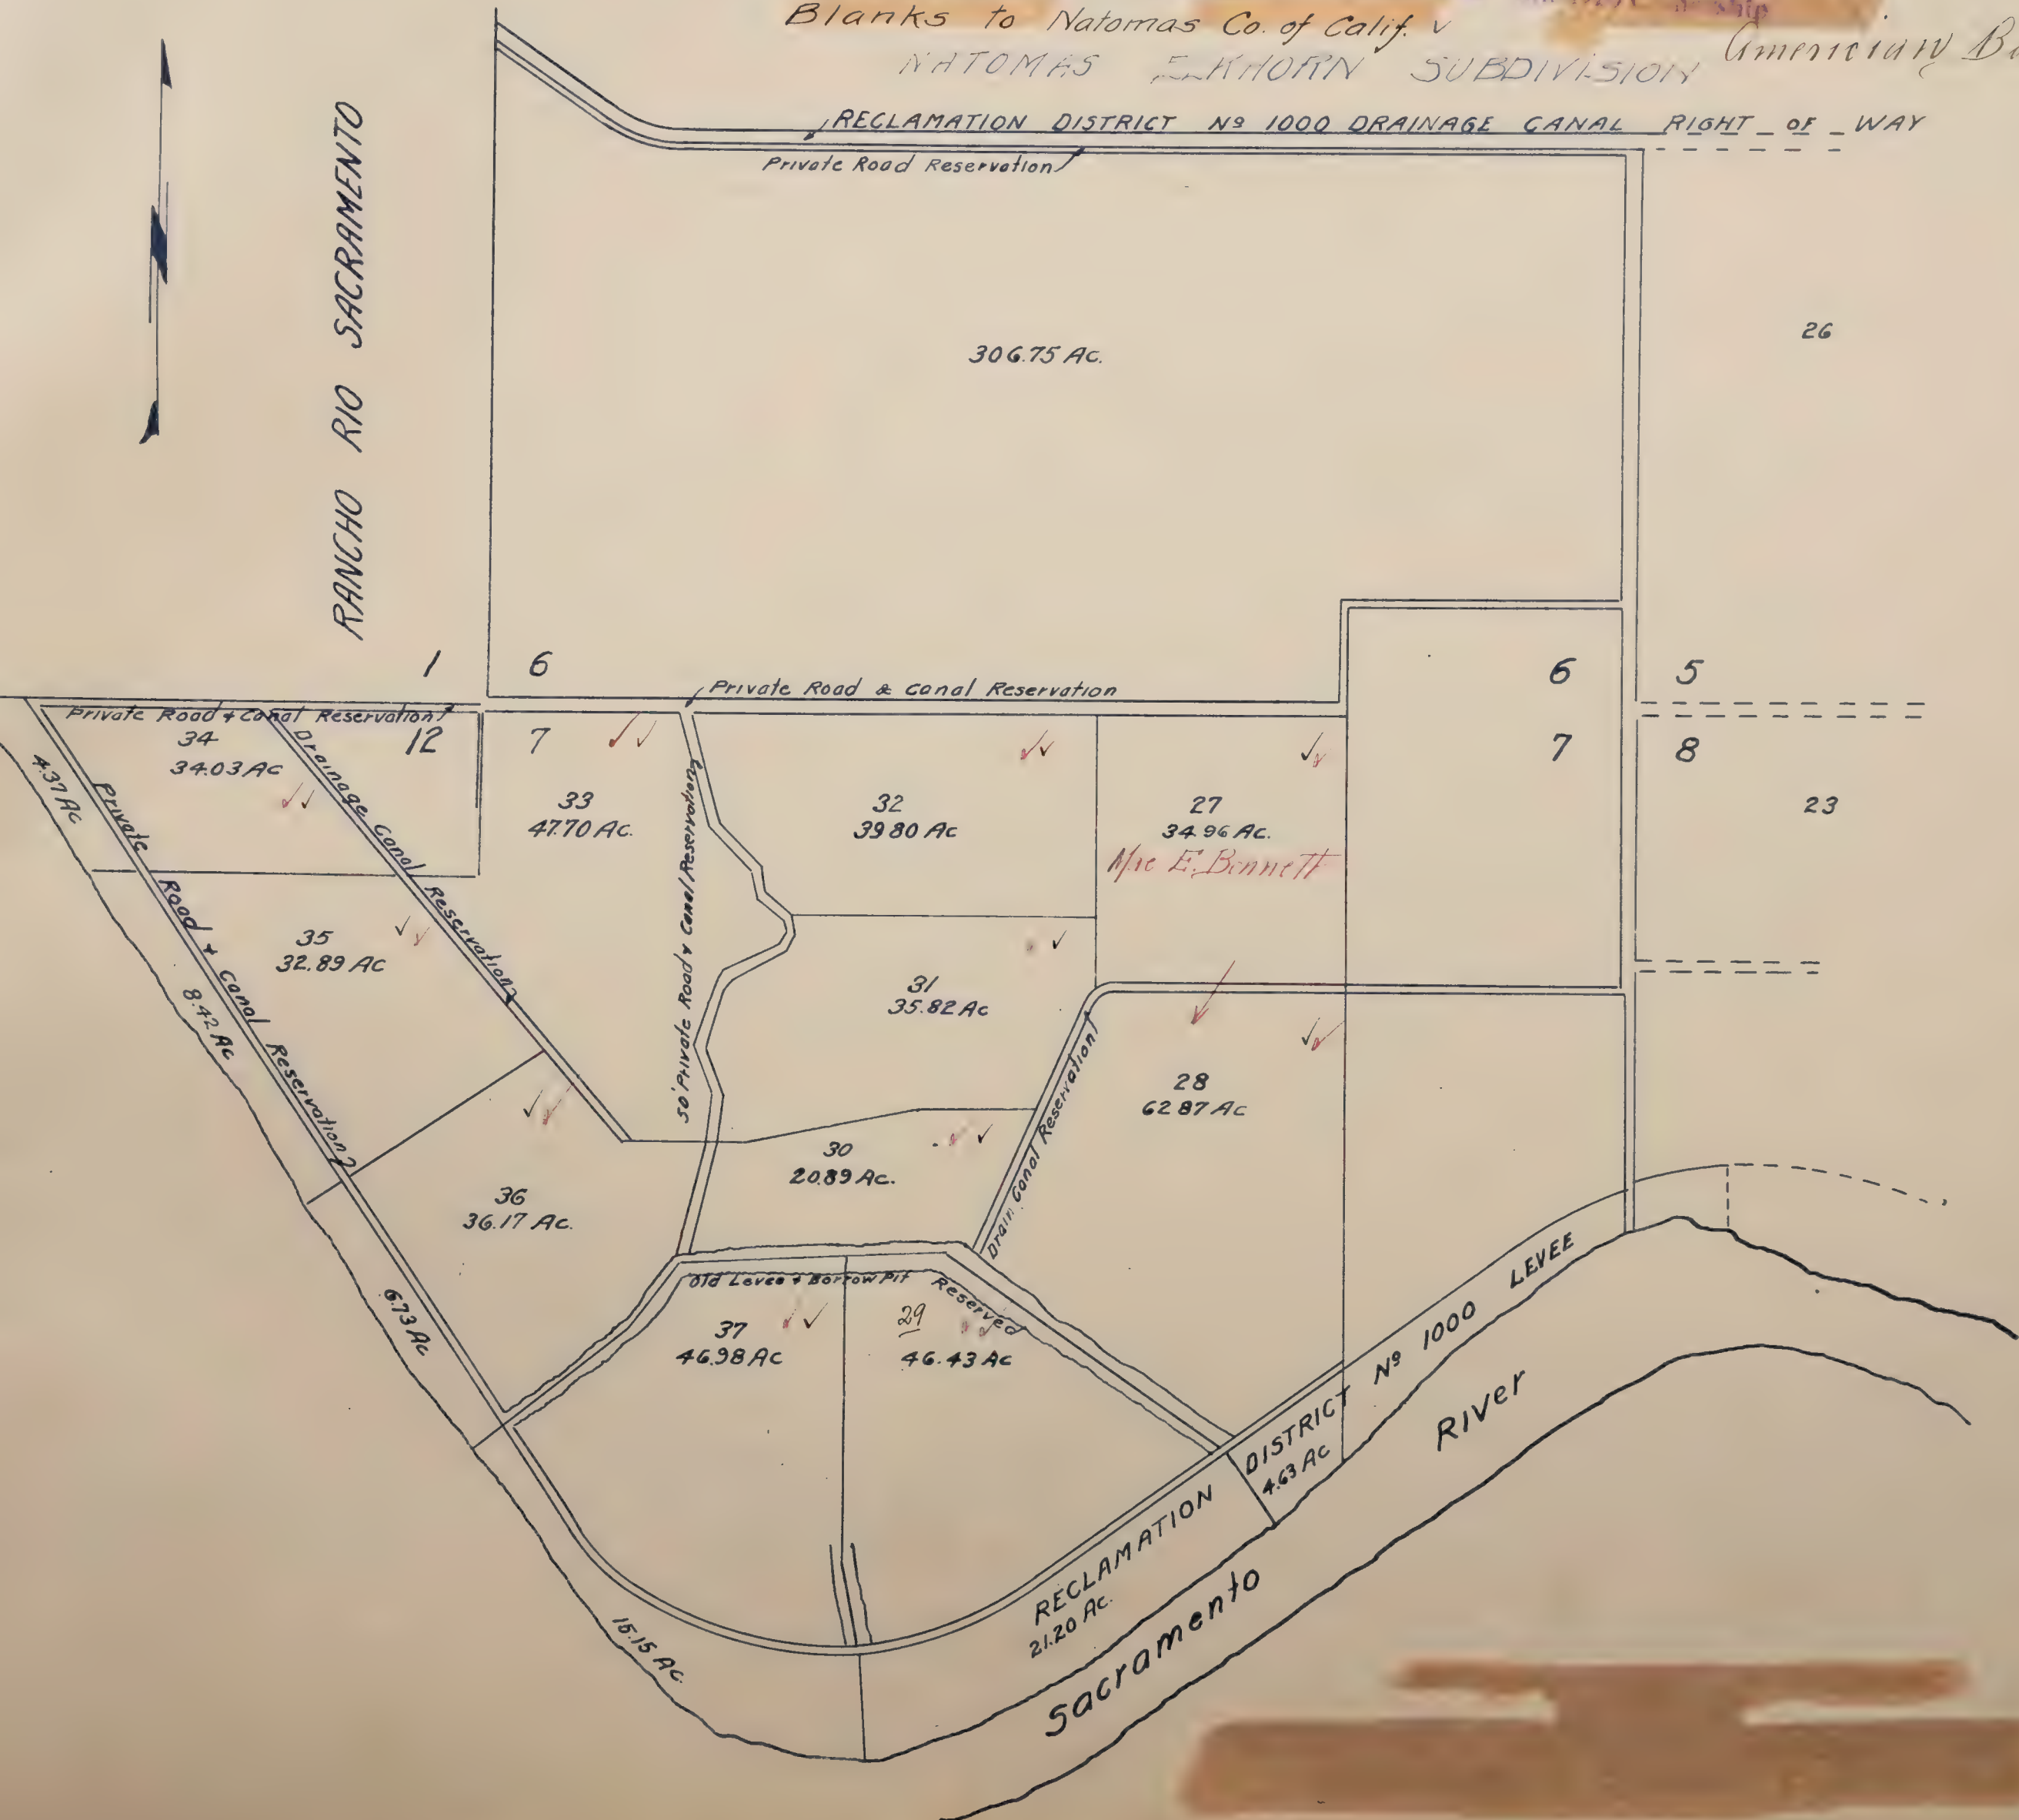

NATOMAS RIVERSIDE SUBD. NO. 3.

Mapped.

Located in Secs 4, 5, 6, 7, 8, 9, 15, 16, 17, ~T9N R4E & Sec. 12-T9N R3E.

Sacramento County - California.

Scale 1 inch = 600 ft.


Black Ink-1919 Ownership
Red Ink-1920 Ownership

Blanks to Natomas Co of Calif. ✓

NATOMAS ELKHORN SUBDIVISION
RECLAMATION DISTRICT No 1000 DRAINAGE CANAL RIGHT OF WAY



Jefferson 1.2

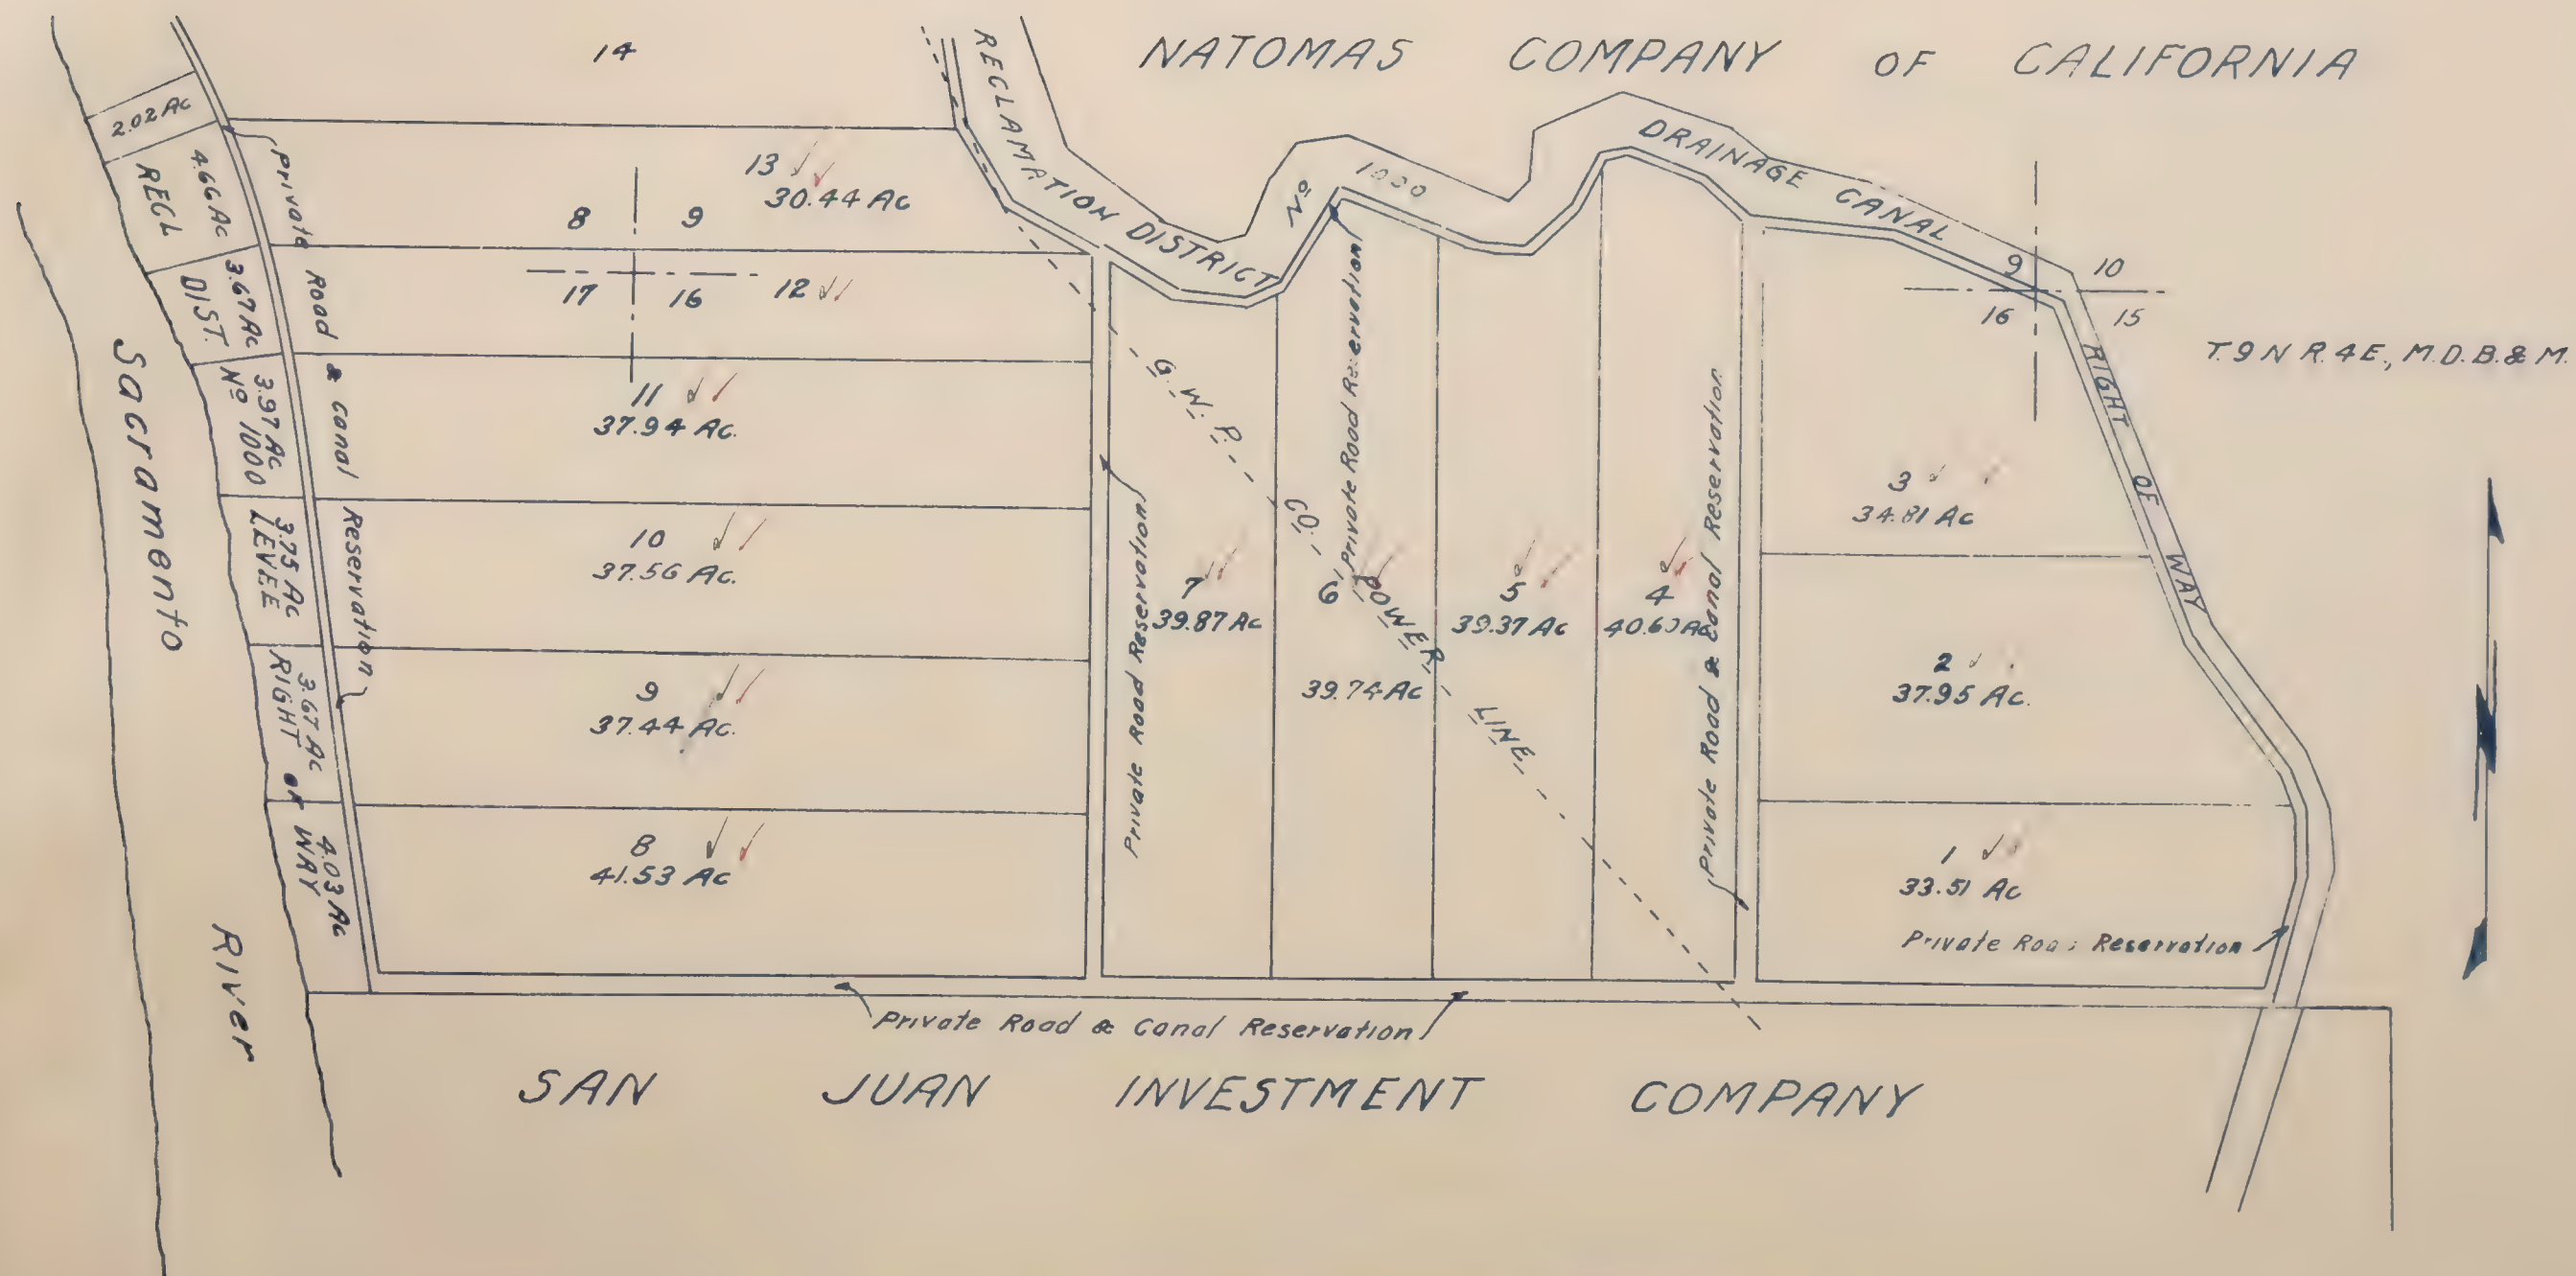

SHEET N^o 1


NATOMAS COMPANY OF CALIFORNIA
AMENDED MAP OF
NATOMAS AMERICAN RIVER
SUBDIVISION N^o 4
BEING A PORTION OF NATOMAS CONSOLIDATED
OF CALIFORNIA PARCEL N^o 7, IN THE RANCHO
RIO DE LOS AMERICANOS, SACRAMENTO CO. CAL.

Scale 1 inch = 400 feet.

Black Ink-1919 Ownership
Red Ink-1928 Ownership

MILLS STATION

Blanks to Natomas Co. of Calif.

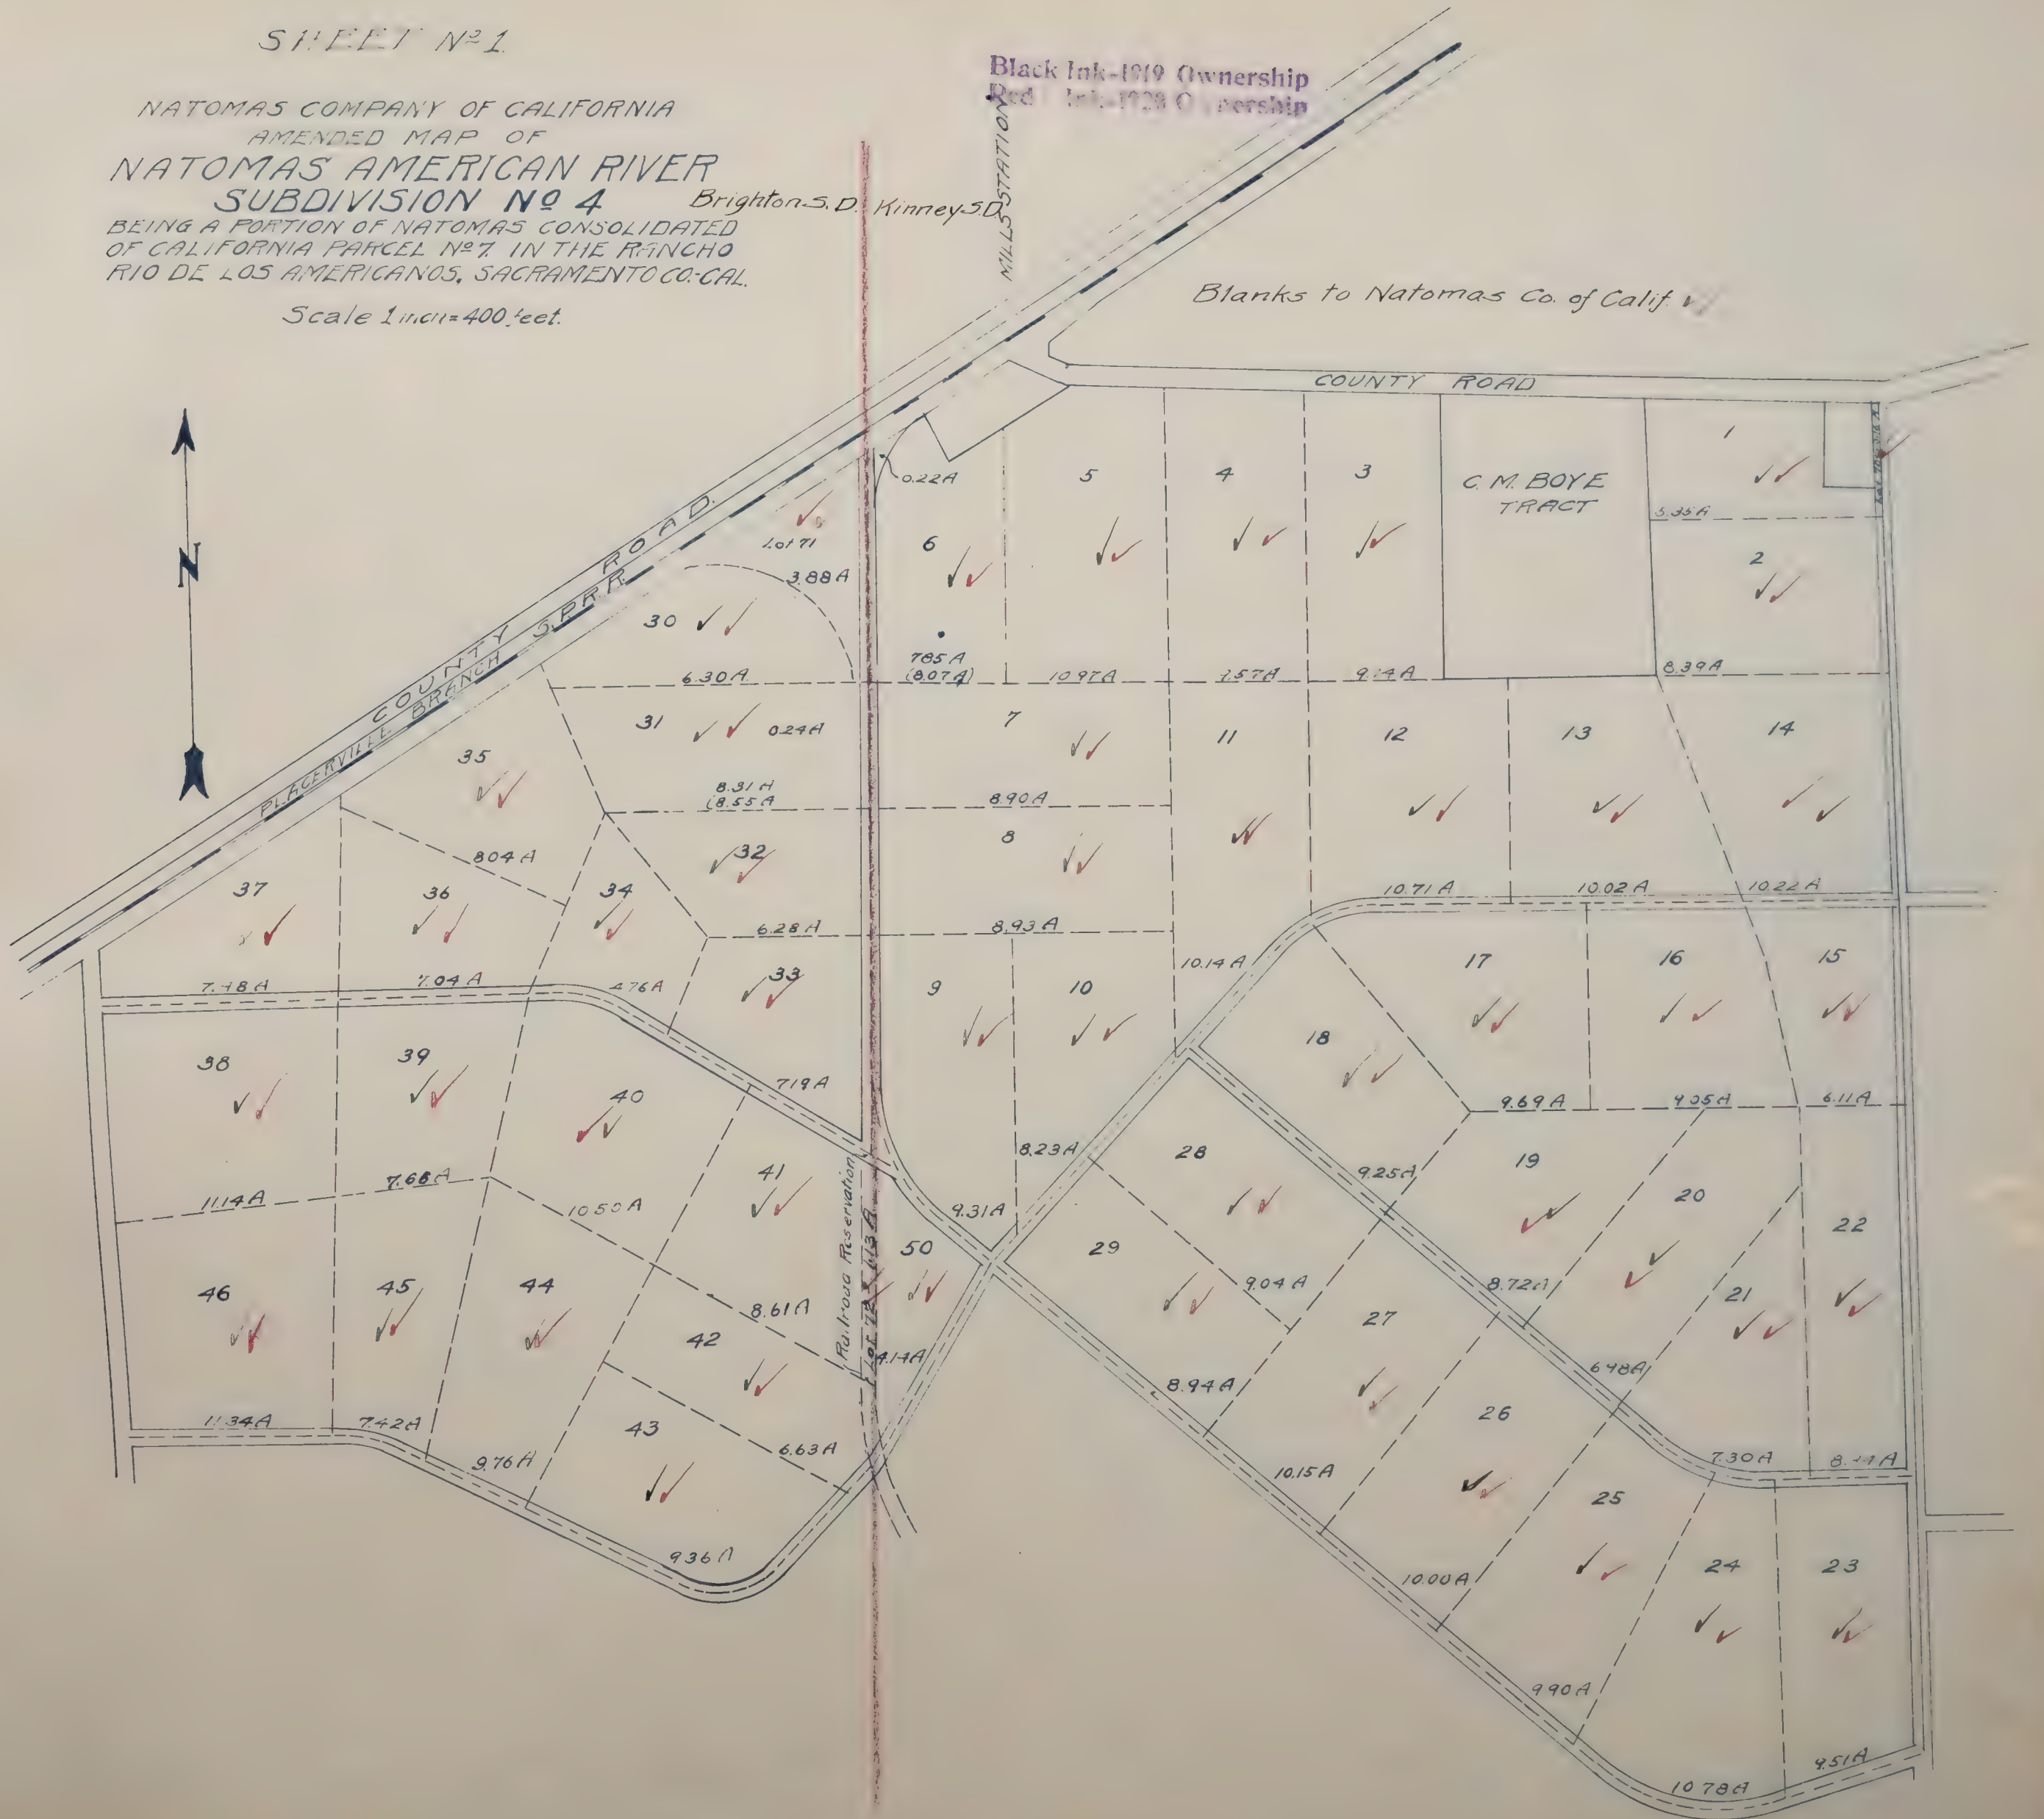

Mapped.

SHEET N^o 2.

Black Ink-1919 Ownership
Red Ink-1919 Ownership

NATOMAS COMPANY OF CALIFORNIA.
AMENDED MAP OF
NATOMAS AMERICAN RIVER
SUBDIVISION N^o 4
BEING A PORTION OF NATOMAS CONSOLIDATED
OF CALIFORNIA PARCEL N^o 7 IN THE RANCHO
RIO DE LOS AMERICANOS, SACRAMENTO CO.-CAL.

Scale 1 inch = 400 feet

Brighton S.D.

Kinney S.D.


Blanks to Natomas Co. of Calif. ✓



Aug. 1851.

Kinney S.D.

All Lots 10 Acres unless otherwise noted.
Blanks assessed to Natomas Co. of California

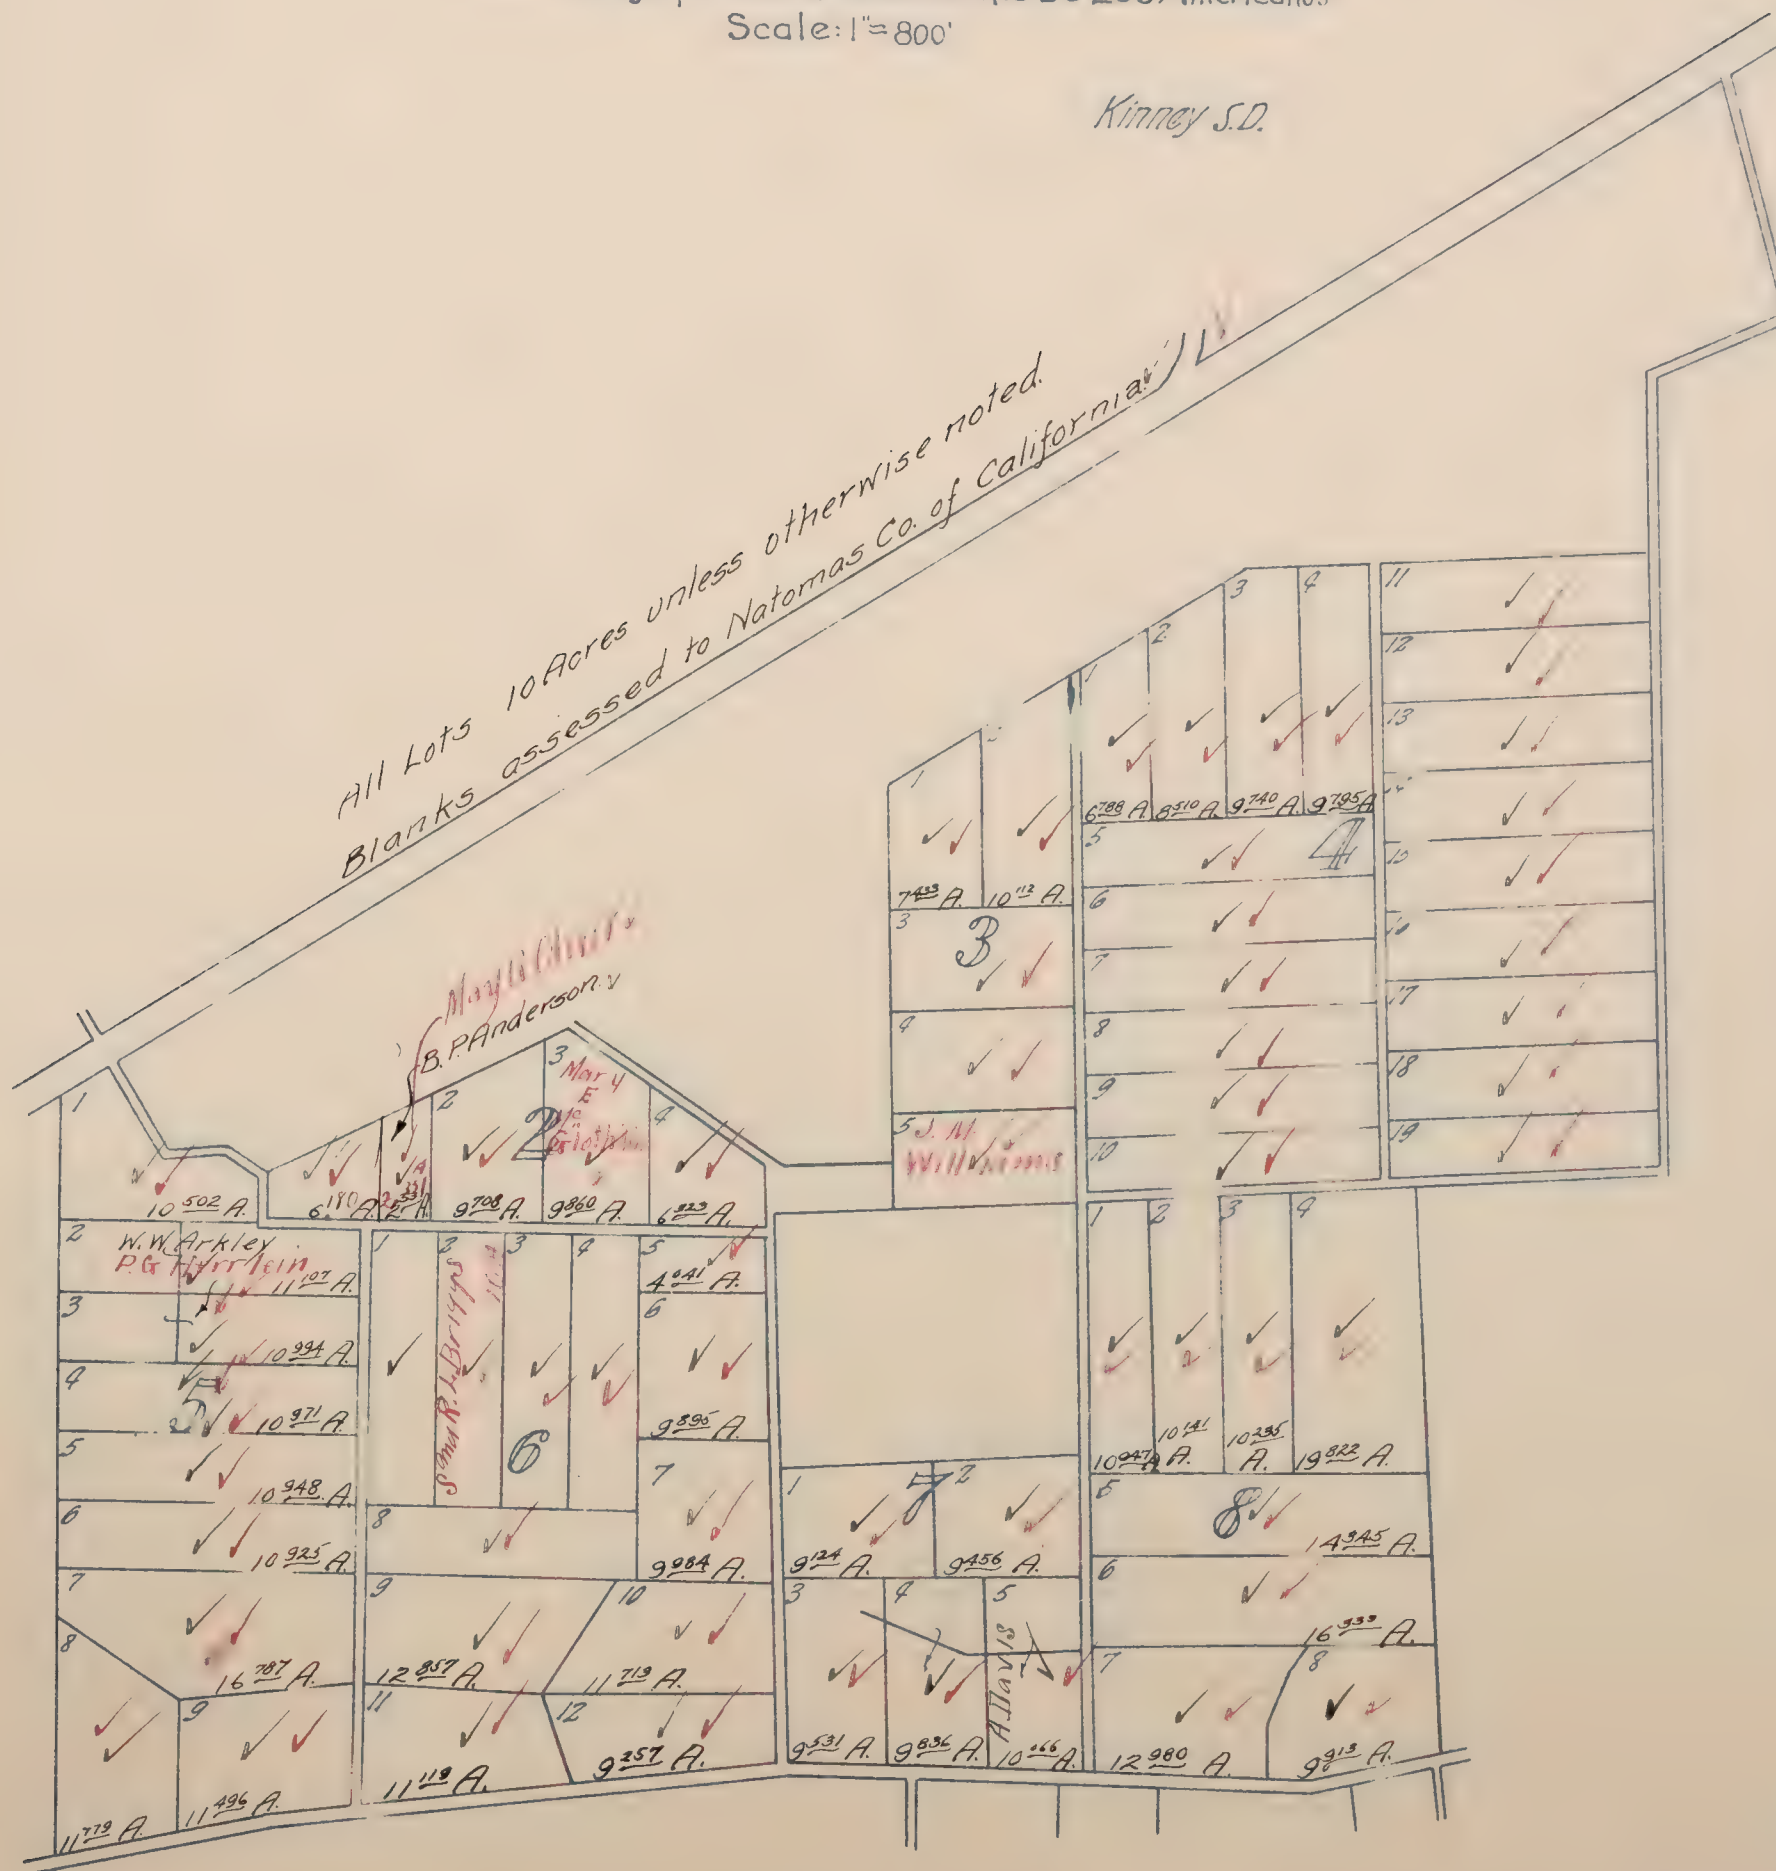

Red
consolidation

being a portion of Rancho Rio De Los Americanos

Kippey S.D.

Blanks assessed to Natoma Co. of Calif. RM

All Lots 9⁹⁸⁶ Acres unless otherwise noted



Black Ink - 1919 Ownership
Red Ink - 1919 Ownership


NATOMAS CONSOLIDATED SUBDIVISION NO. 3

being a portion of
Rancho Rio De Los Americanos
Sacramento Co California

Scale: 1"=600'

Blanks assessed to Natomas Co. of Calif. ✓

All Lots 10 A. except where otherwise marked

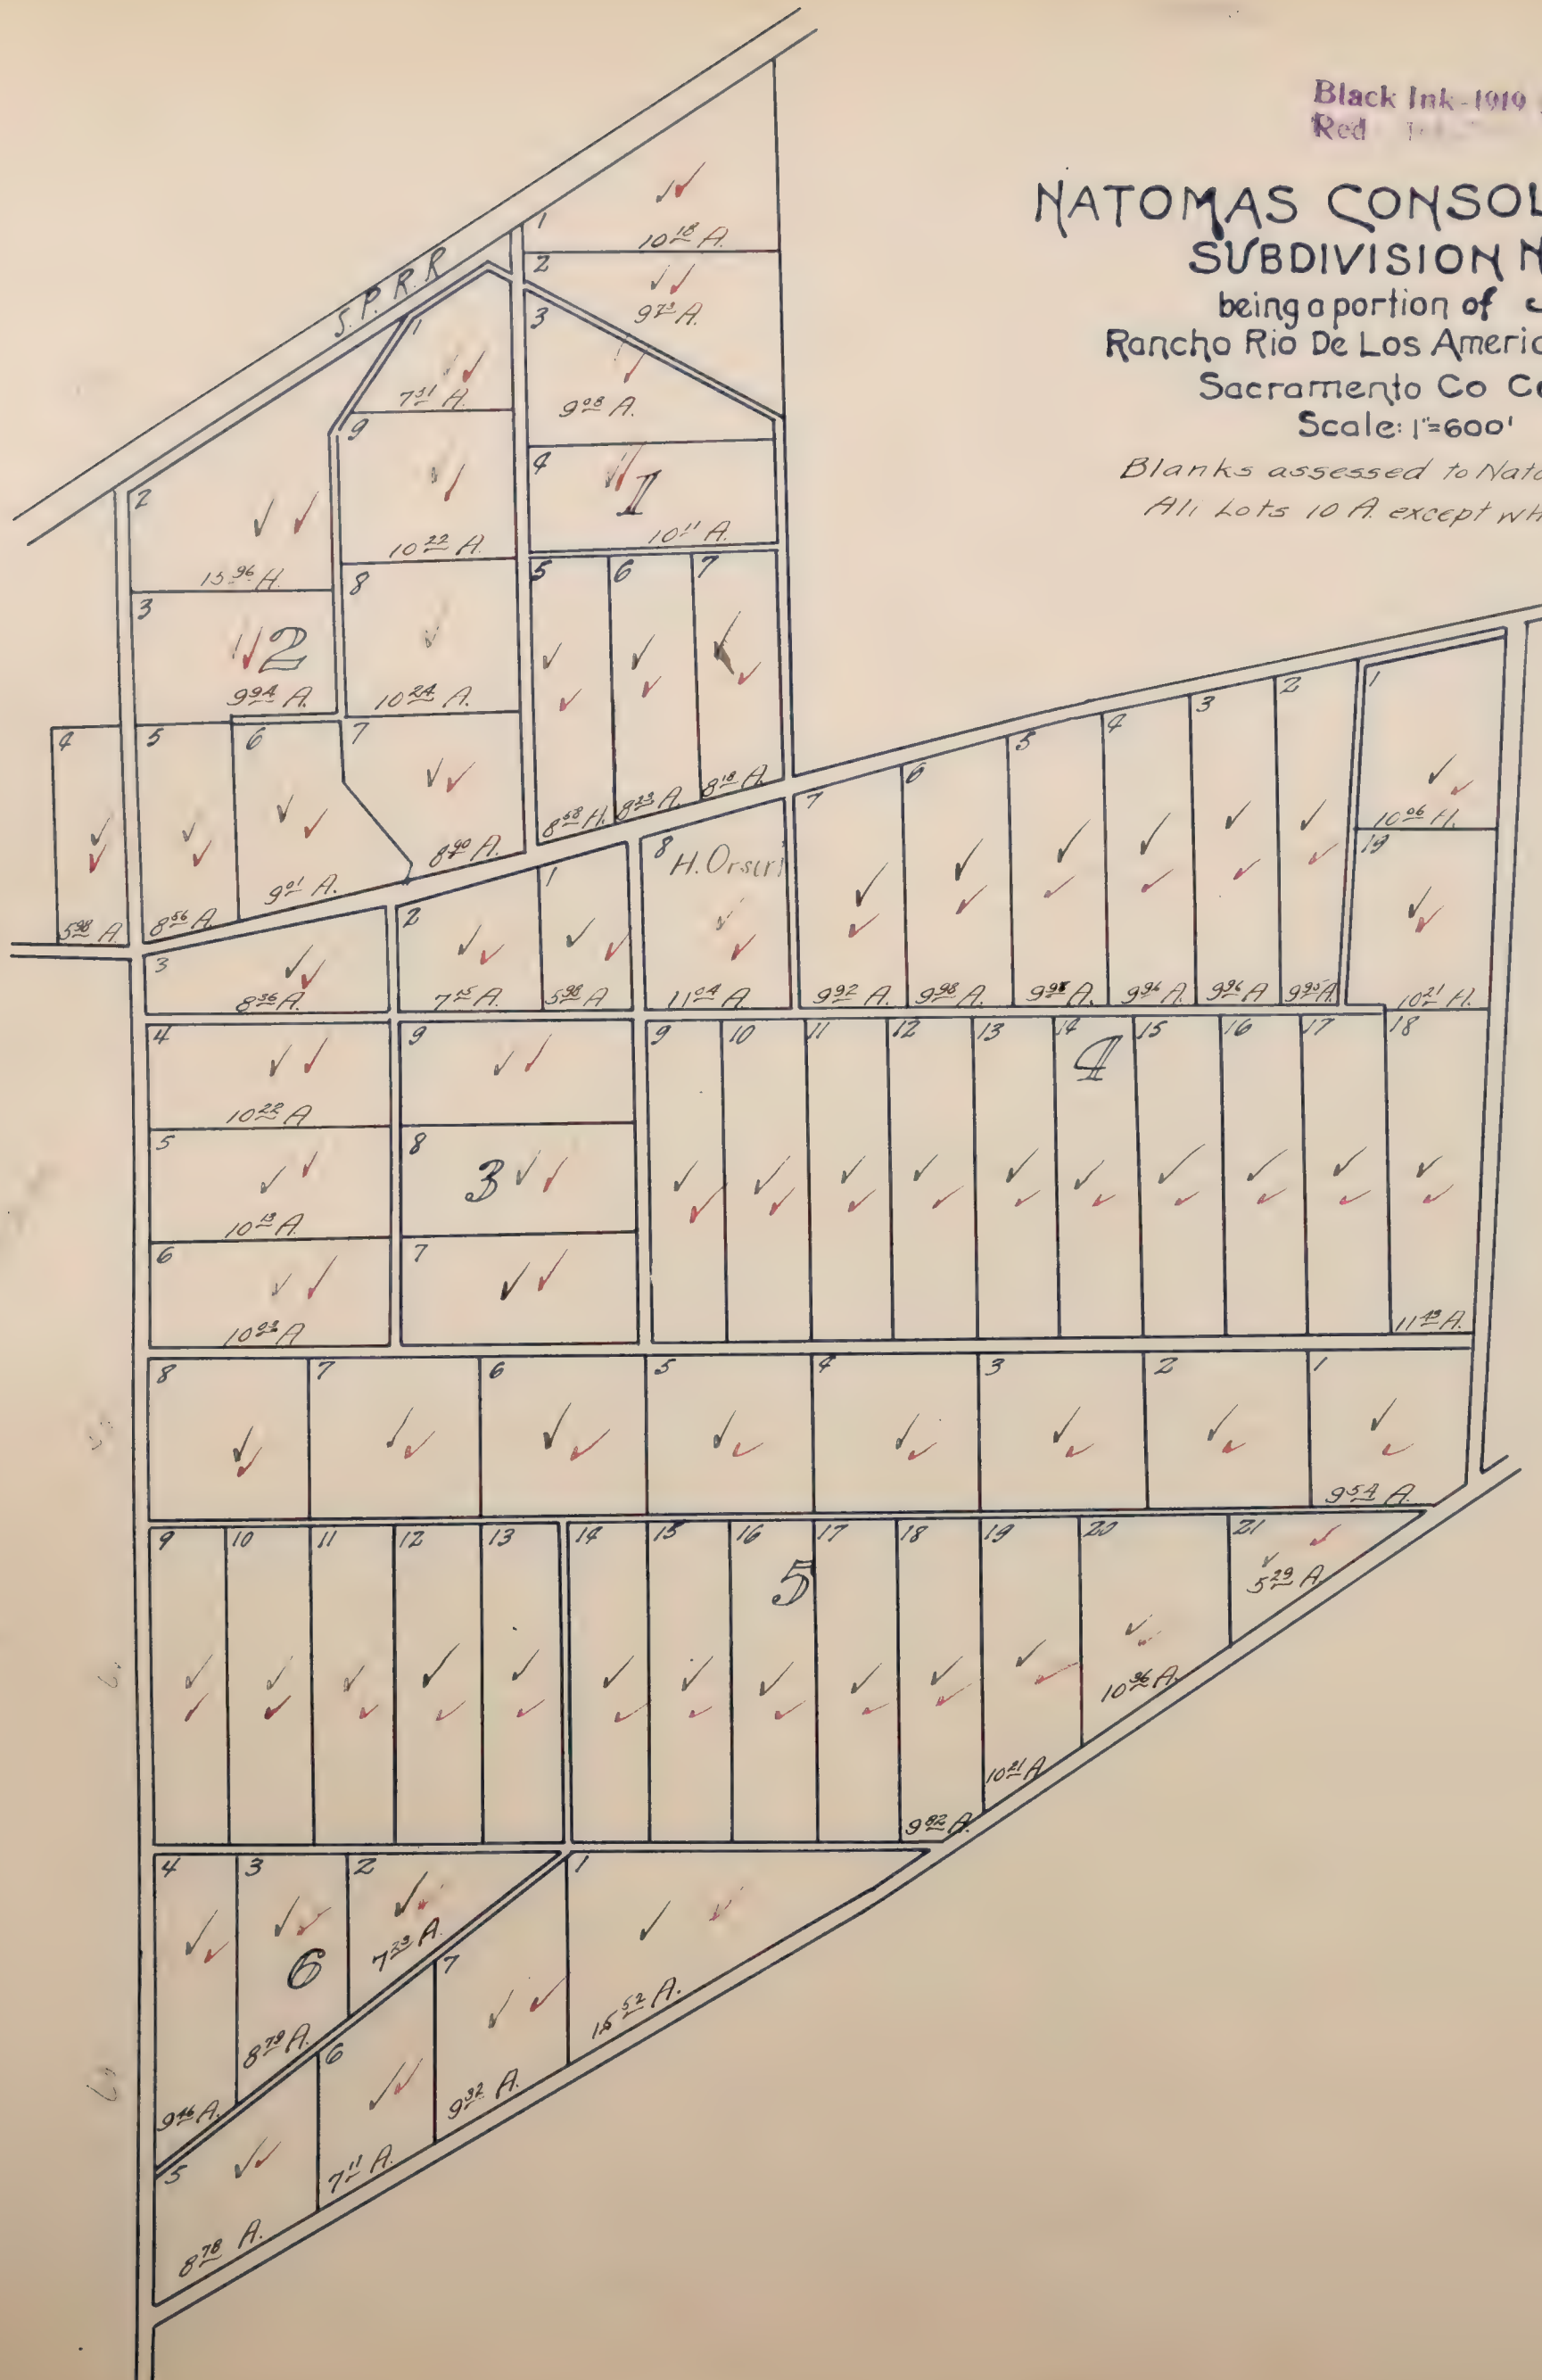

Mapped.

NATOMAS ELKHORN SUBDIVISION

Secs. 12, 13, 23, 24, 25, 26, 35, 36, T10N, R3E - Secs 1, 2, T9N, R3E Black Ink - 1919 Ownership
Secs. 7, 18, 19, 20, 29, 30, 31, 32, T10N, R4E - Secs 5, 6, T9N, R4E Red Ink - 1920 Ownership

Scale:- 1 in = 600 feet.

SHEET 1

Amv. Basin S.D.

All lands assessed to Natomas Co. of California.



Secs. 7, 18, 19, 20, 29, 30, 31, 32, T10N R4E - Secs. 5, 6, T9N, R4E.

Rev Brewin J.R.

SHEET 2
 Nelson & Company of California ✓



NATOMAS ELKHORN SUBDIVISION


Secs. 12, 13, 23, 24, 25, 26, 35, 36, T10N, R3E - Secs. 1, 2, T9N, R3E.
Secs. 7, 18, 19, 20, 29, 30, 31, 32 T10N, R4E - Secs. 5, 6, T9N, R4E.

Scale:- 1 in. = 600 feet.

SHEET 3.

Black Ink-1919 Ownership
Red Ink-1920 Ownership
Hudson's Company of California

1919, Basin 1A

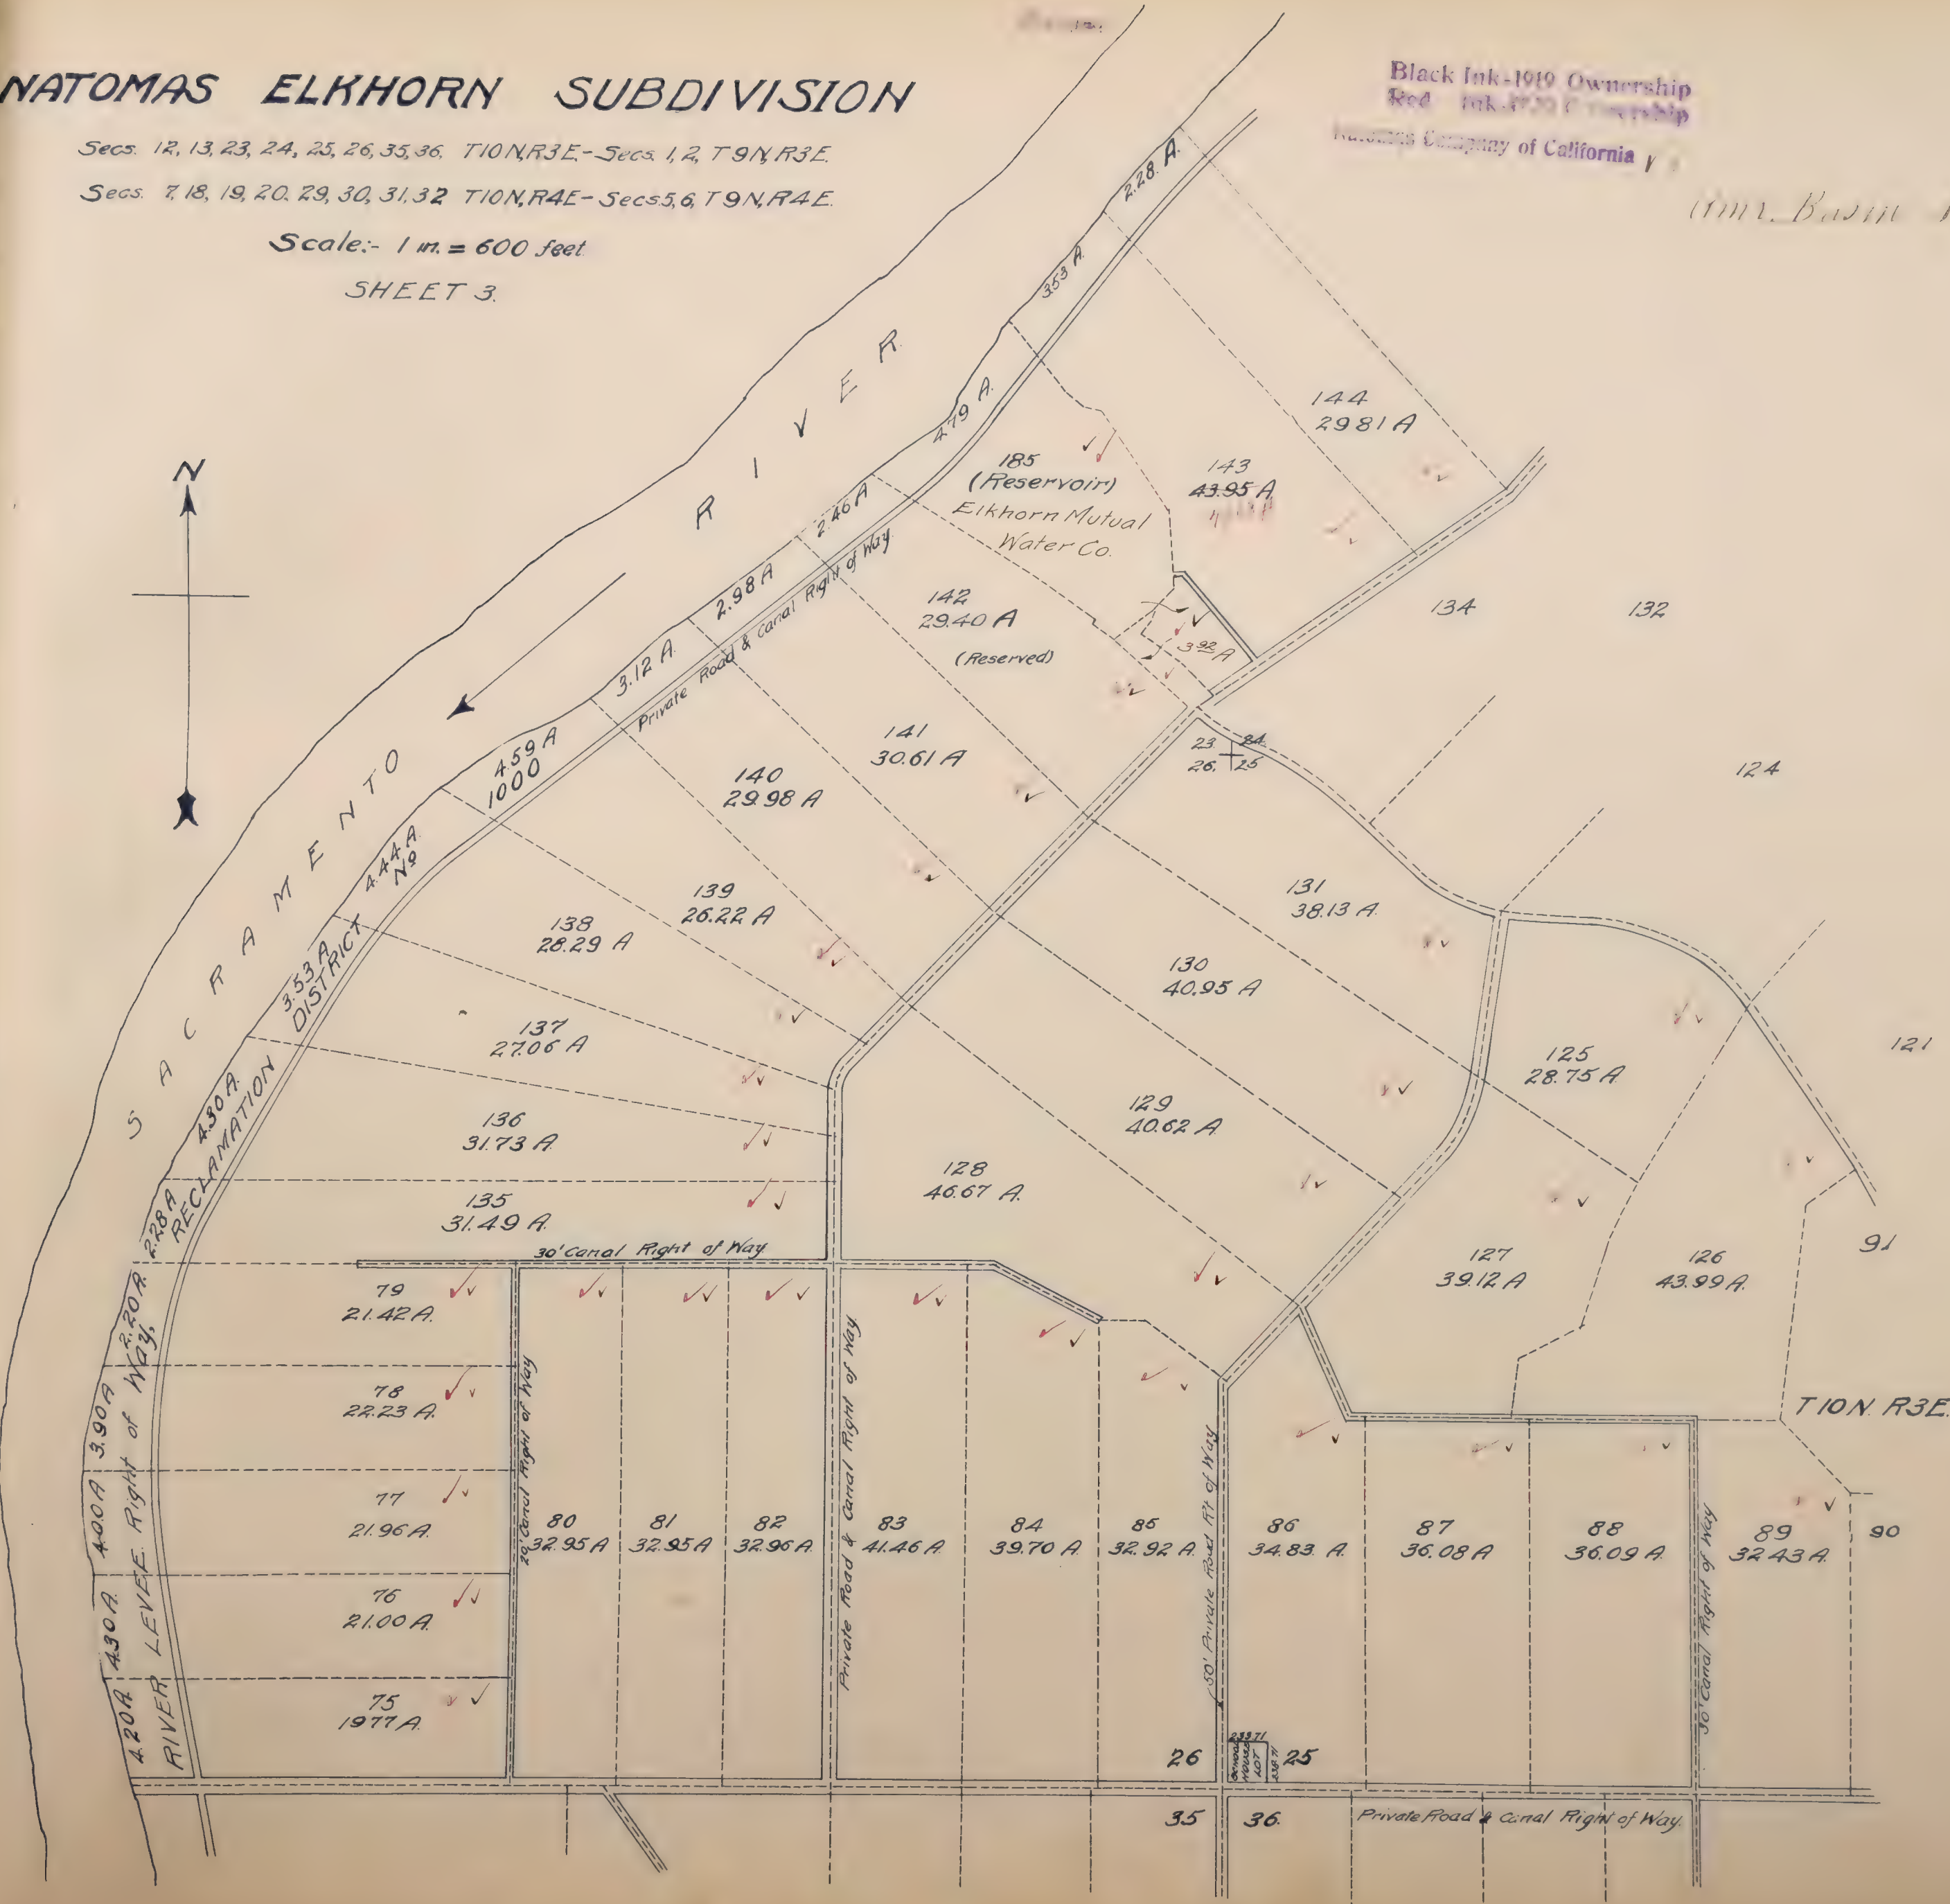

Mapped.

Black Ink 1919 Ownership
Red Ink 1929 Ownership

Paterson Company of California ✓

Am. V. Basin 1.2


NATOMAS ELKHORN SUBDIVISION

Secs. 12, 13, 23, 24, 25, 26, 35, 36, T10N, R3E - Secs. 1, 2, T9N, R3E

Secs. 7, 18, 19, 20, 29, 30, 31, 32, T10N, R4E - Secs. 1, 2, T9N, R4E

Scale: 1 inch = 600 feet.

SHEET 4

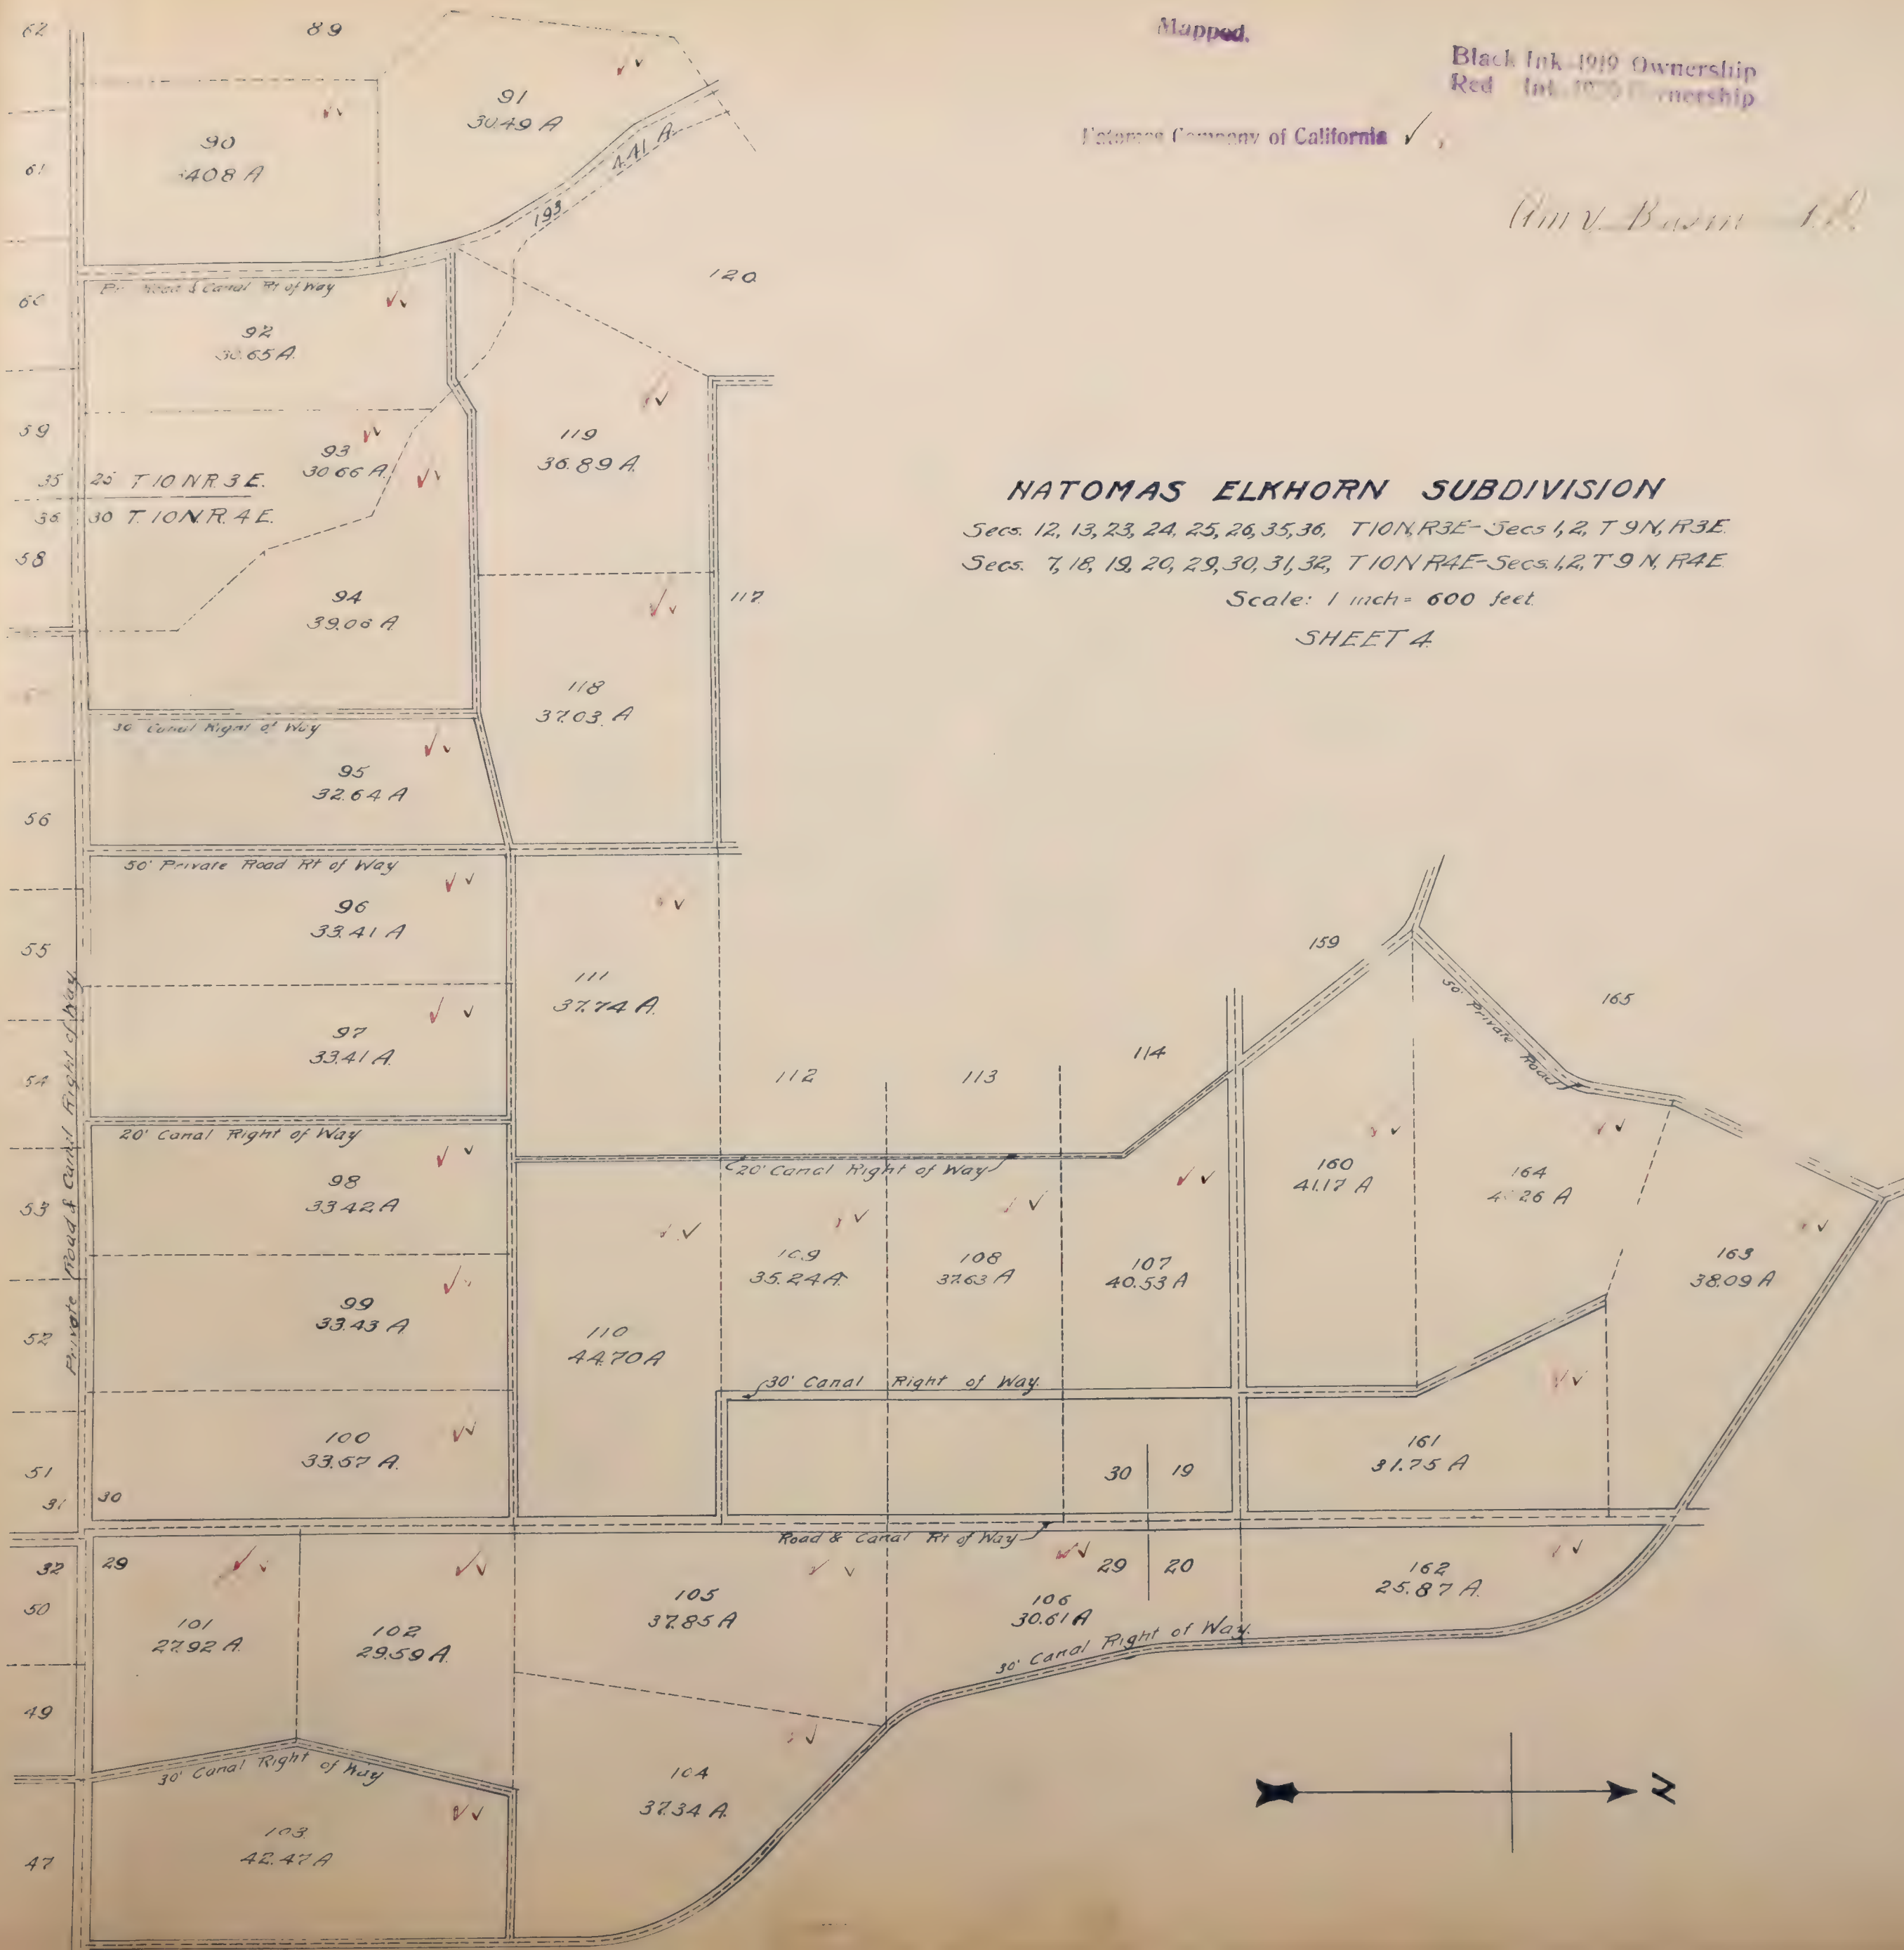

Wm. Brewster 18.

Secs 12, 13, 23, 24, 25, 26, 35, 36, T10N R3E - Secs 12, T9N, R3E.


Secs. 7, 18, 19, 20, 29, 30, 31, 32, T10N R4E Secs. 5, 6, T9N R4E

Scale: 1 inch = 600 feet.


SHEET 5 Natomas Company of California ✓✓

Black Ink-1019 Ownership

Wm. Brewster 18.

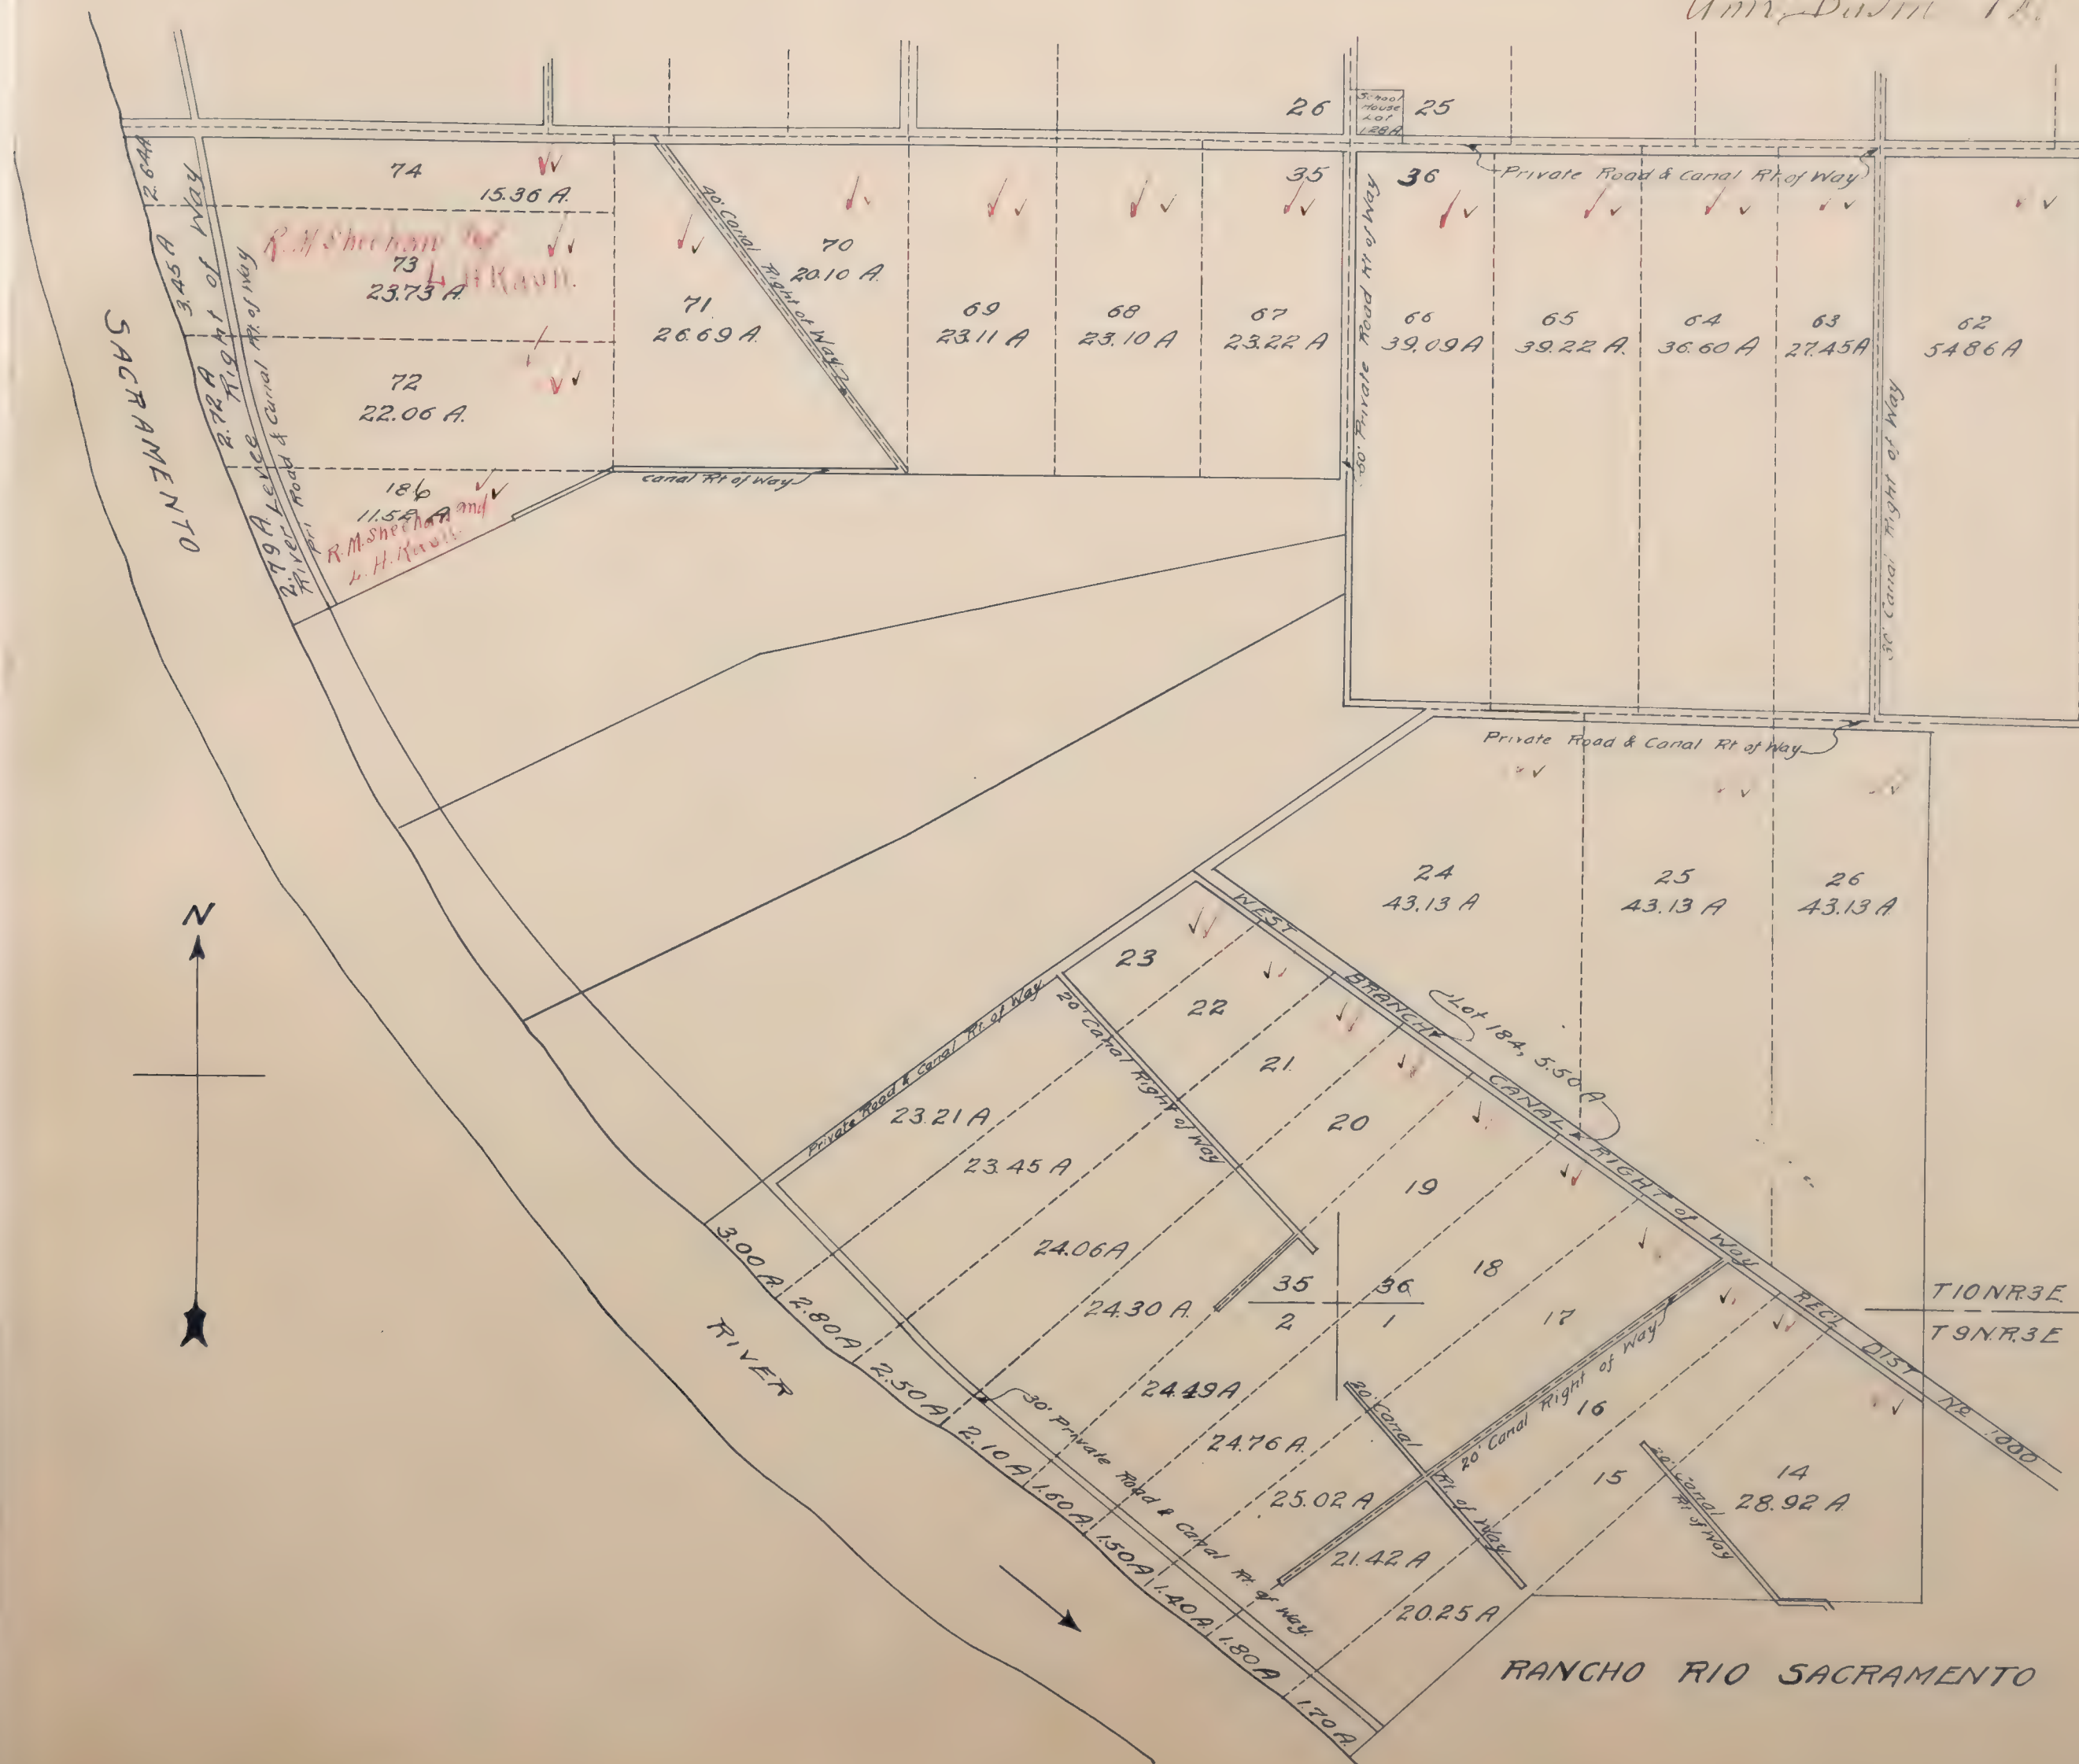

Patron: Company of Coleridge. ✓

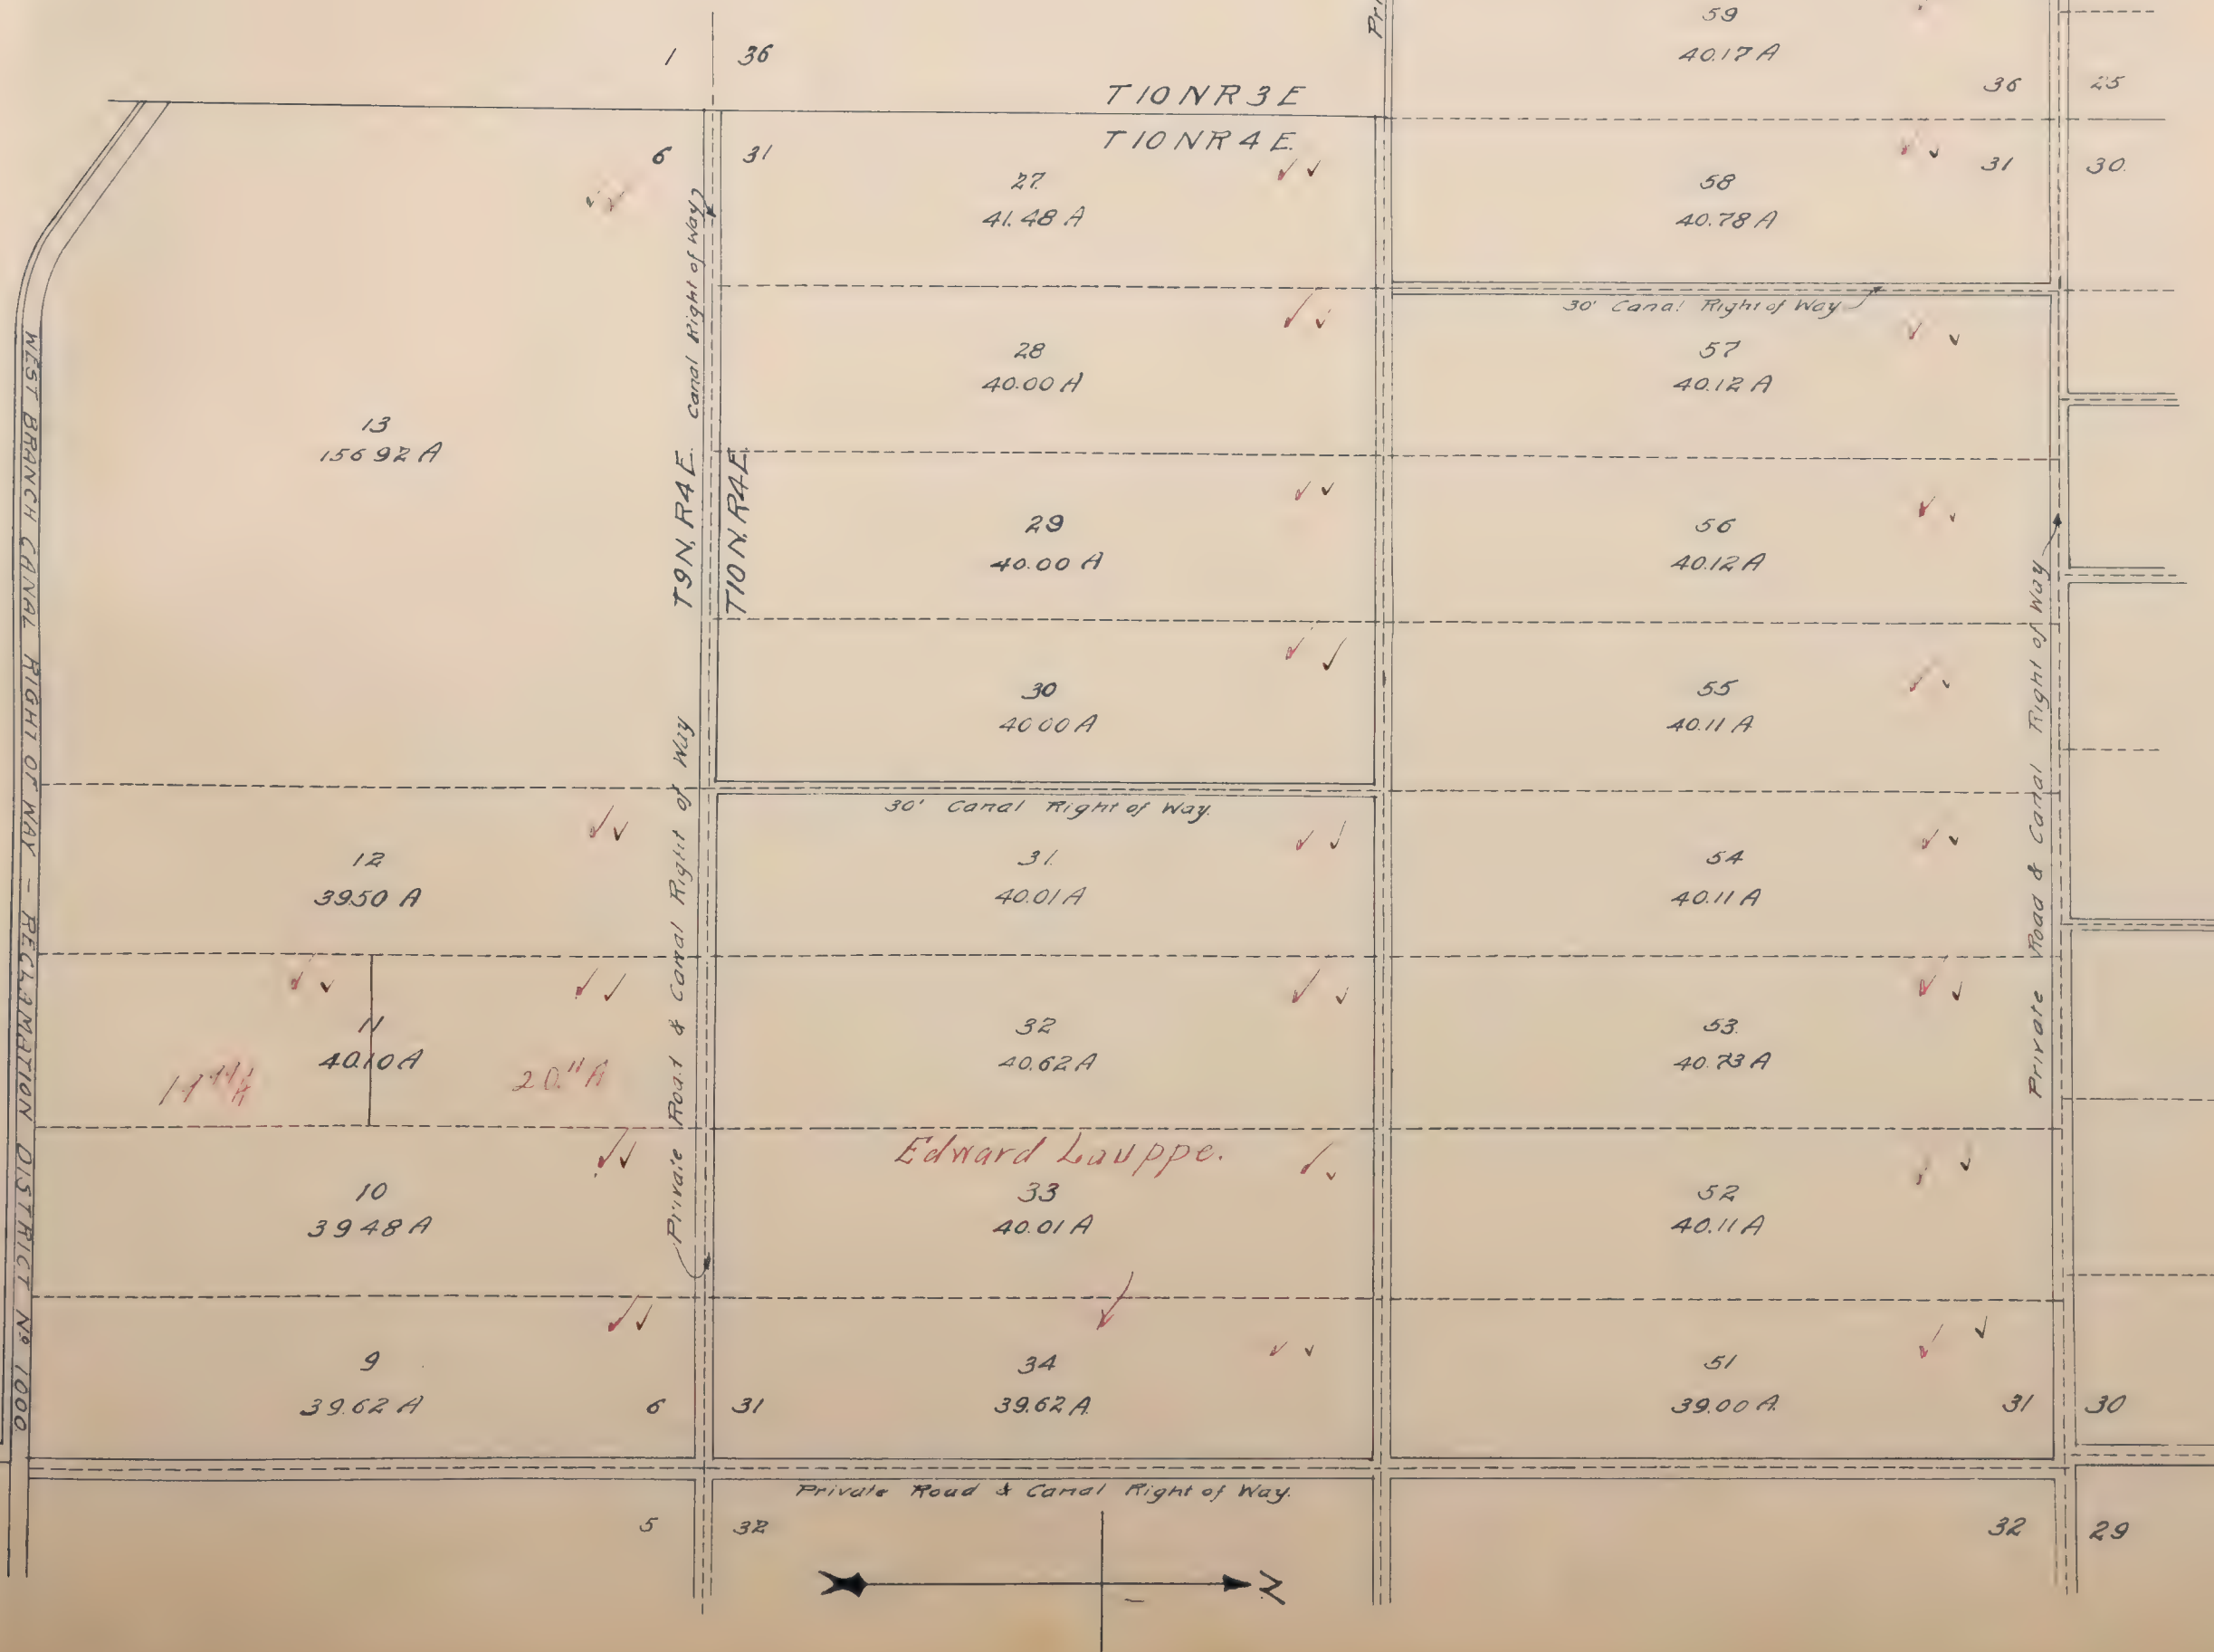

Mapped.
Black Ink-1919 Ownership
Red Ink-1920 Ownership

NATOMAS ELKHORN SUBDIVISION.

Secs. 12, 13, 23, 24, 25, 26, 35, 36, T10N, R3E Secs 1, 2, T9N, R3E


Secs. 7, 18, 19, 20, 29, 30, 31, 32, T10N, R4E - Secs 5, 6, T9N, R4E.

Scale 1 inch = 600 feet.

SHEET 7.

all blocks reserved to Natoma Co. of California

1111 V. Basin S. M.

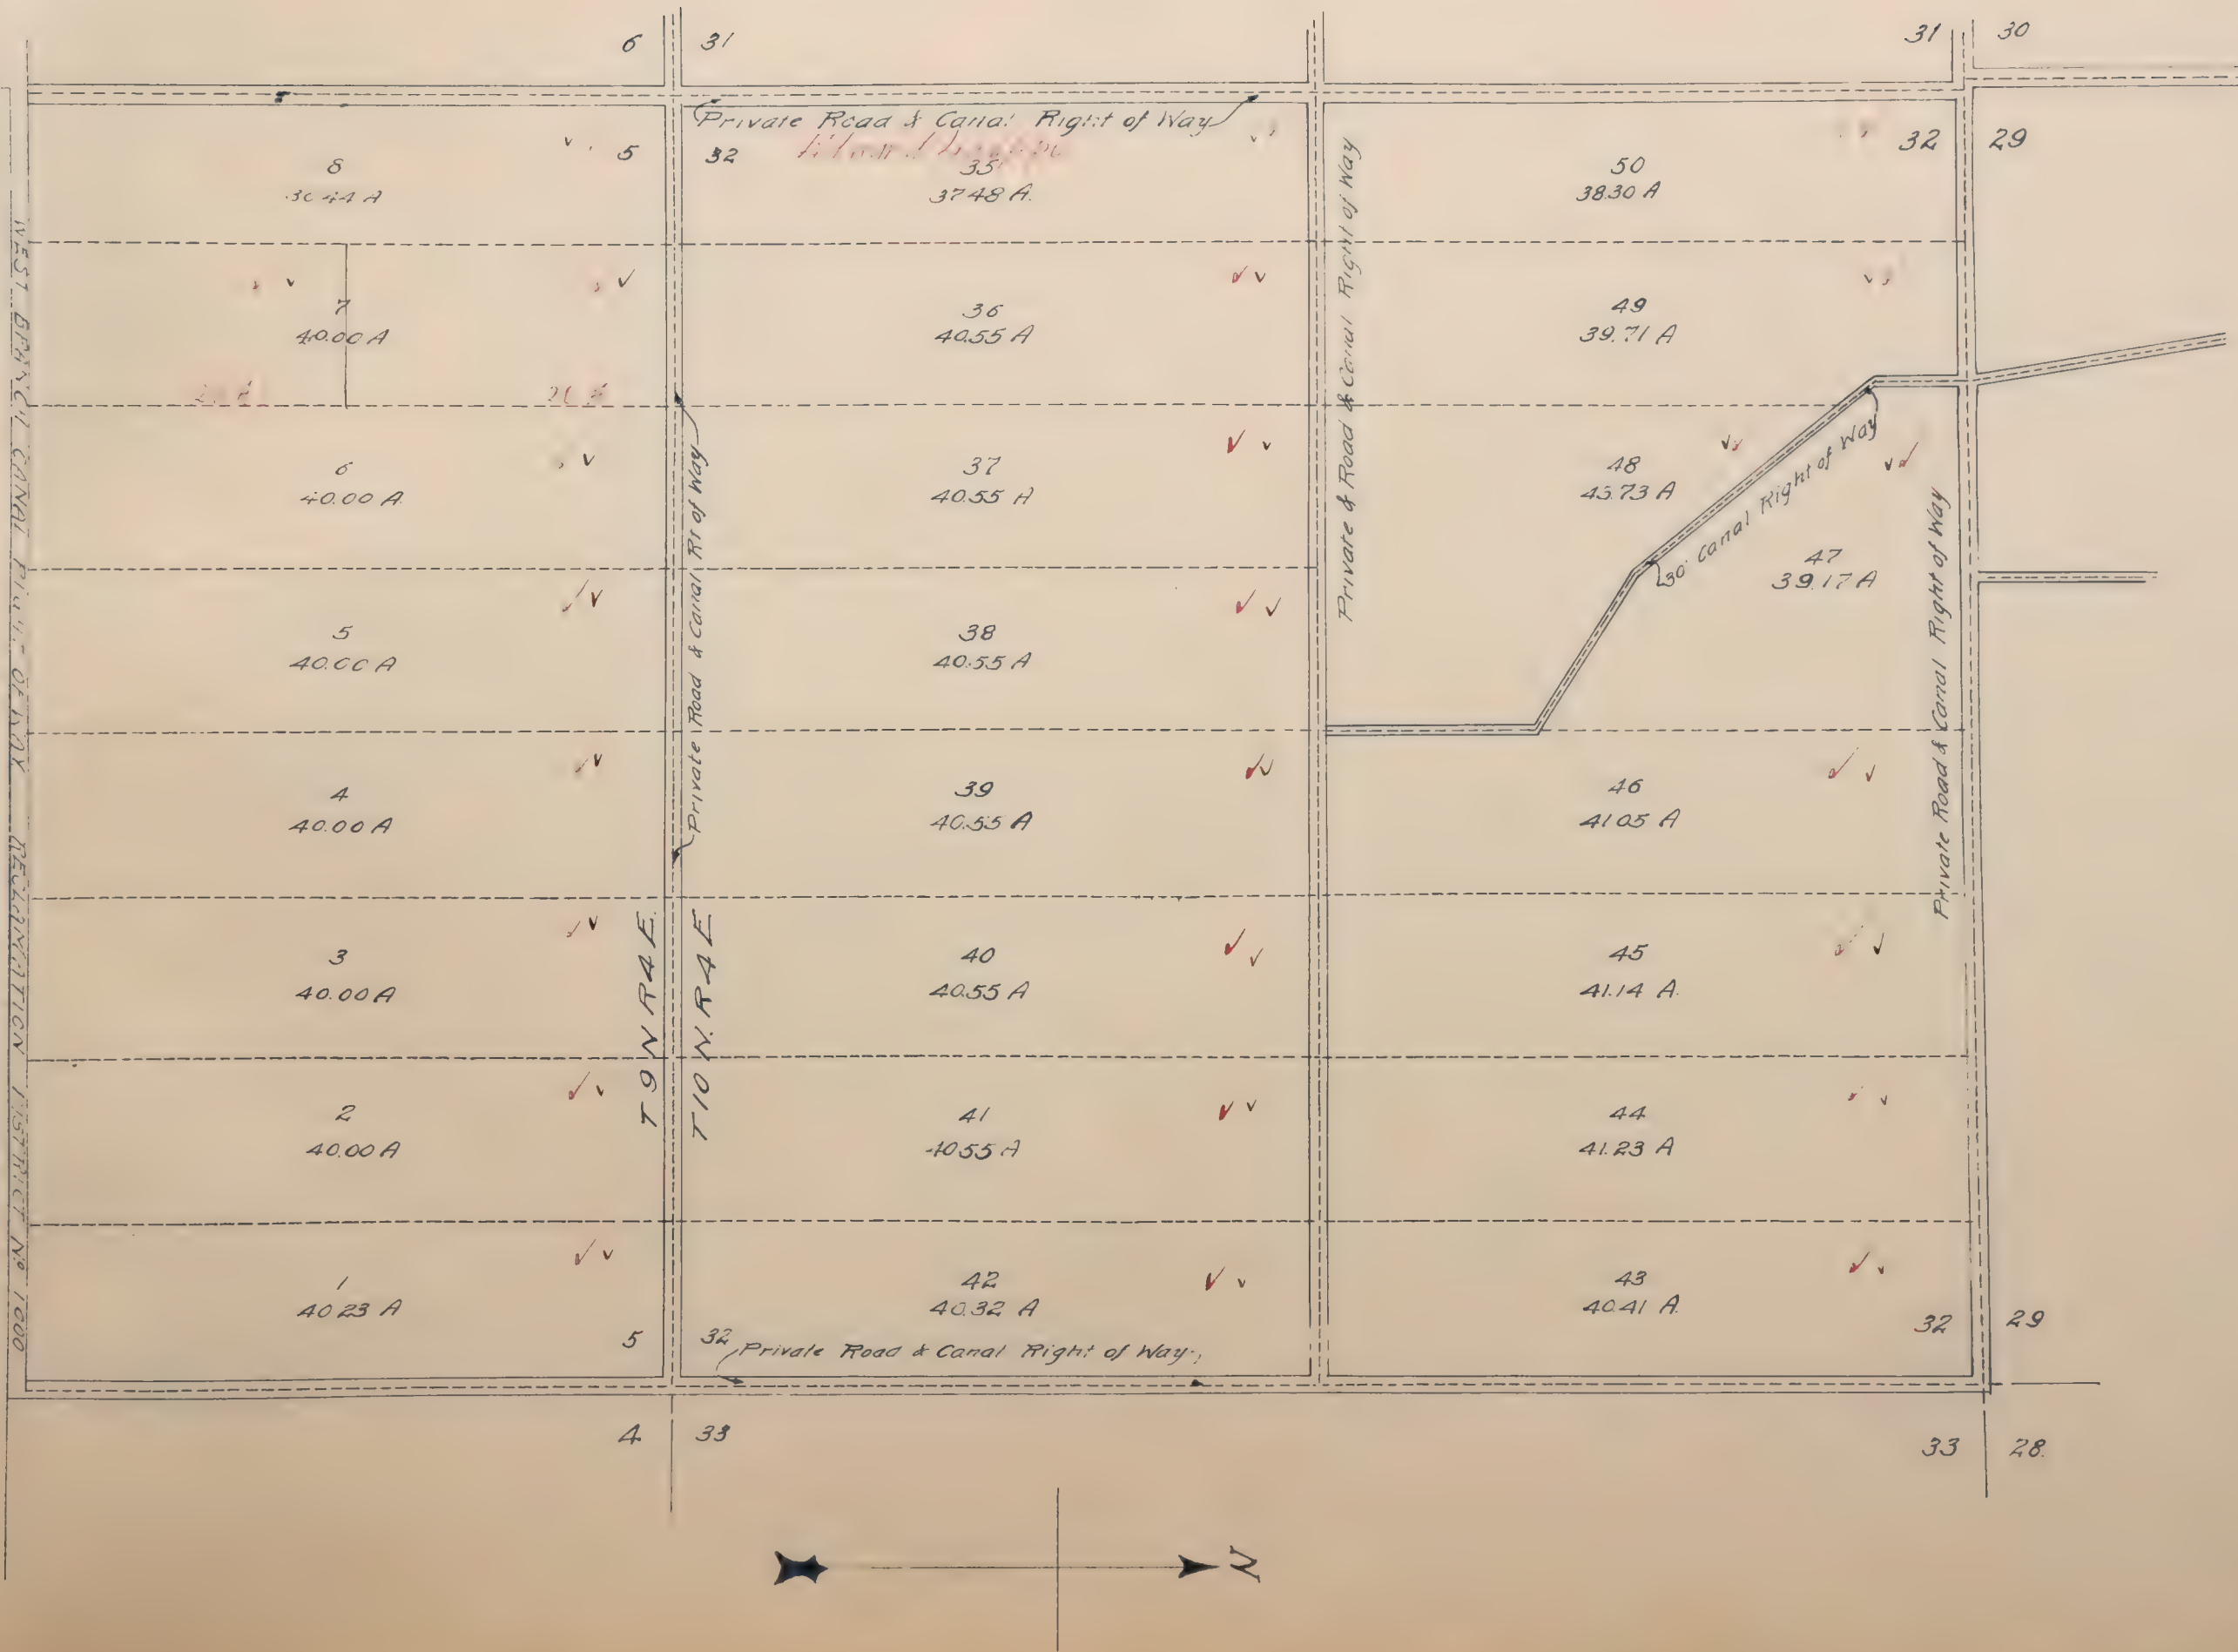

28 27

NATOMAS RIVERSIDE SUBD'N. No 1


LOCATED IN

SEC'S. 27 & 28, T. 9. N., R. 4 E.,

Scale 1" = 400 Feet

Blanks to Natoma Co. of Calif. ✓✓
All Lots 10 Acres

Jefferson. N.

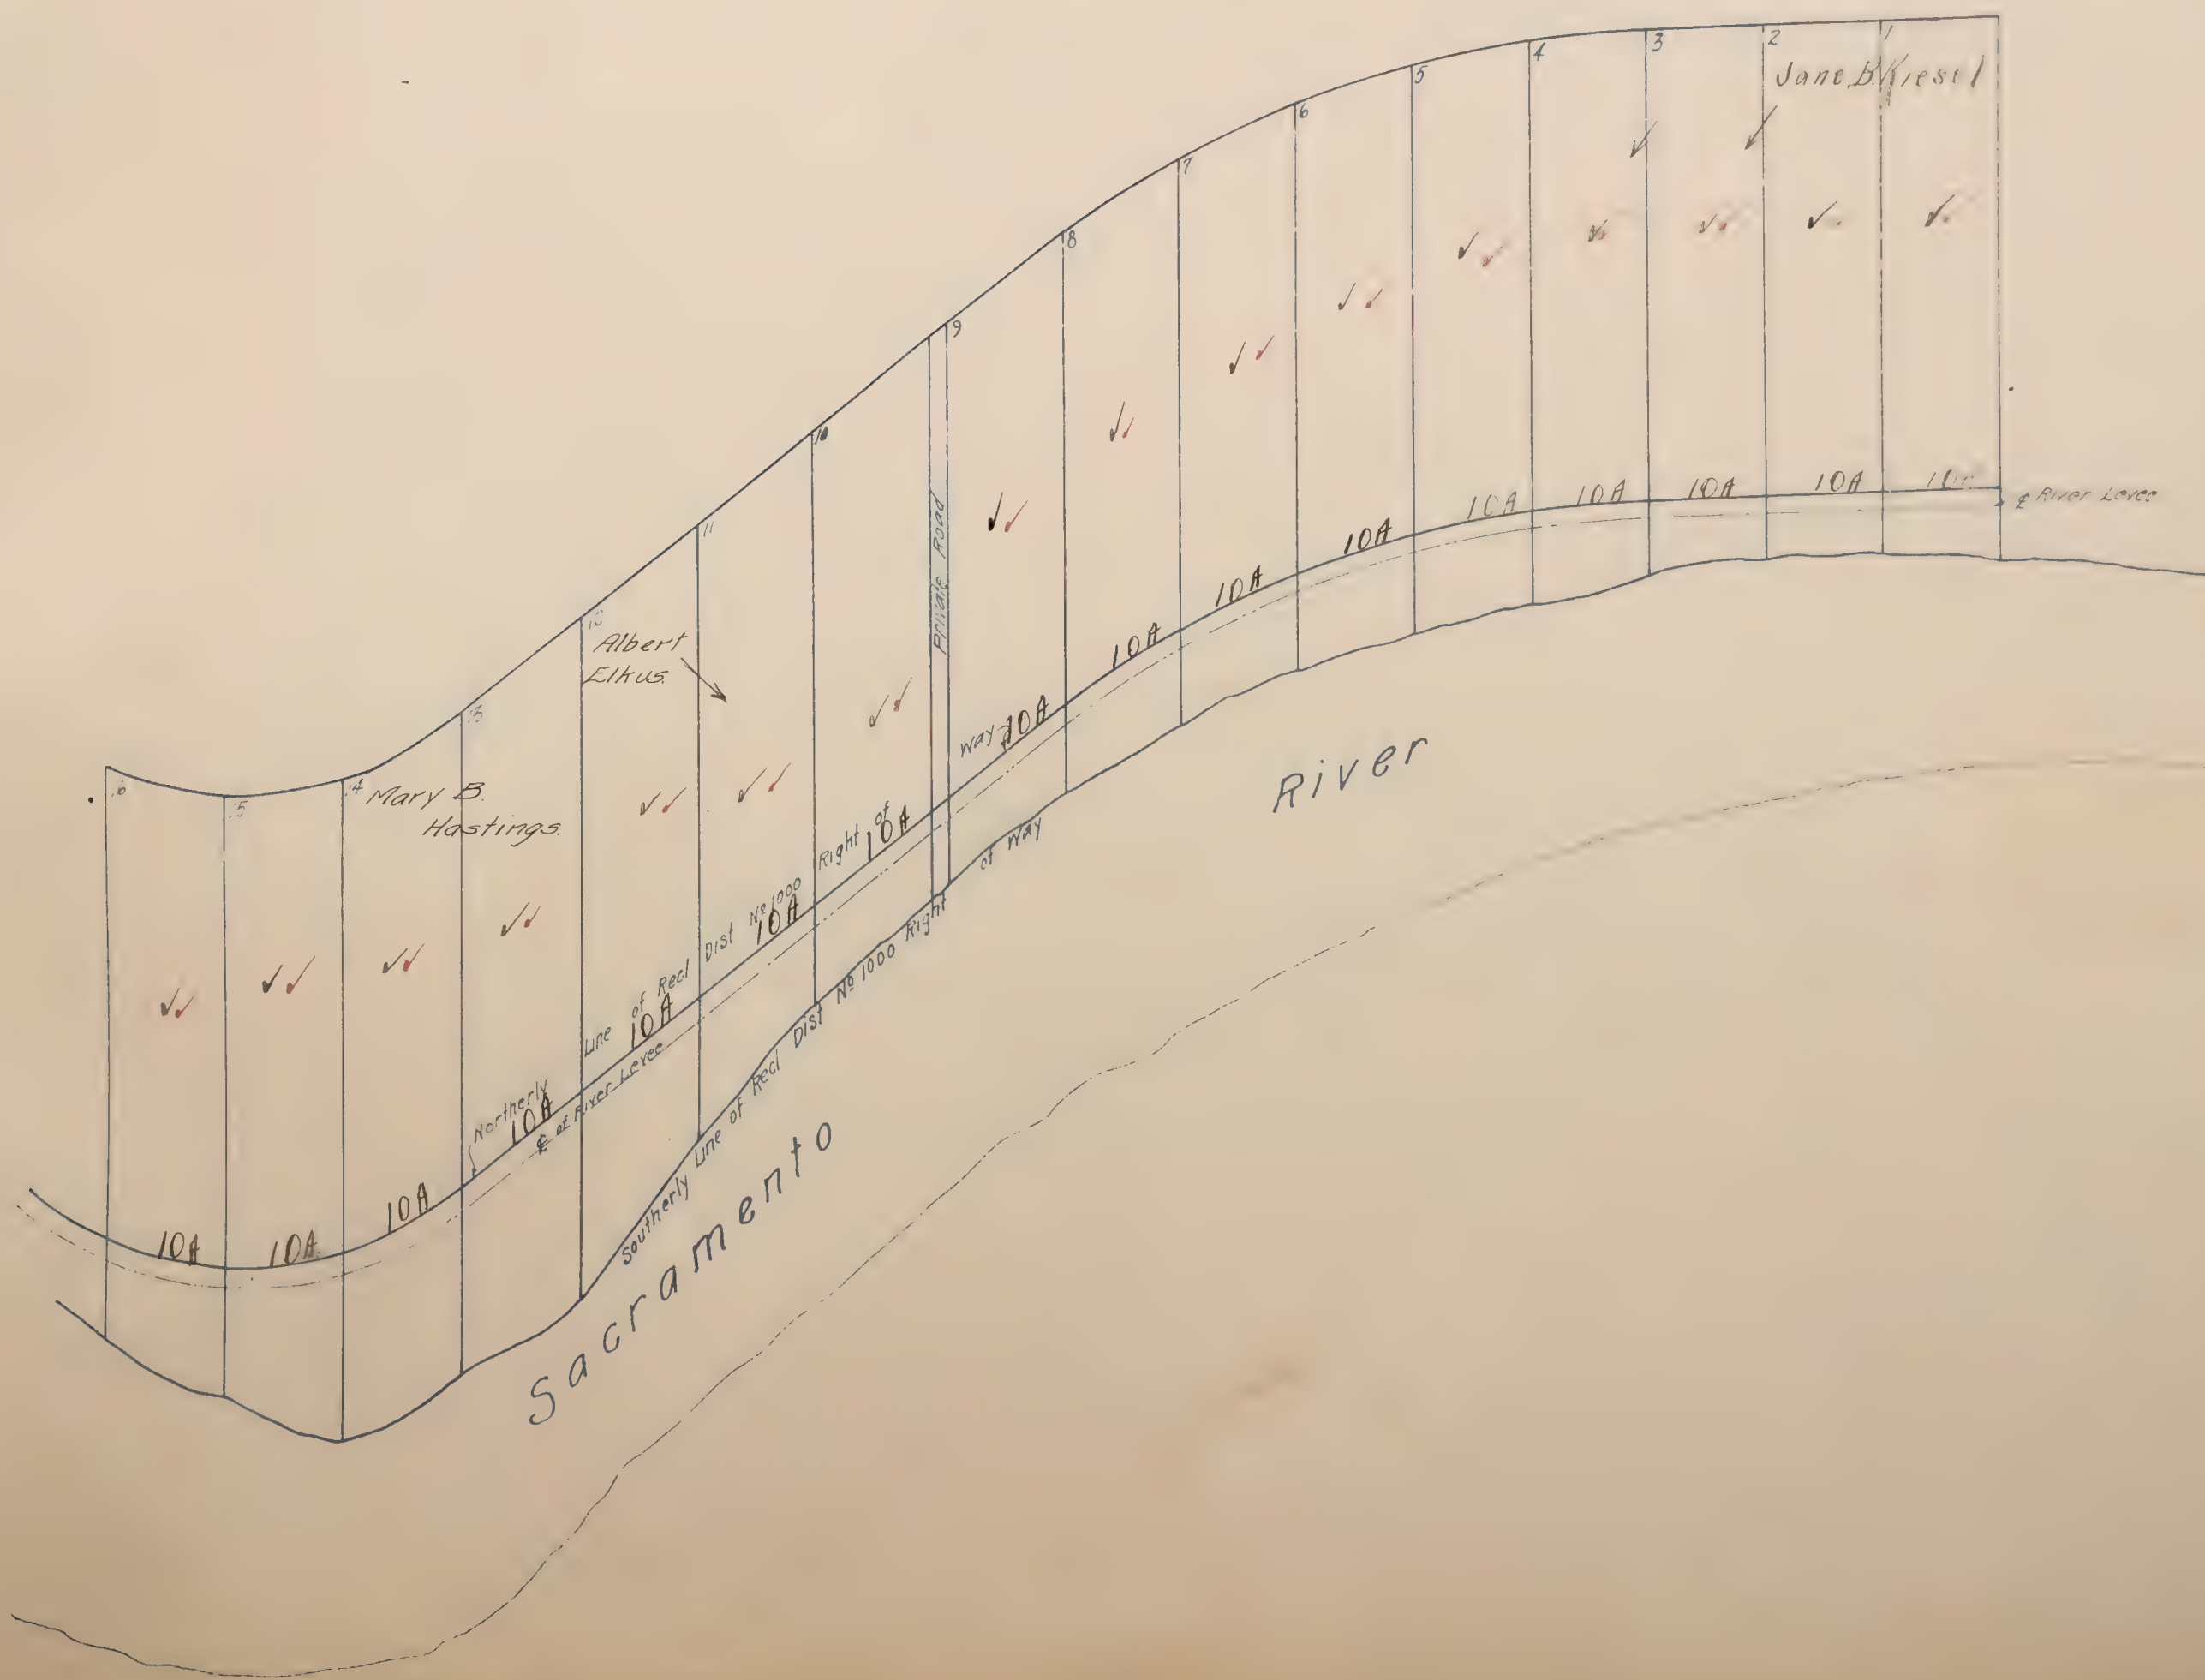

Mapped.

Black Ink-1919 Ownership
Red Ink-1920 Ownership

NATOMAS RIVERSIDE SUBDIVISION No 2


Located in Secs. 20-21-22-27-28-29-T9 NR 4E

SHEET 1

Scale 1 inch = 600 feet

Blanks to Natomas Co. of Calif.

Jefferson, I.A.

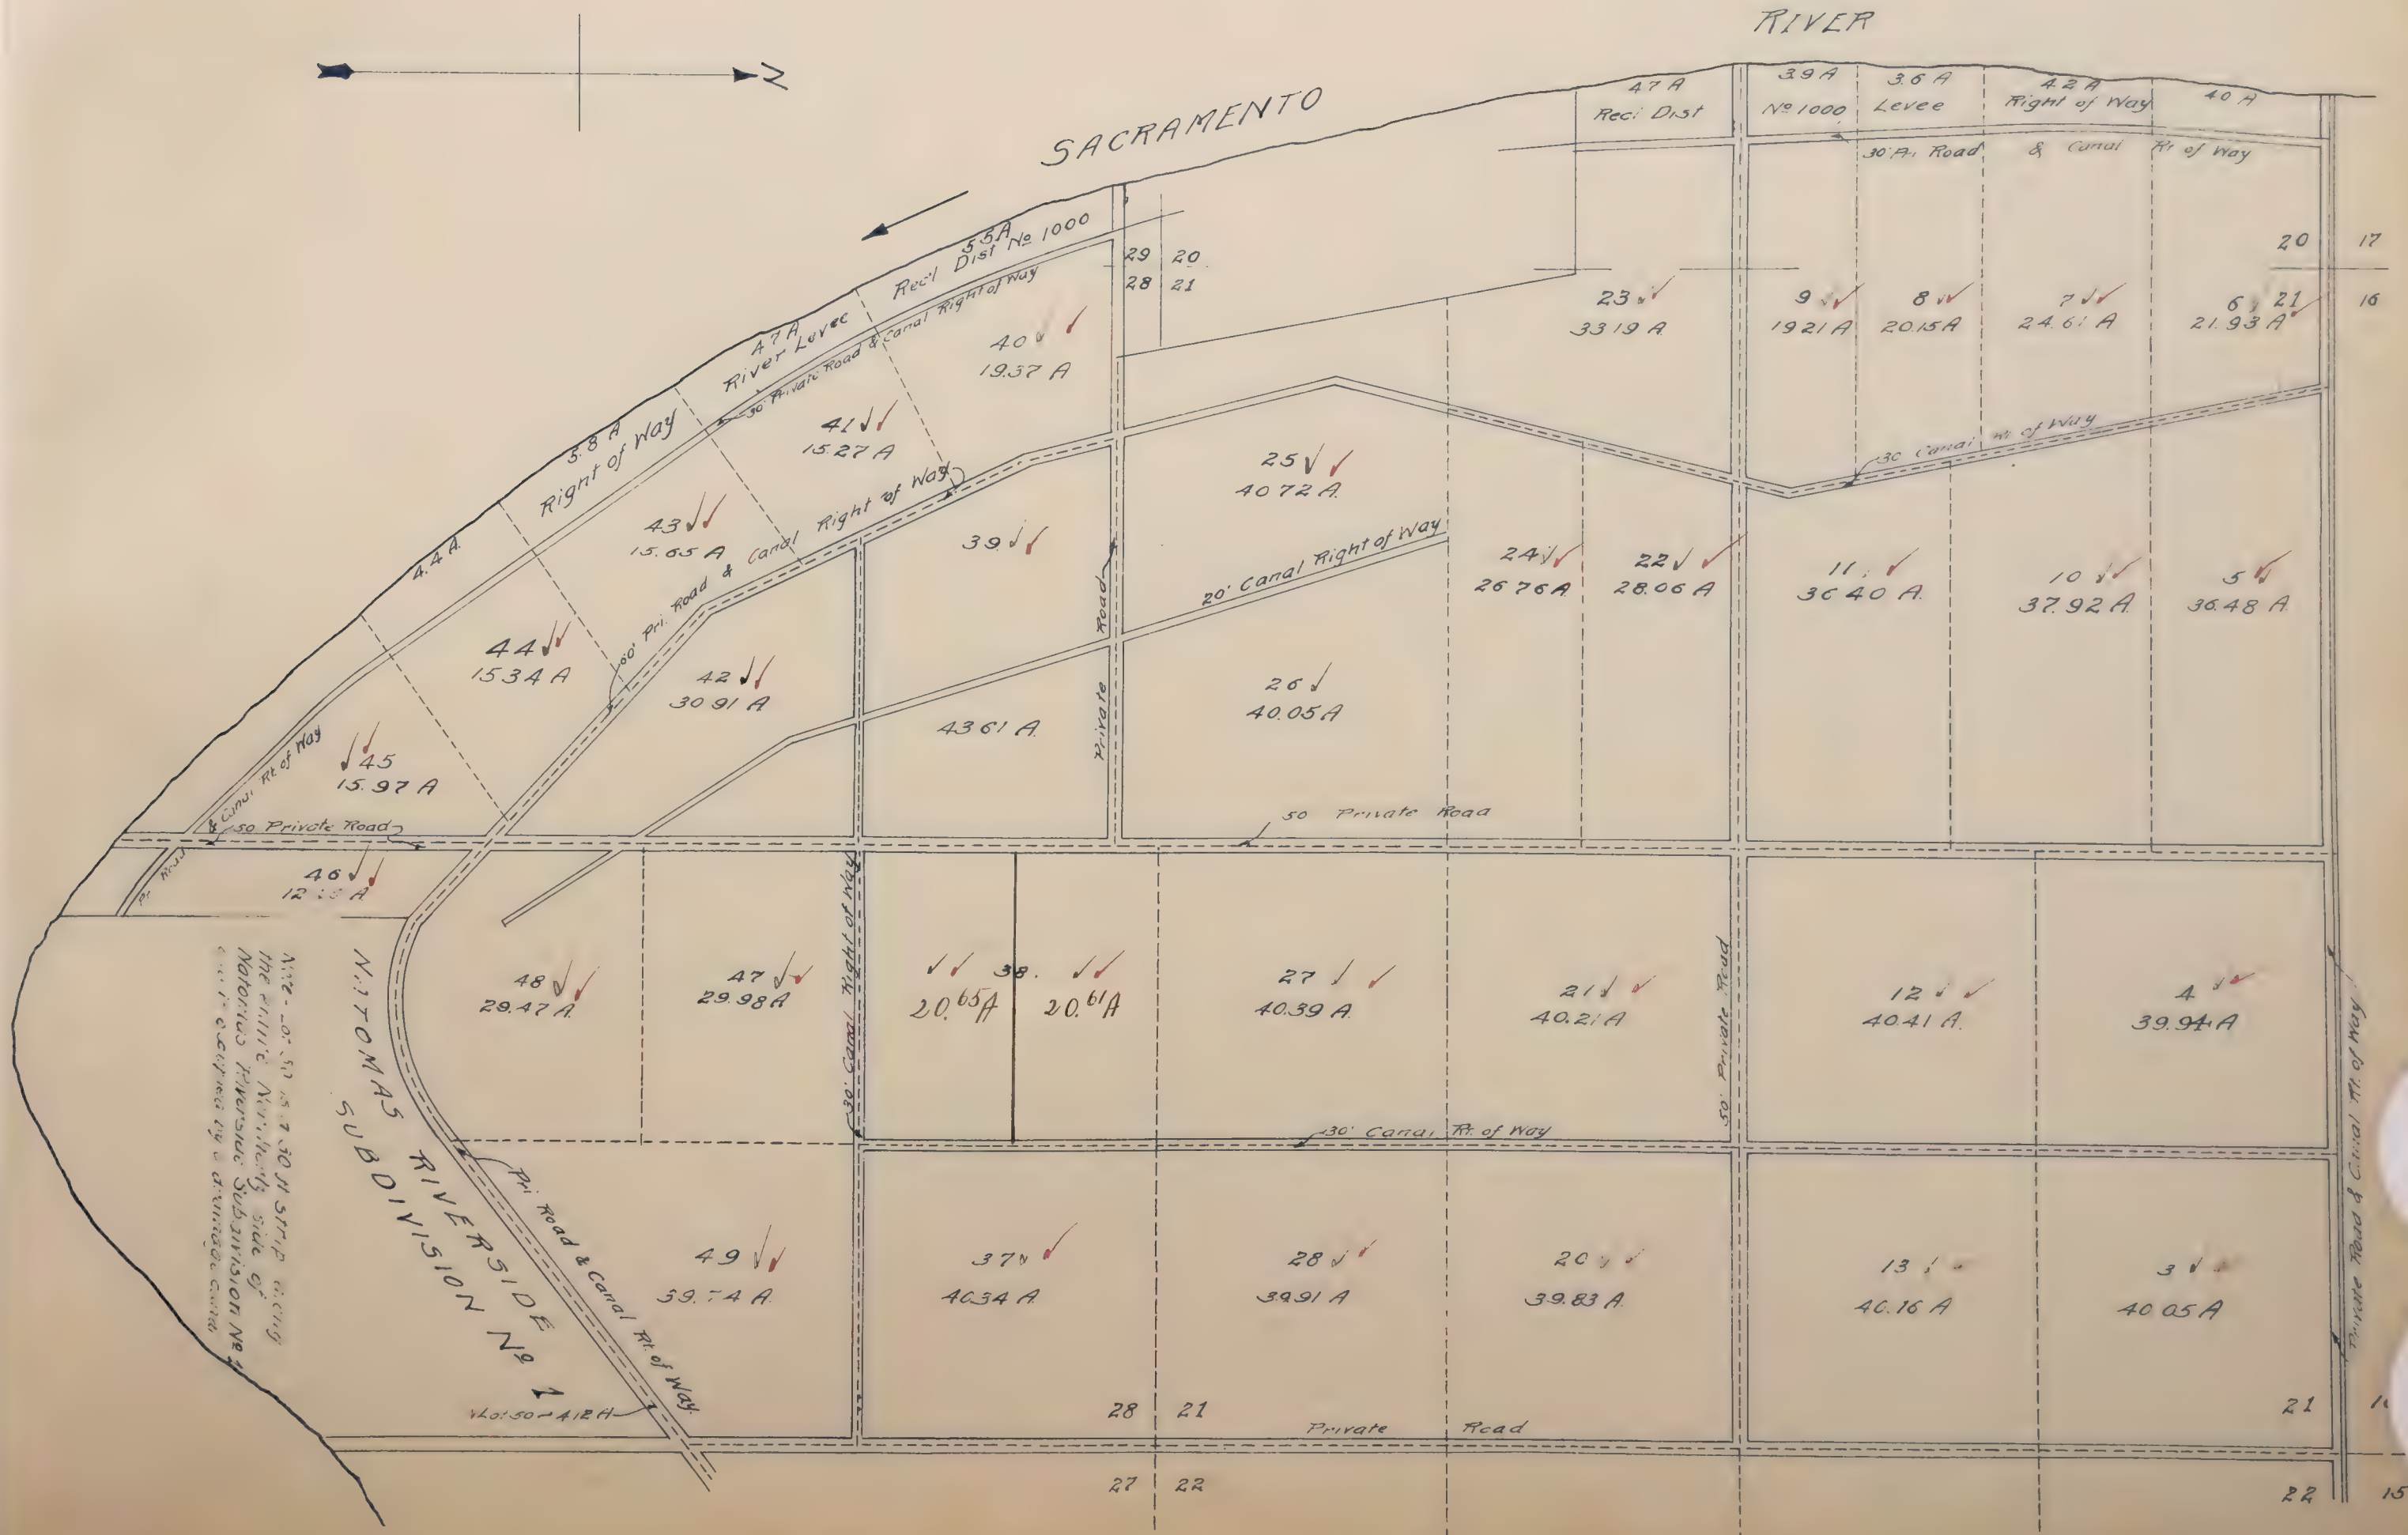

Black Ink-1919 Ownership
P. 1000

NATOMAS RIVERSIDE SUBDIVISION NO 2

Located in Secs. 20-21-22-23-28-29 T 9 N R 4 E

SHEET 2

Scale 1 inch = 600 feet

Blanks to Natomas Co. of Calif.

Jefferson P.D.



Mapped.

NEW GLENDALE
 location
 SW 1/4 Sec 20 T8N R5E
 Scale 1"=100'

Black Ink - 1919 Ownership
 Red Ink - 1920 Ownership

Pacific S.D.

Blanks assessed to F.G. Ames

COUNTY		ROAD	
1	2	37	38
3	✓✓	36	✓✓
4	✓✓	35	✓✓
5	✓✓	34	✓✓
6	✓✓	33	✓✓
7	✓✓	32	✓✓
8	✓✓	31	✓✓
9	✓✓	30	✓✓
10	✓✓	29	✓✓
11	✓✓	28	✓✓
12	✓✓	27	✓✓
13	✓✓	26	✓✓
14	✓✓	25	✓✓
15	✓✓	24	✓✓
16	✓✓	23	✓✓
17	✓✓	22	✓✓
18	✓✓	21	✓✓
19	✓✓	20	✓✓
		39	40
		41	✓✓
		42	✓✓
		43	✓✓
AVE.

MASCOT

AVE.

WARWICK

FRUIT RIDGE PARK

NEW PRAGUE

Black Ink-1910 Ownership
Red Ink-1910 Ownership

located in
Section 6 Rancho Del Paso
Scale: 1"=600 ft.

*Rio Linda
Oak Grove S.D.*

Blanks to Sacto. Suburban Fruit Lands Co
All Lots 10 Acres unless otherwise noted



Rio Linda

Mapped
NEW RAMONA.
LOCATED IN
SECTION 15 T 8 N R 5 E

Scale 4 chains = 1 inch
Black Ink - 1910 Ownership
Red - 1910 Ownership

Junction S D



NICHOLS PARK

LOCATED IN


N.W. 1/4 of Section 20, T.8 N.R.5E.

Scale: 1"=100'

Black Ink-1919 Ownership
Red Ink-1920 Ownership

Fruit Ridge S.D.

Blanks assessed to *E.A. Theile; B.F. Driver and W.T. Foster*
E.A. Theile; B.F. Driver and D.M. Stotts

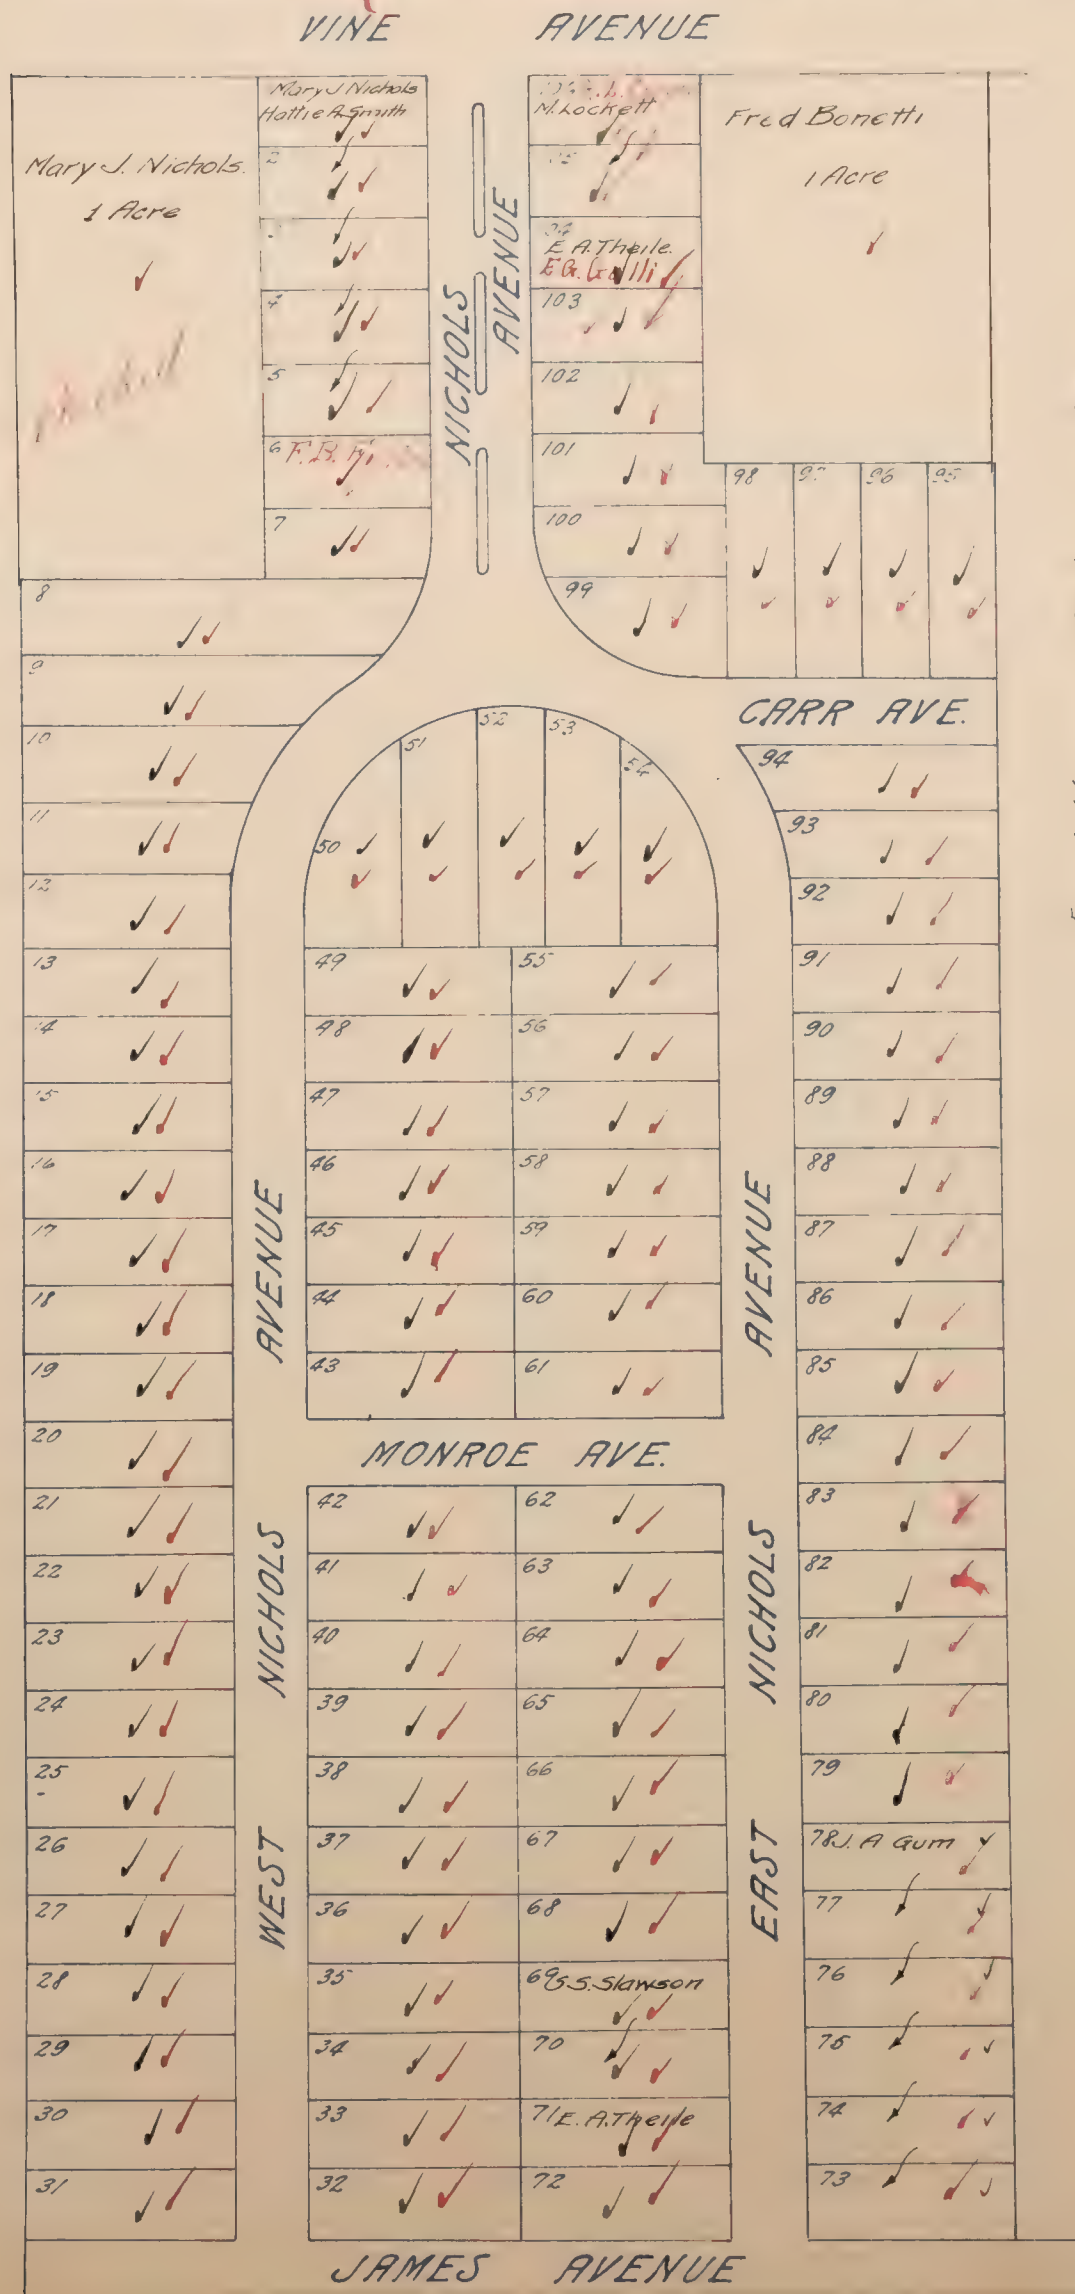

East Nichols Park 19 Acres.

Mapper

NORTH SACRAMENTO HEIGHTS










LOCATED IN
SE ¼ of Sec. 12 & S.W. ¼ of Sec. 17 of Rancho Del Paso

Scale 1 in = 100 ft.

N.S.L. Co.

Black Ink - 1919 Ownership
Red Ink - 1920 Ownership

Del Paso Ab. 1.0

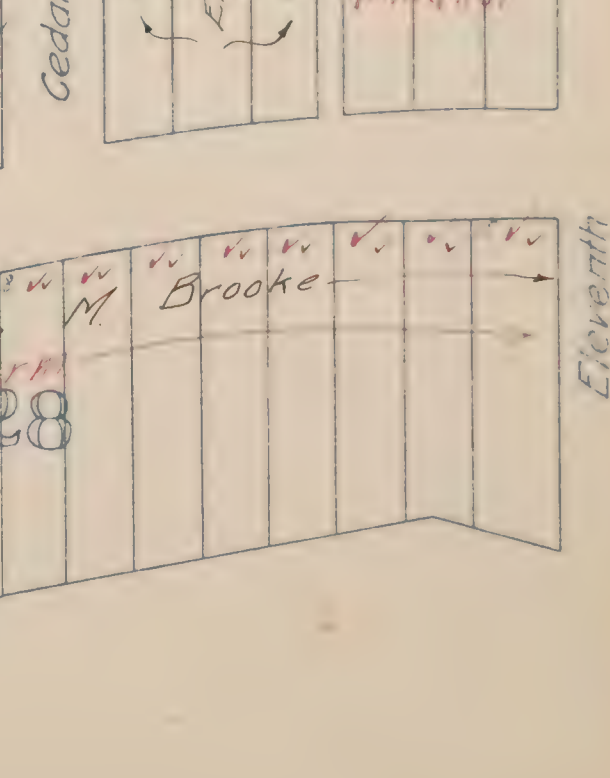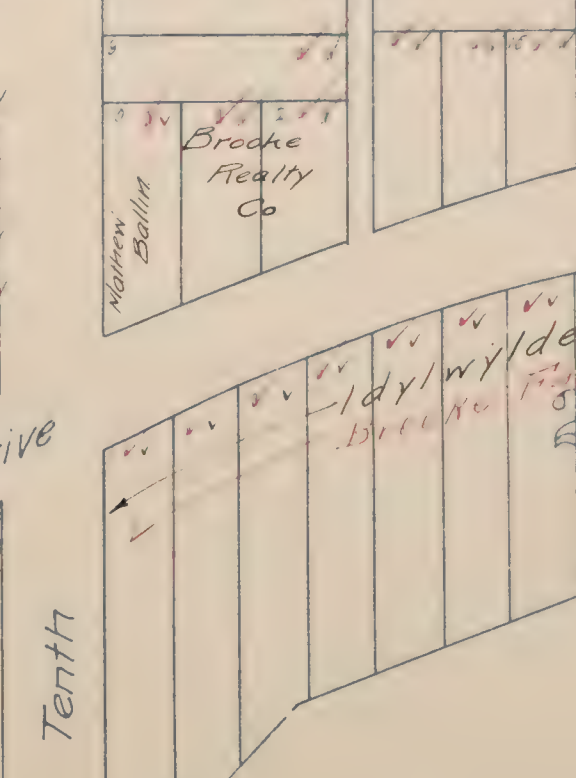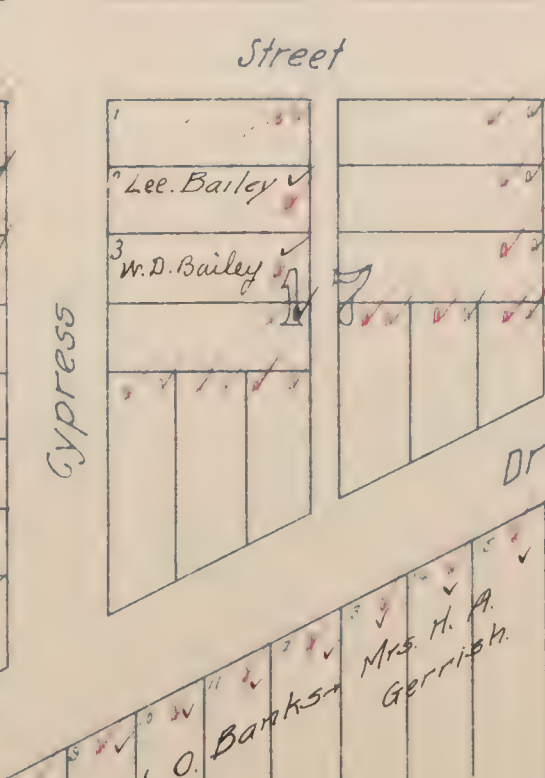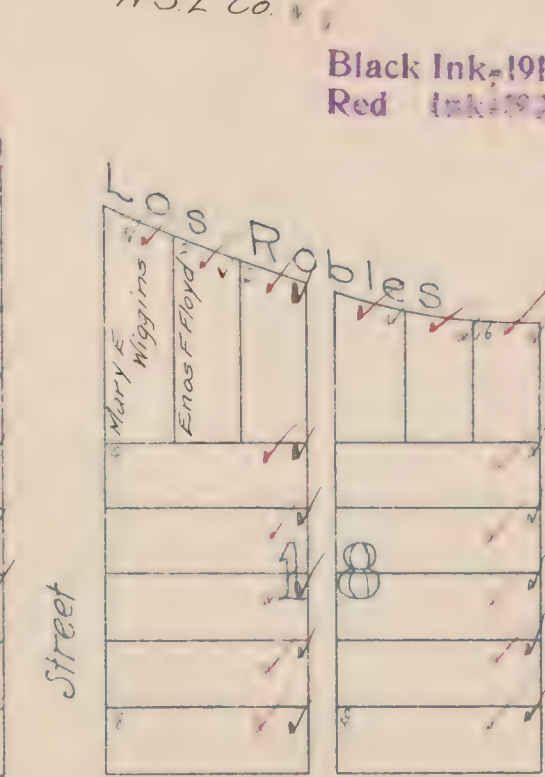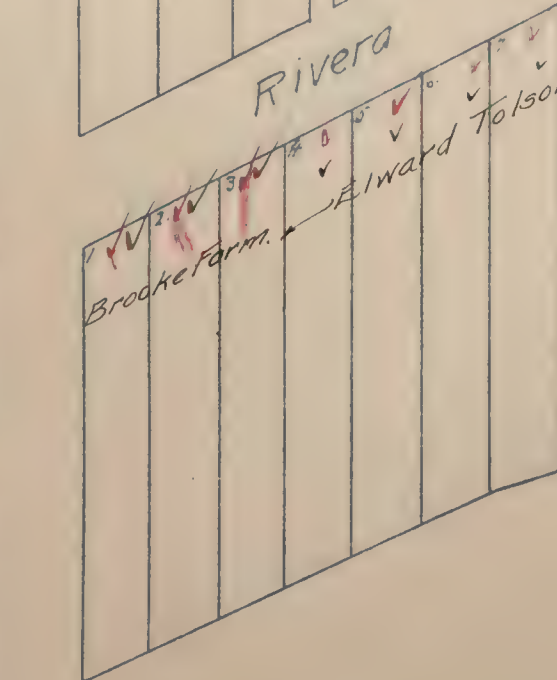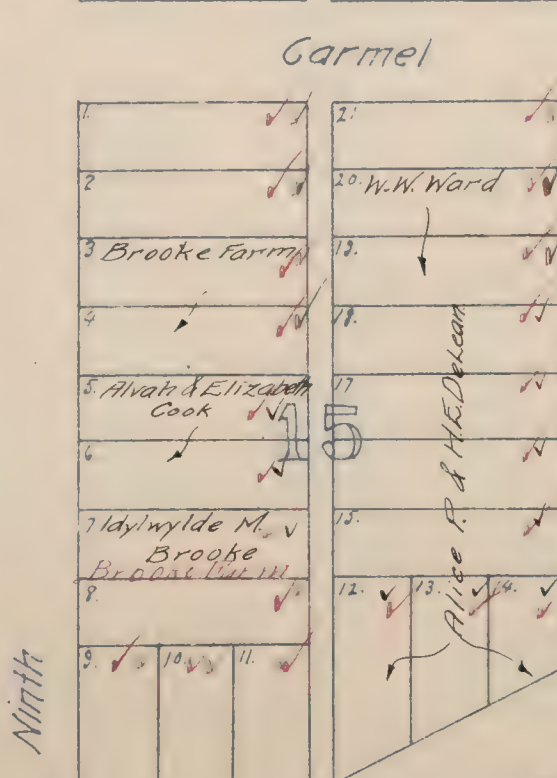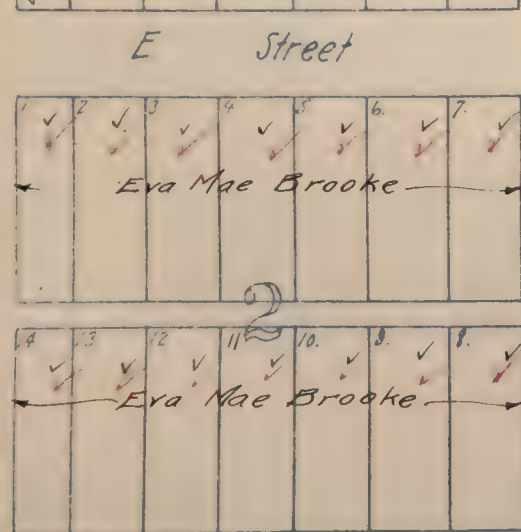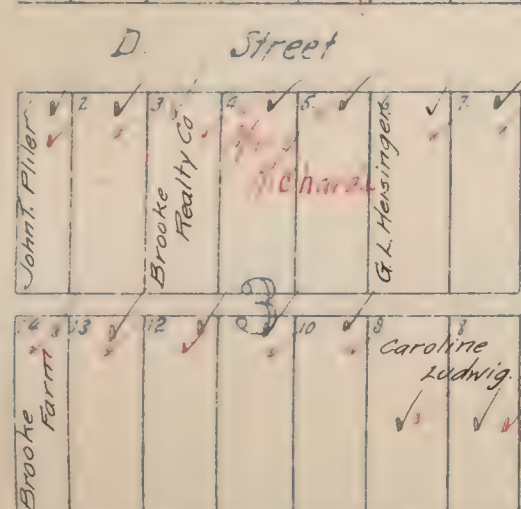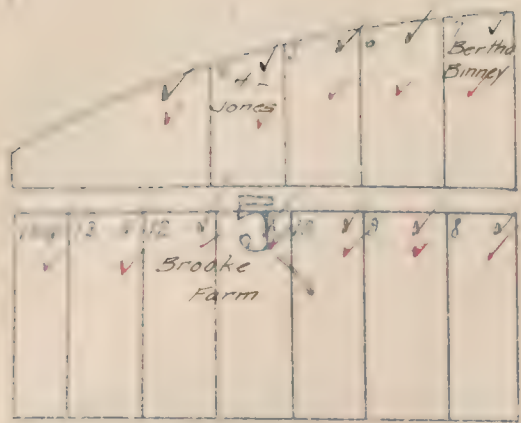

N. Sac. Hgts.

Eleventh

Black Is Not Ownership Red Is Not Ownership

LOCATED IN
Sec's 46, 52, & 53 of Rancho Del Paso
Scale: 1 inch = 100 feet.

N. S. L. Co. ✓

1st Pass. Hts. S. D.
 7000 ft. - 10
 7000 ft. - 10



Black Ink - 1919 Ownership
Red Ink - 1920 Ownership

NORTH SACRAMENTO HEIGHTS

LOCATED IN

S.E. 1/4 of Sec. 12 & S.W. 1/4 of Sec. 17 of Rancho Del Paso

Scale = 1 in. = 100 ft.

N. S. L. Co. ✓✓

Del Paso Hts. 10.
American S.H.
Trade 50

South


Avenue



NORTH SACRAMENTO HEIGHTS

LOCATED IN
Sec's 46, 52, & 53, of Rancho Del Paso
Scale 1 inch = 100 feet









American S.D.
Arcade S.D.

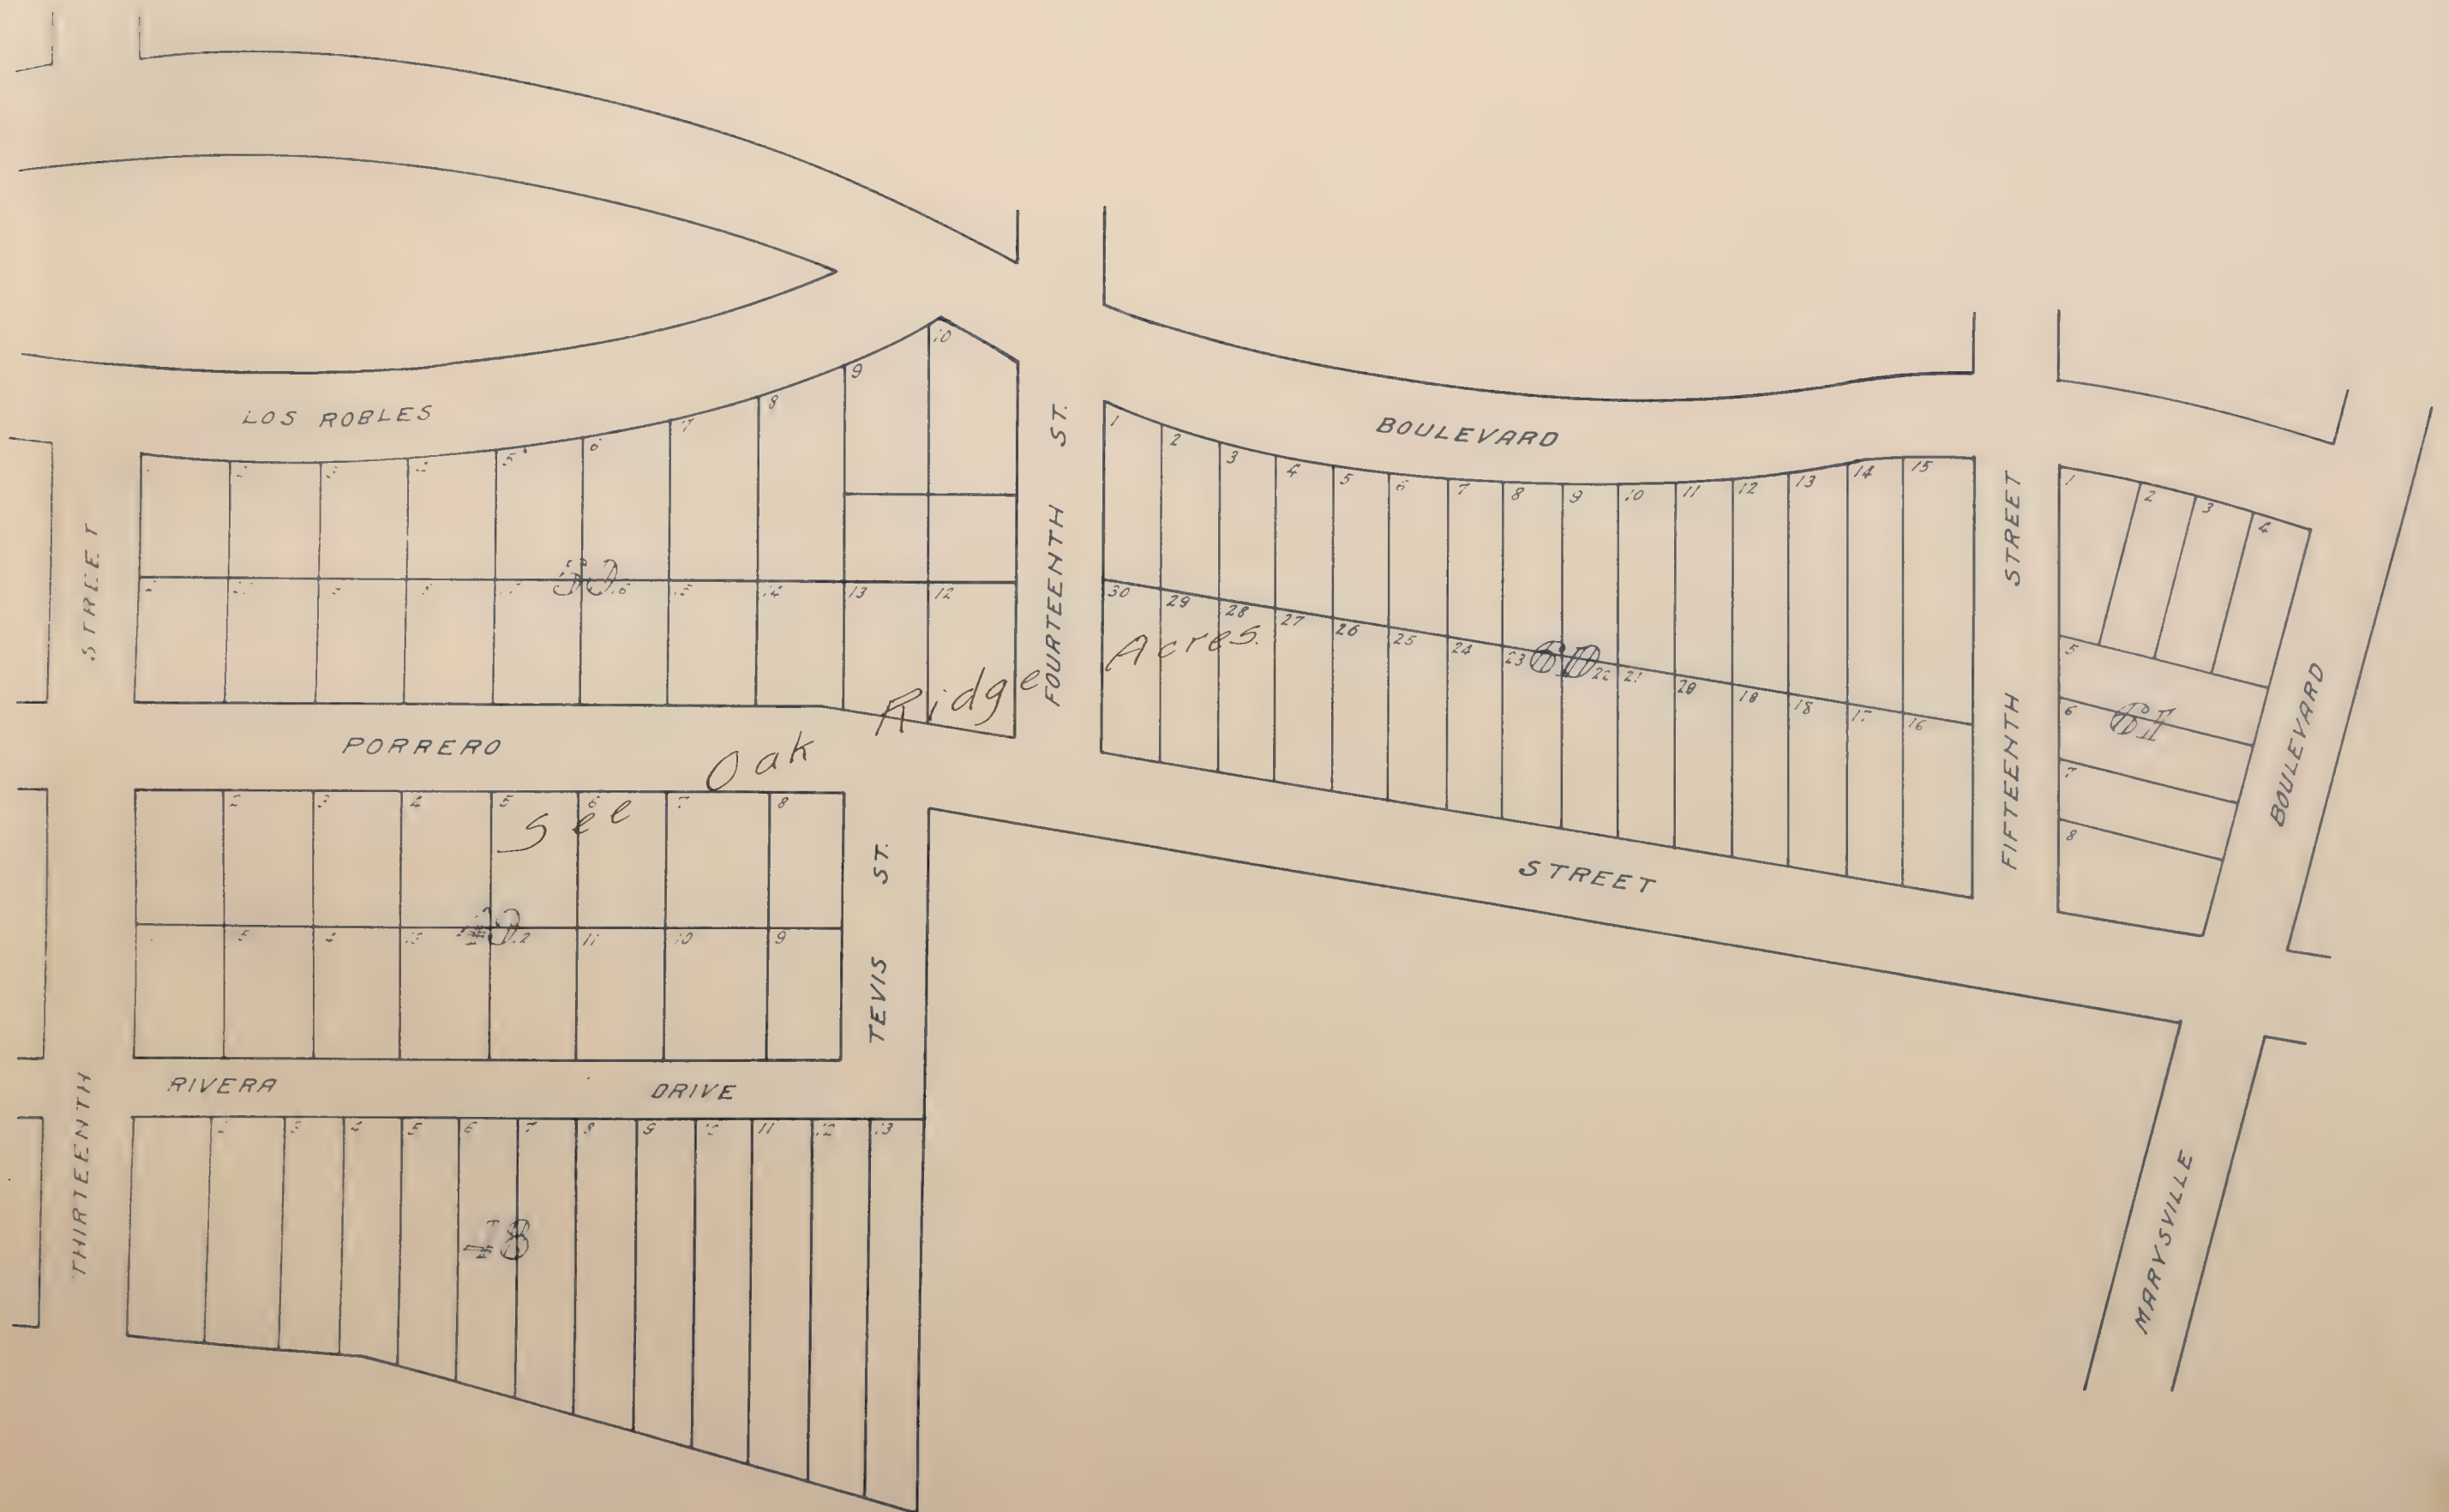

NORTH SACRAMENTO HEIGHTS

LOCATED IN
S.E. 1/4 of Sec. 12 & S.W. 1/4 of Sec. 17 of Rancho Del Paso
Scale = 1 in = 100 ft.


American S.D.
Arcade S.D.

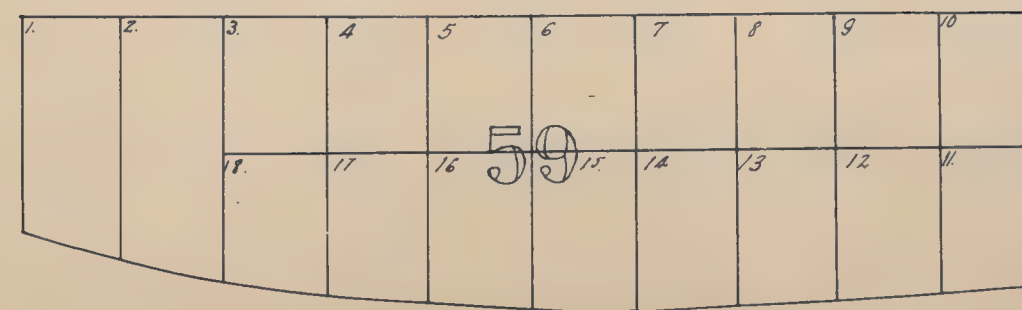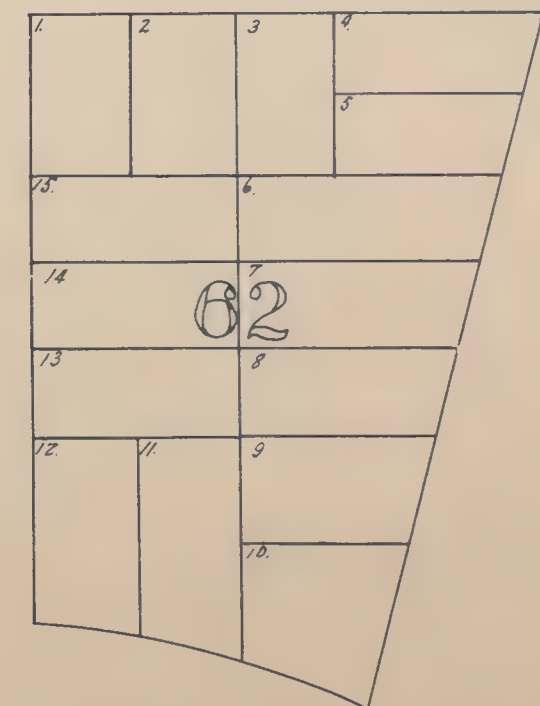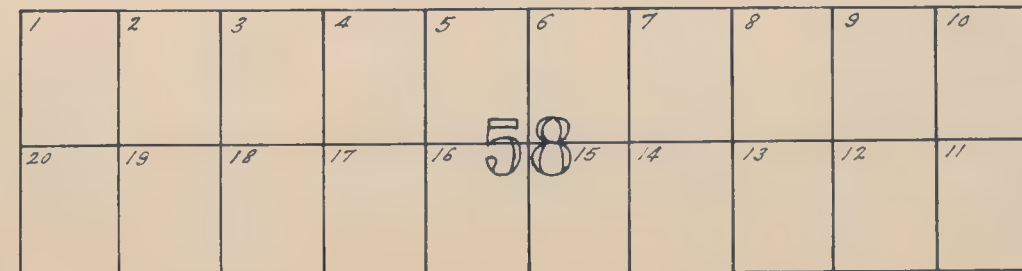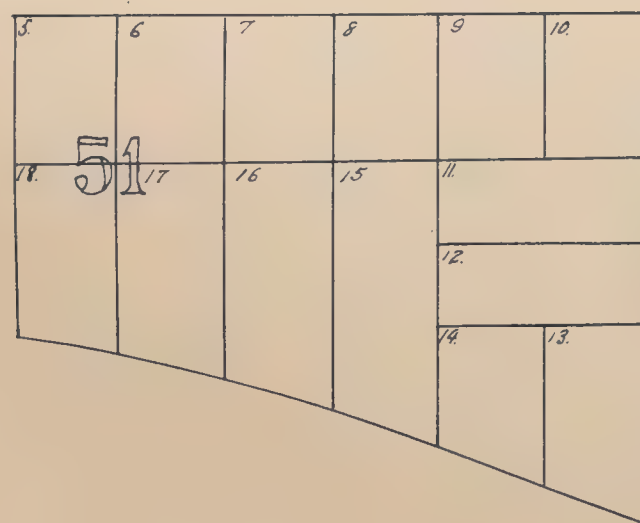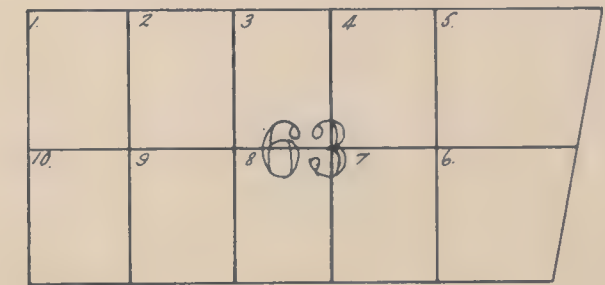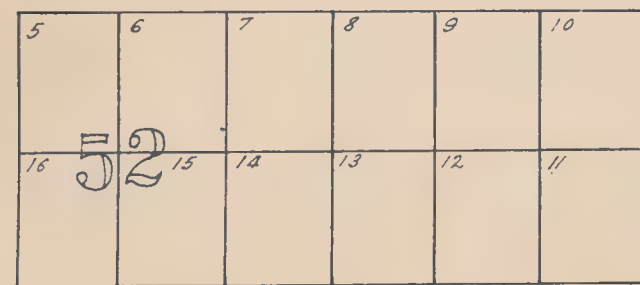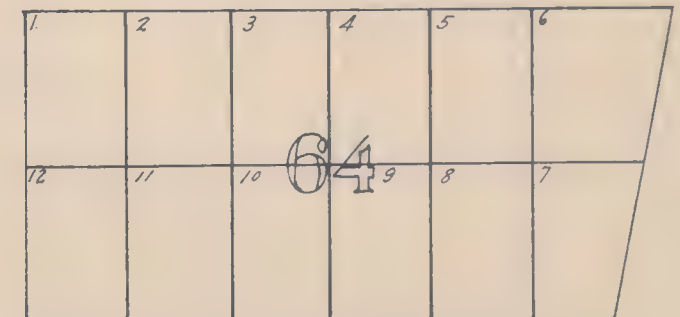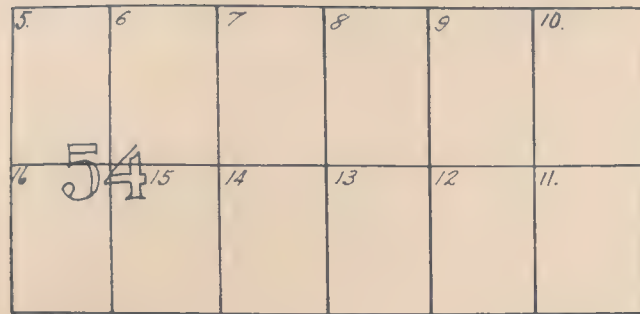

Black Ink-1919 Ownership
Red Ink-1920 Ownership

North. Sect. 1st.

all blanks below assessed to North Sac Land Co. v.

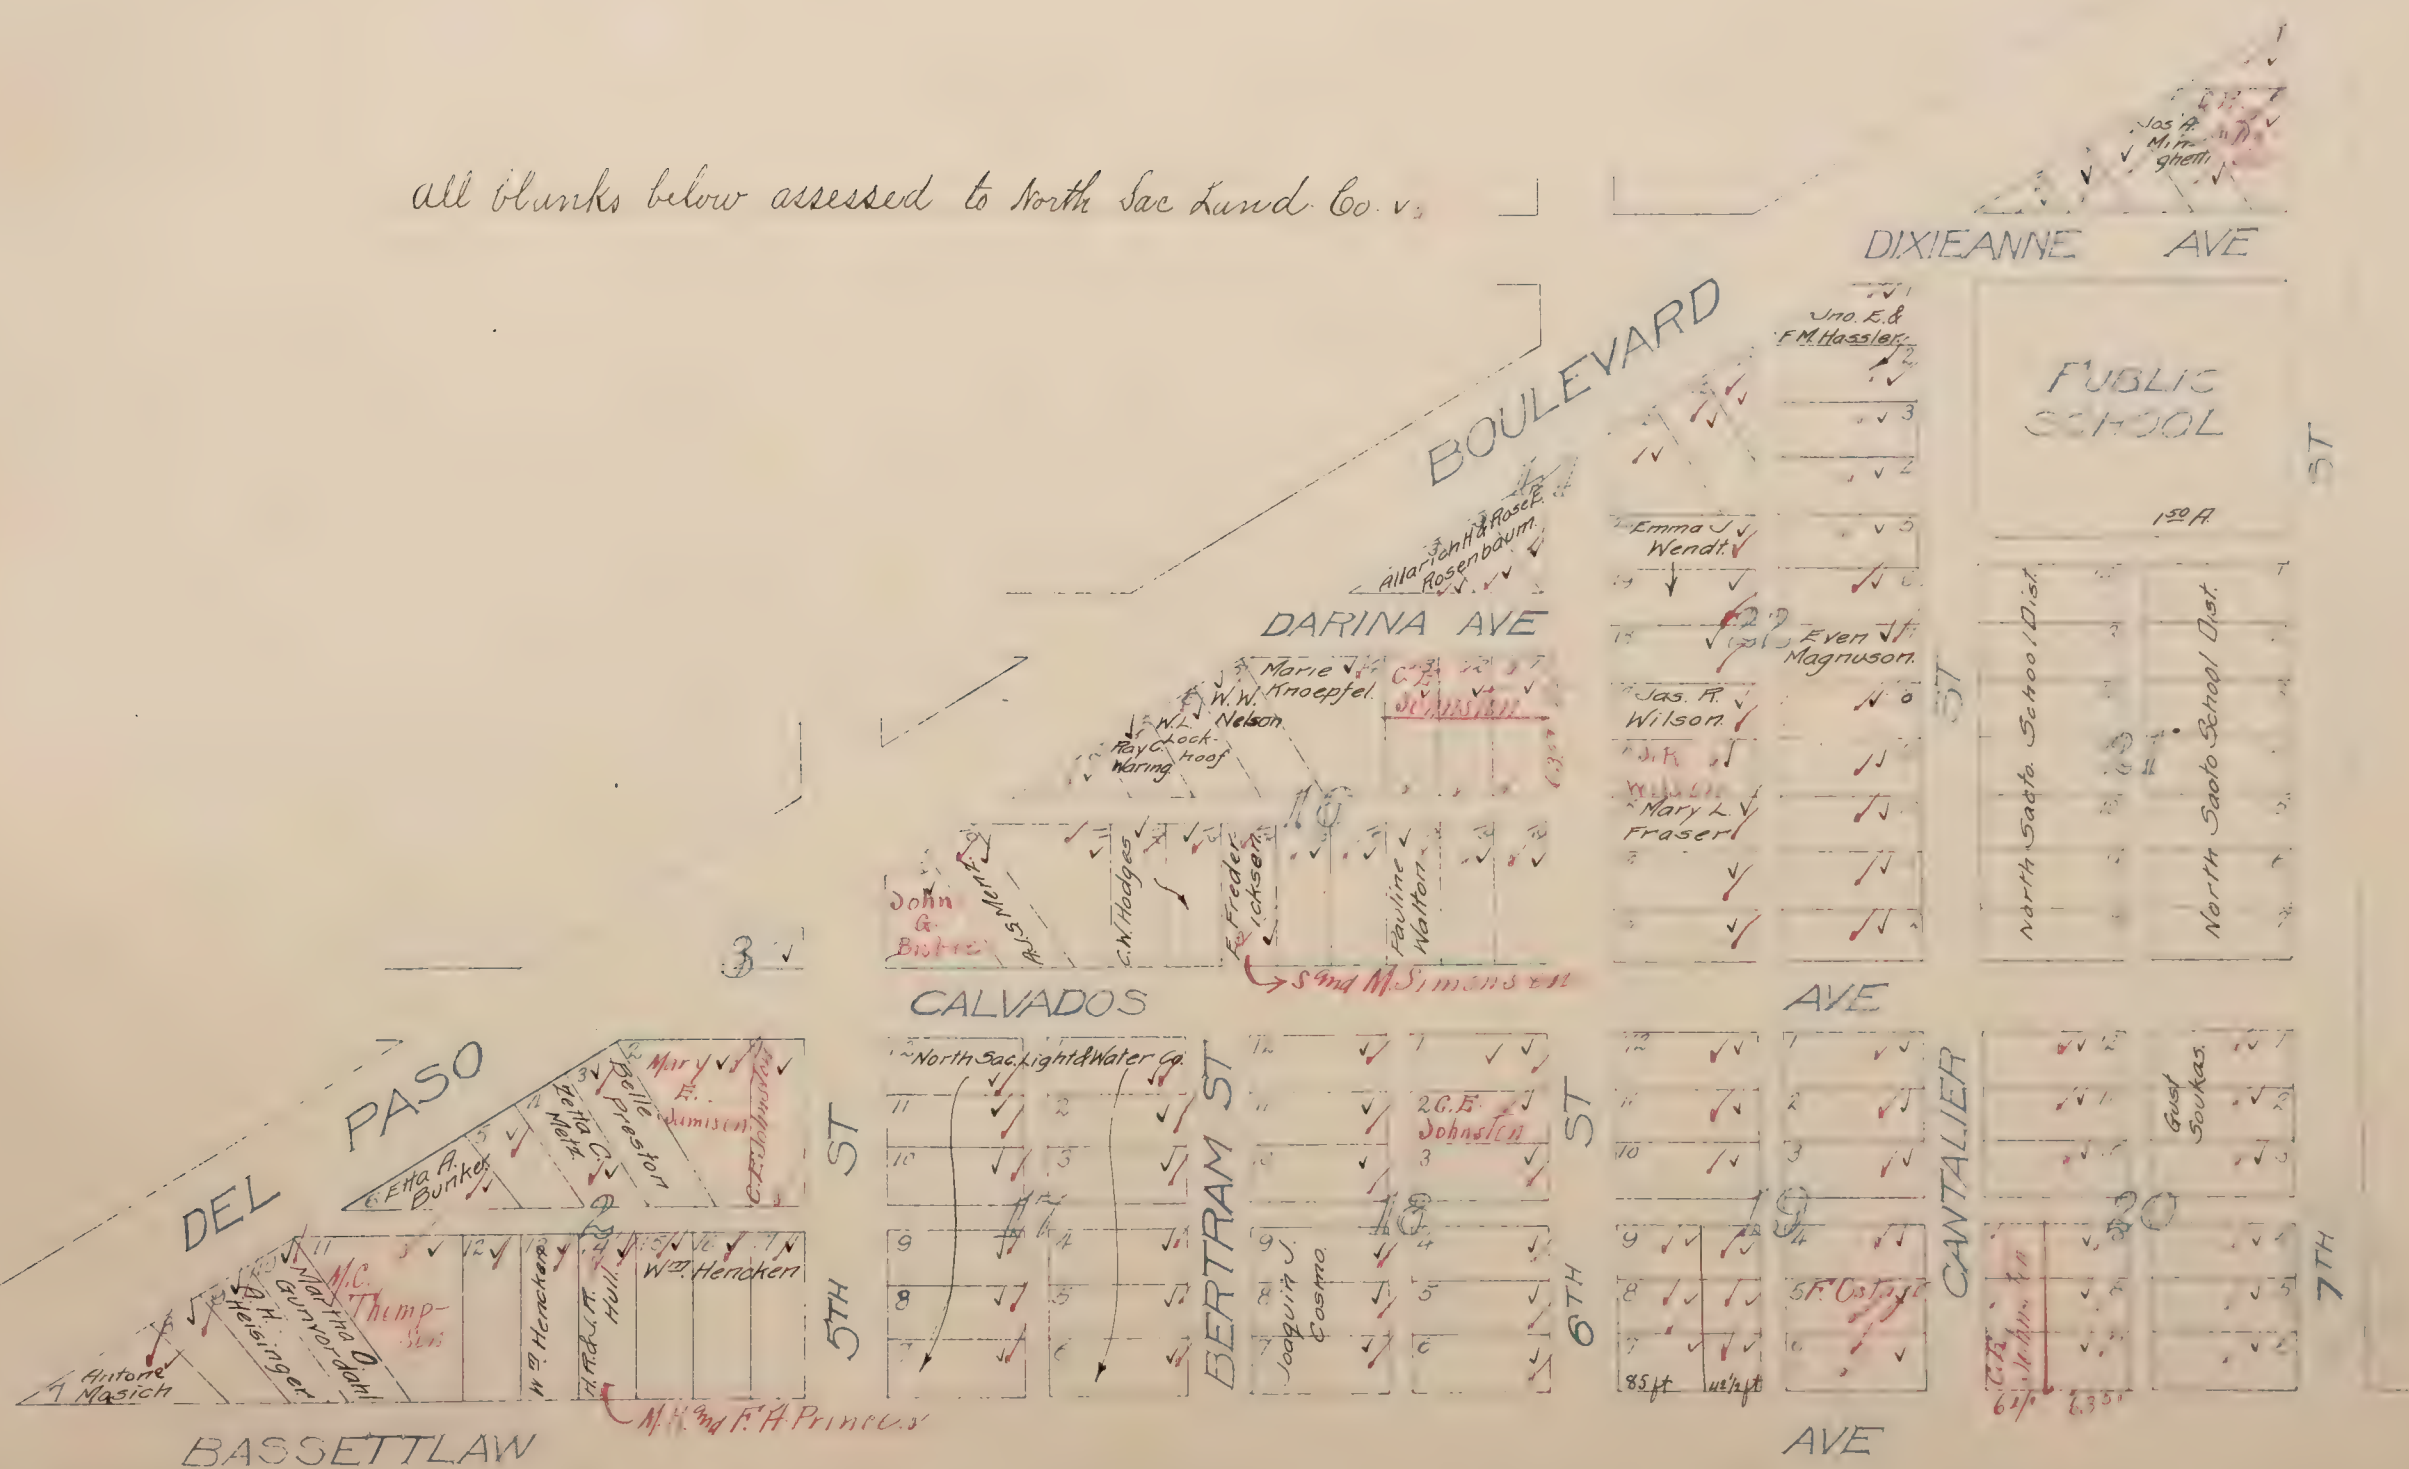

NORTH SACRAMENTO SUBDN NO.1

LOCATED IN

Sec's 1, 2, 13, 14, 15, & 16. Ranch Del Paso

Scale: 150' Black Ink-1919 Ownership
Red Ink-1920 Ownership

h. Sacto




Mapped.

NORTH SACRAMENTO SUBDN NO.1

LOCATED IN
Secs 12 13 14 15 16 Rancho Del Paso.

Scale 300'

Black Ink-1919 Ownership
Red Ink-1929 Ownership

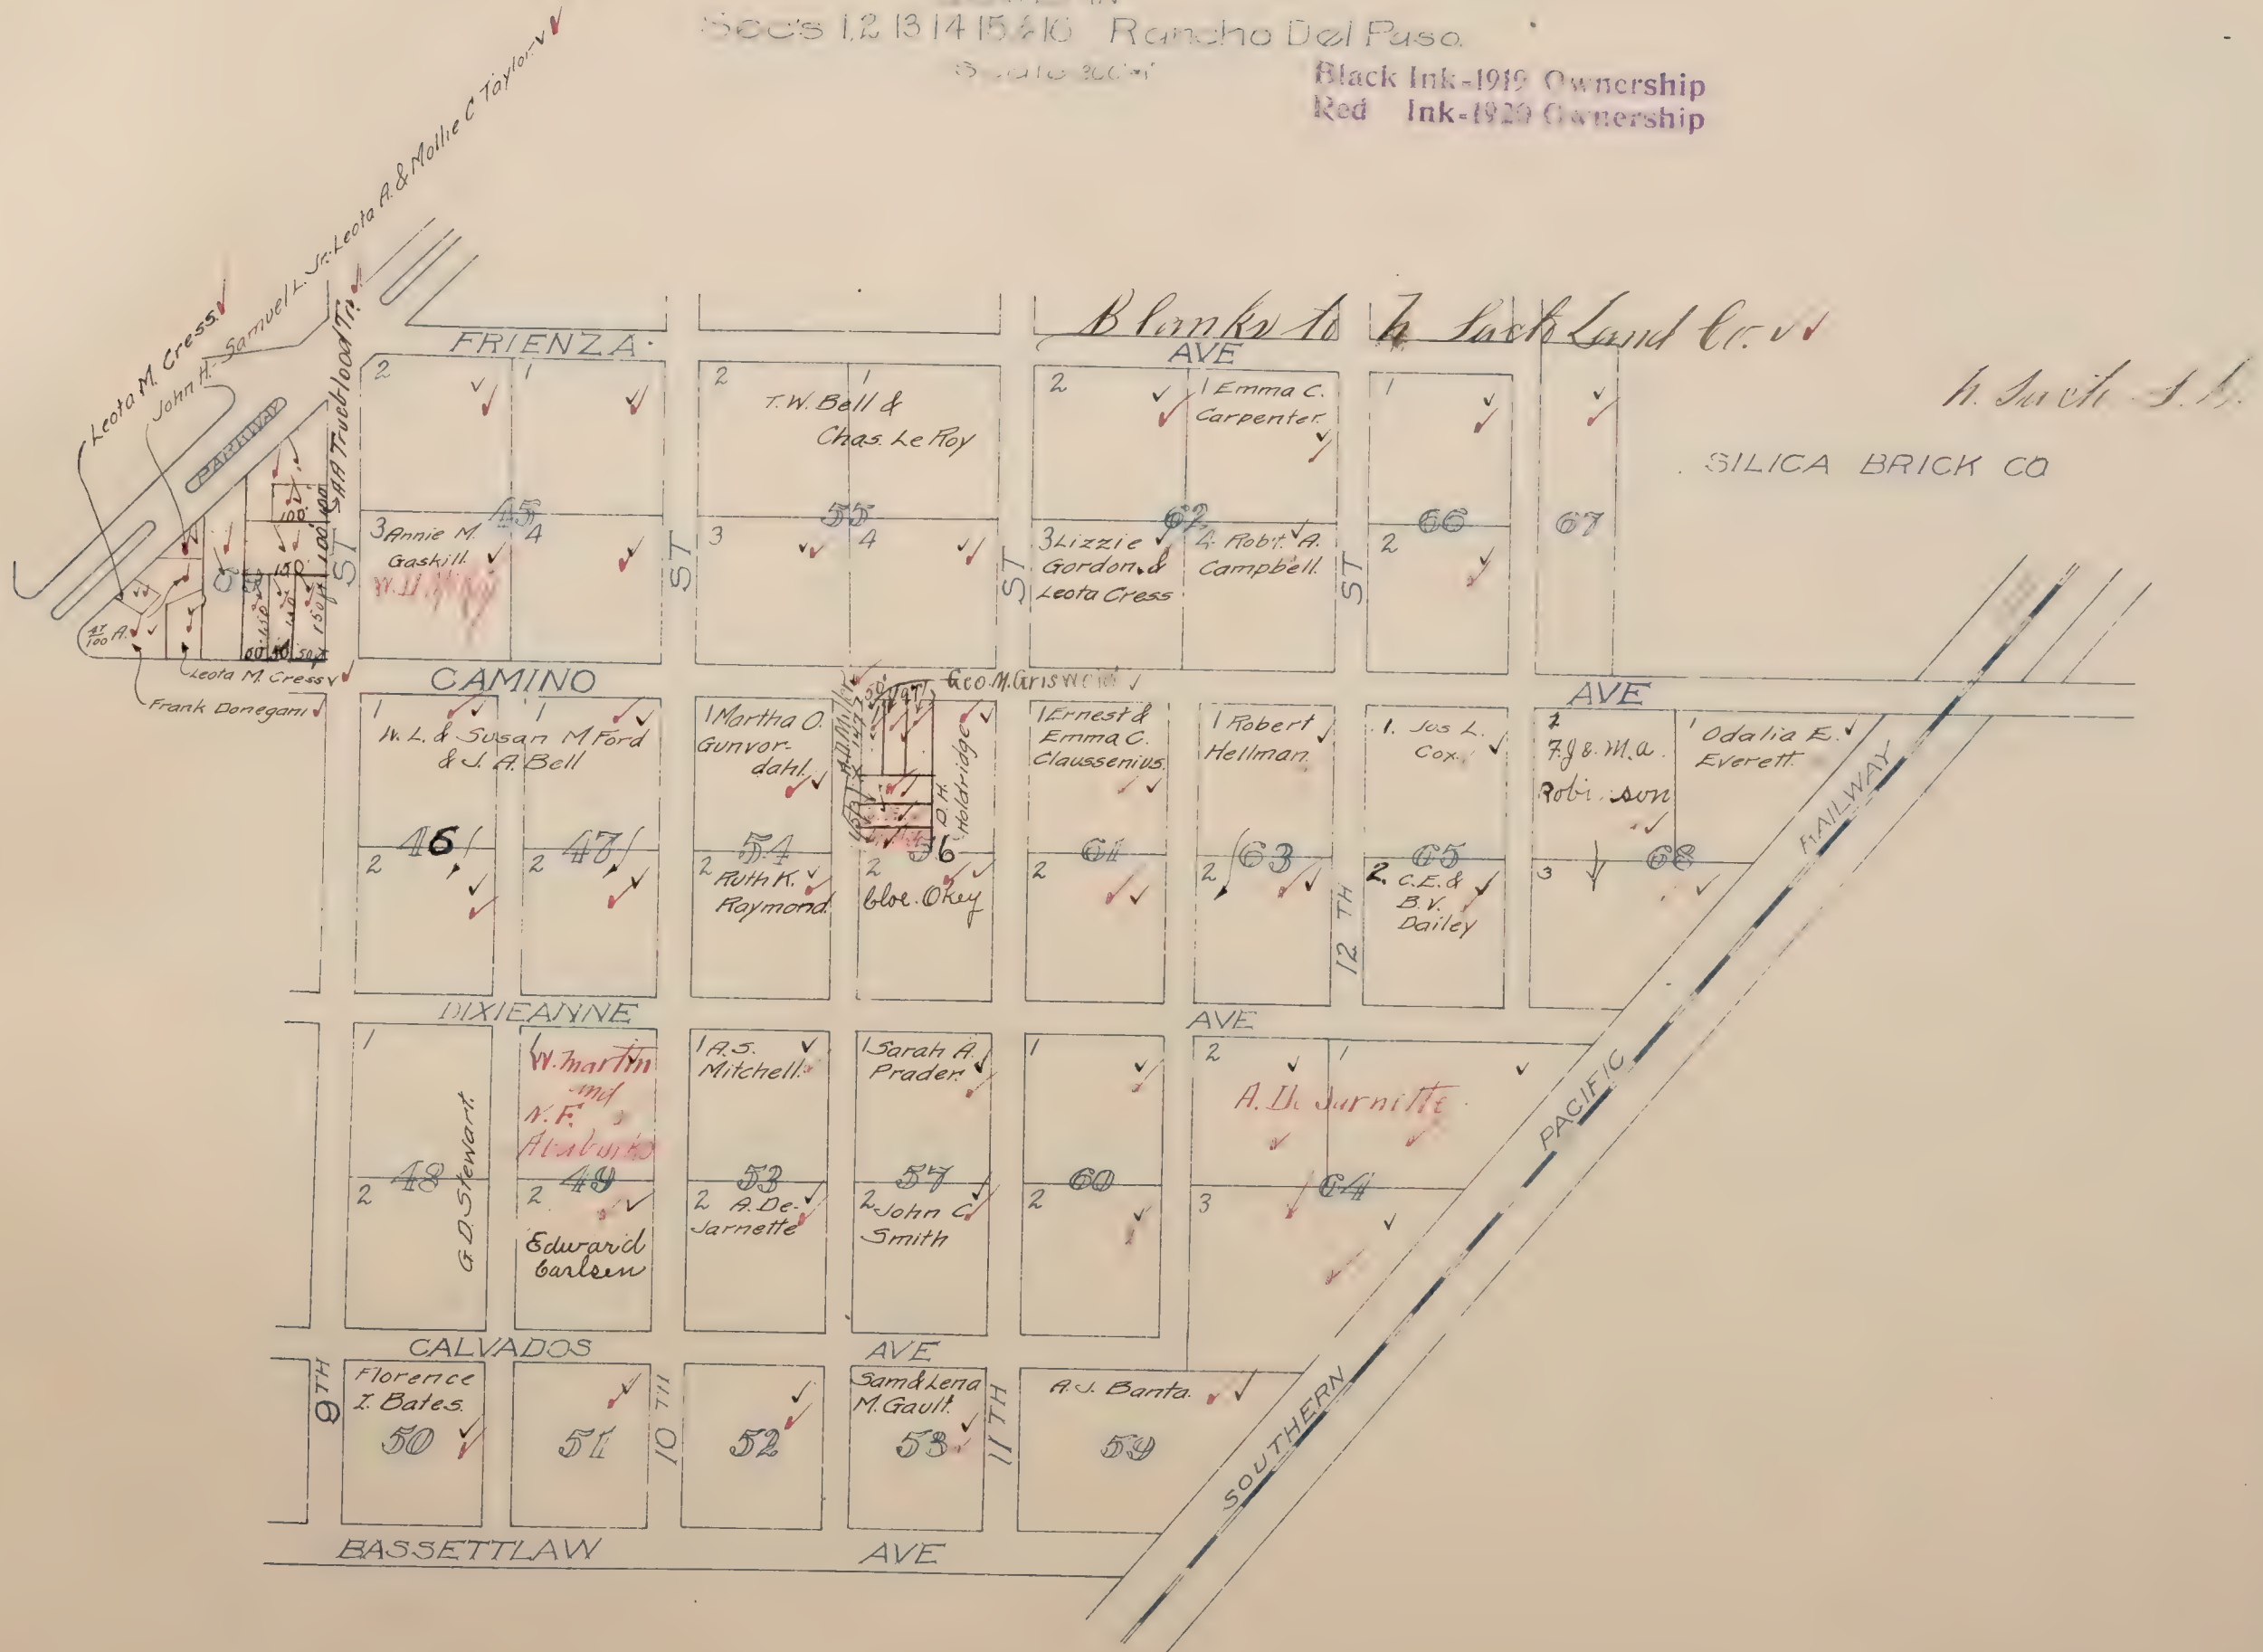

Mapped.


Black Ink-1919 Ownership
Red Ink-1920 Ownership

NORTH SACRAMENTO SUBDN NO.2

LOCATED IN
Sec. 15. Rancho Del Paso
Scale 200'=1"

N. S. L. Co. ✓✓

N. Sacto Land Co. ✓✓

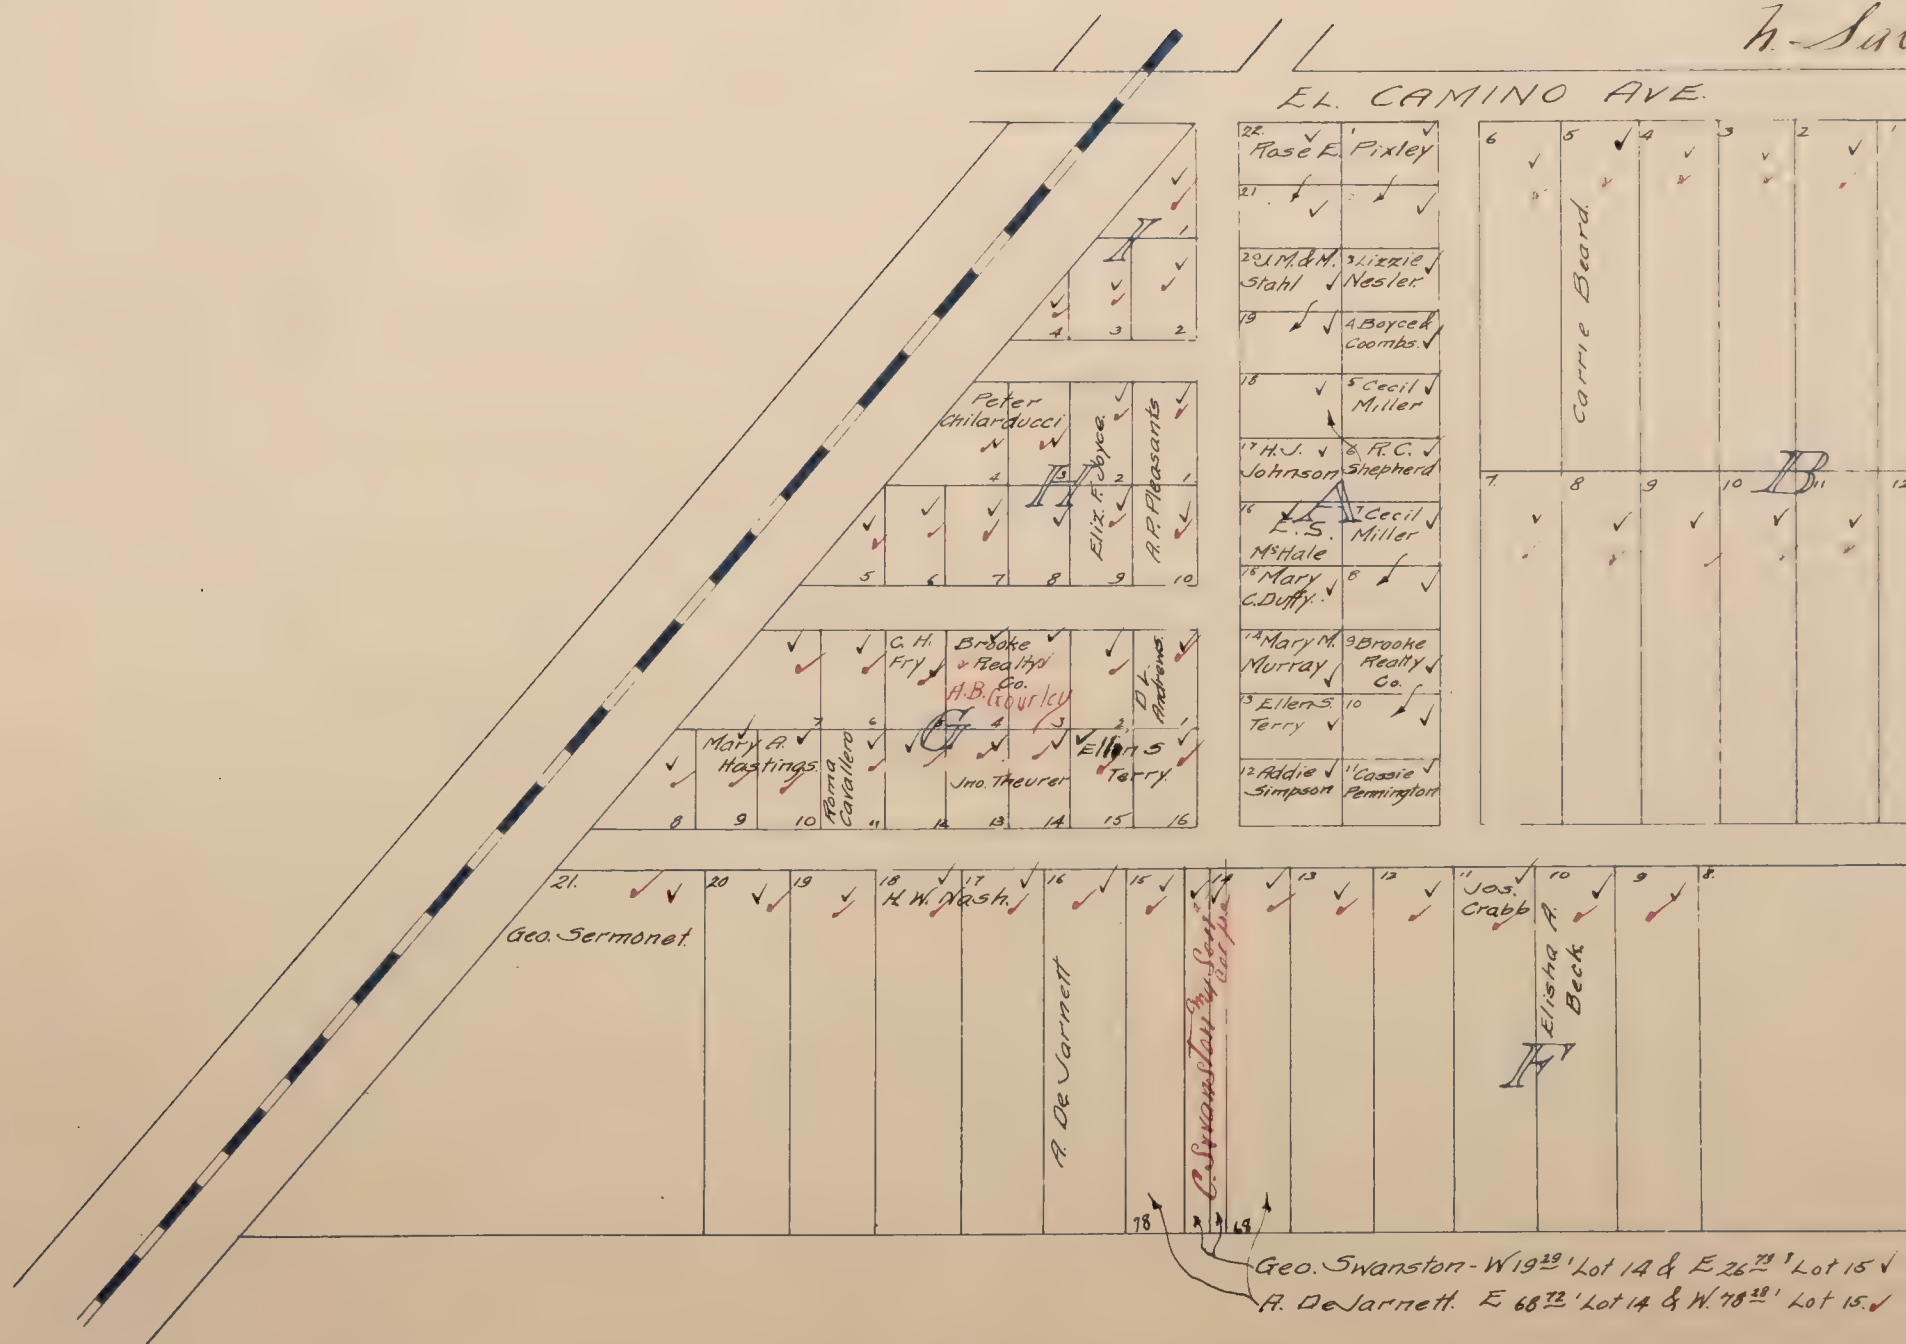


Black Ink-1919 Ownership
Red Ink-1929 Ownership

NORTH SACRAMENTO SUBDN NO.2

LOCATED IN
Sec. 15. Rancho Del Paso.
Scale 300'=1"

Sacramento Land Co. ✓✓

H. Sack S.D.

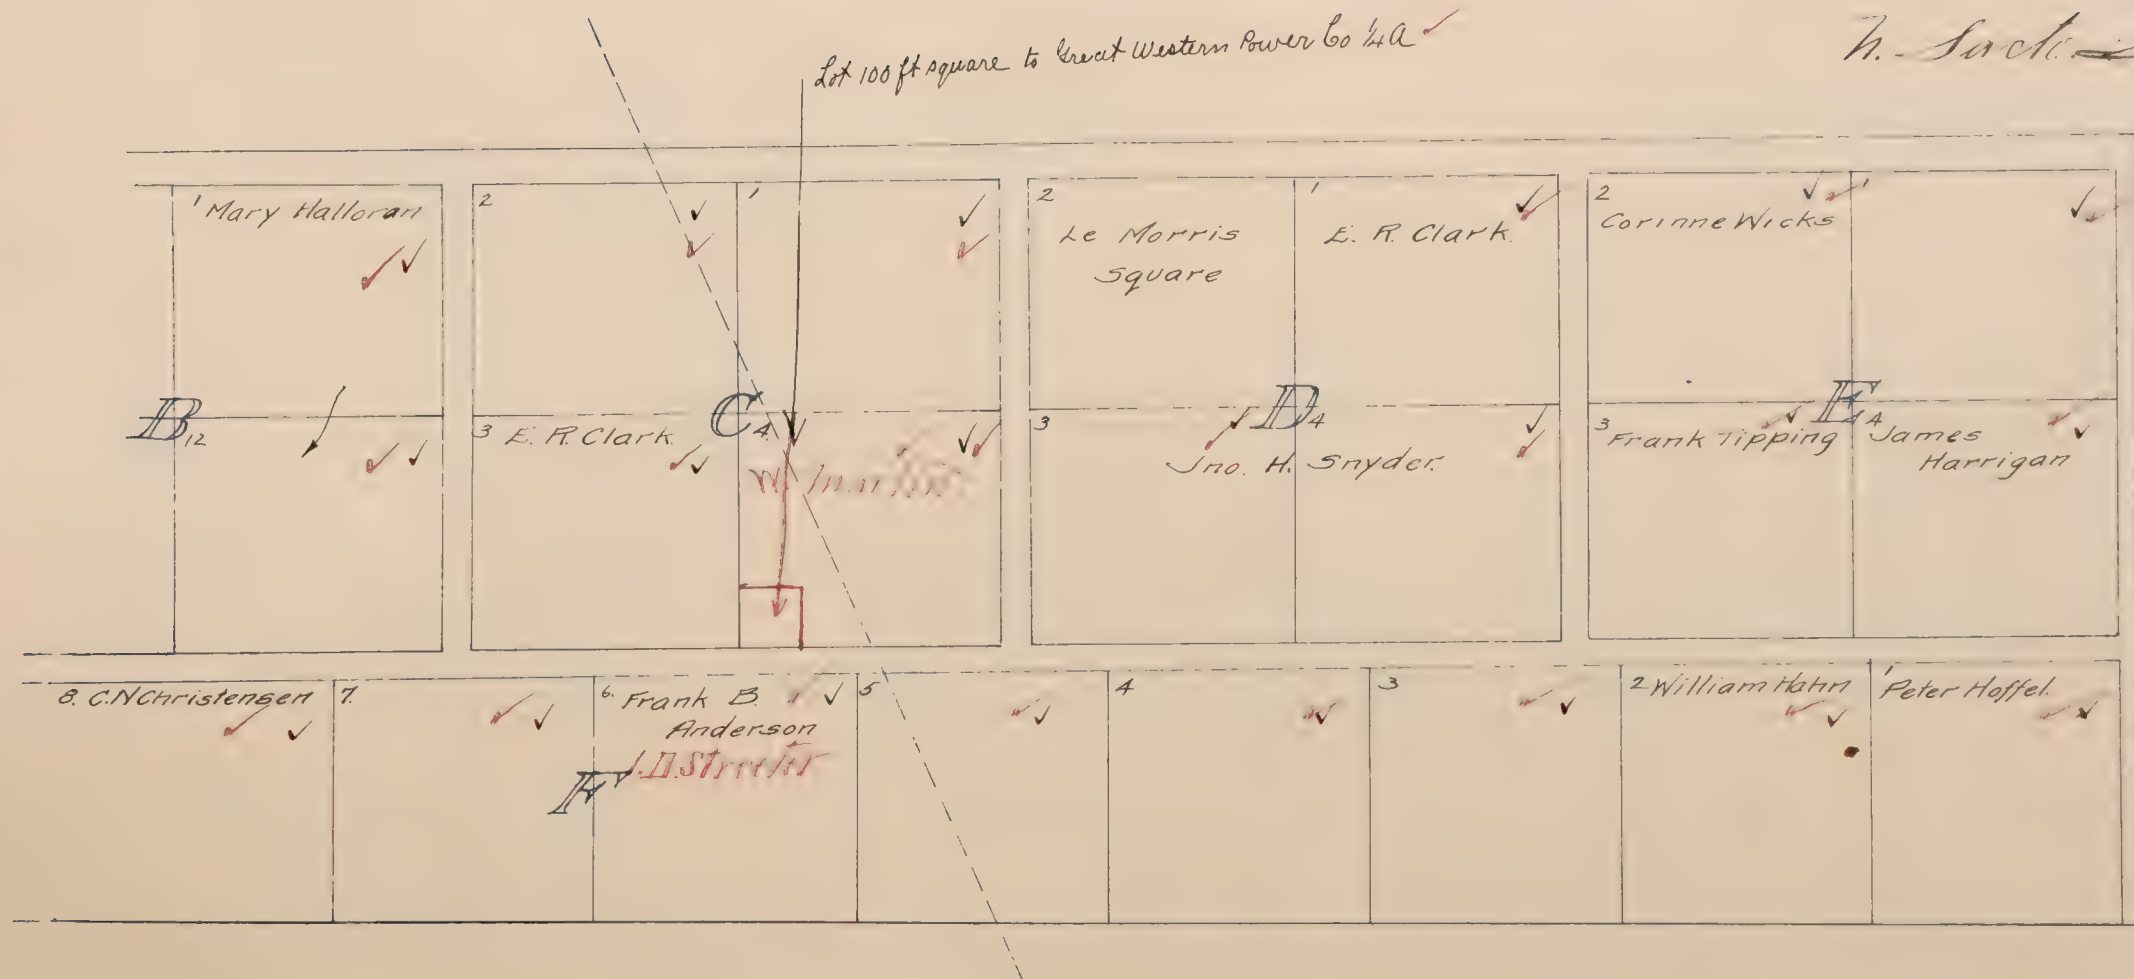

Black Ink-1919 Ownership
Red Ink-1929 Ownership


NORTH SACRAMENTO SUBDN NO.3

7. Sect. 10.

LOCATED IN
Rancho Del Paso

Scale 200' = 1"

N.S. L. Co. ✓

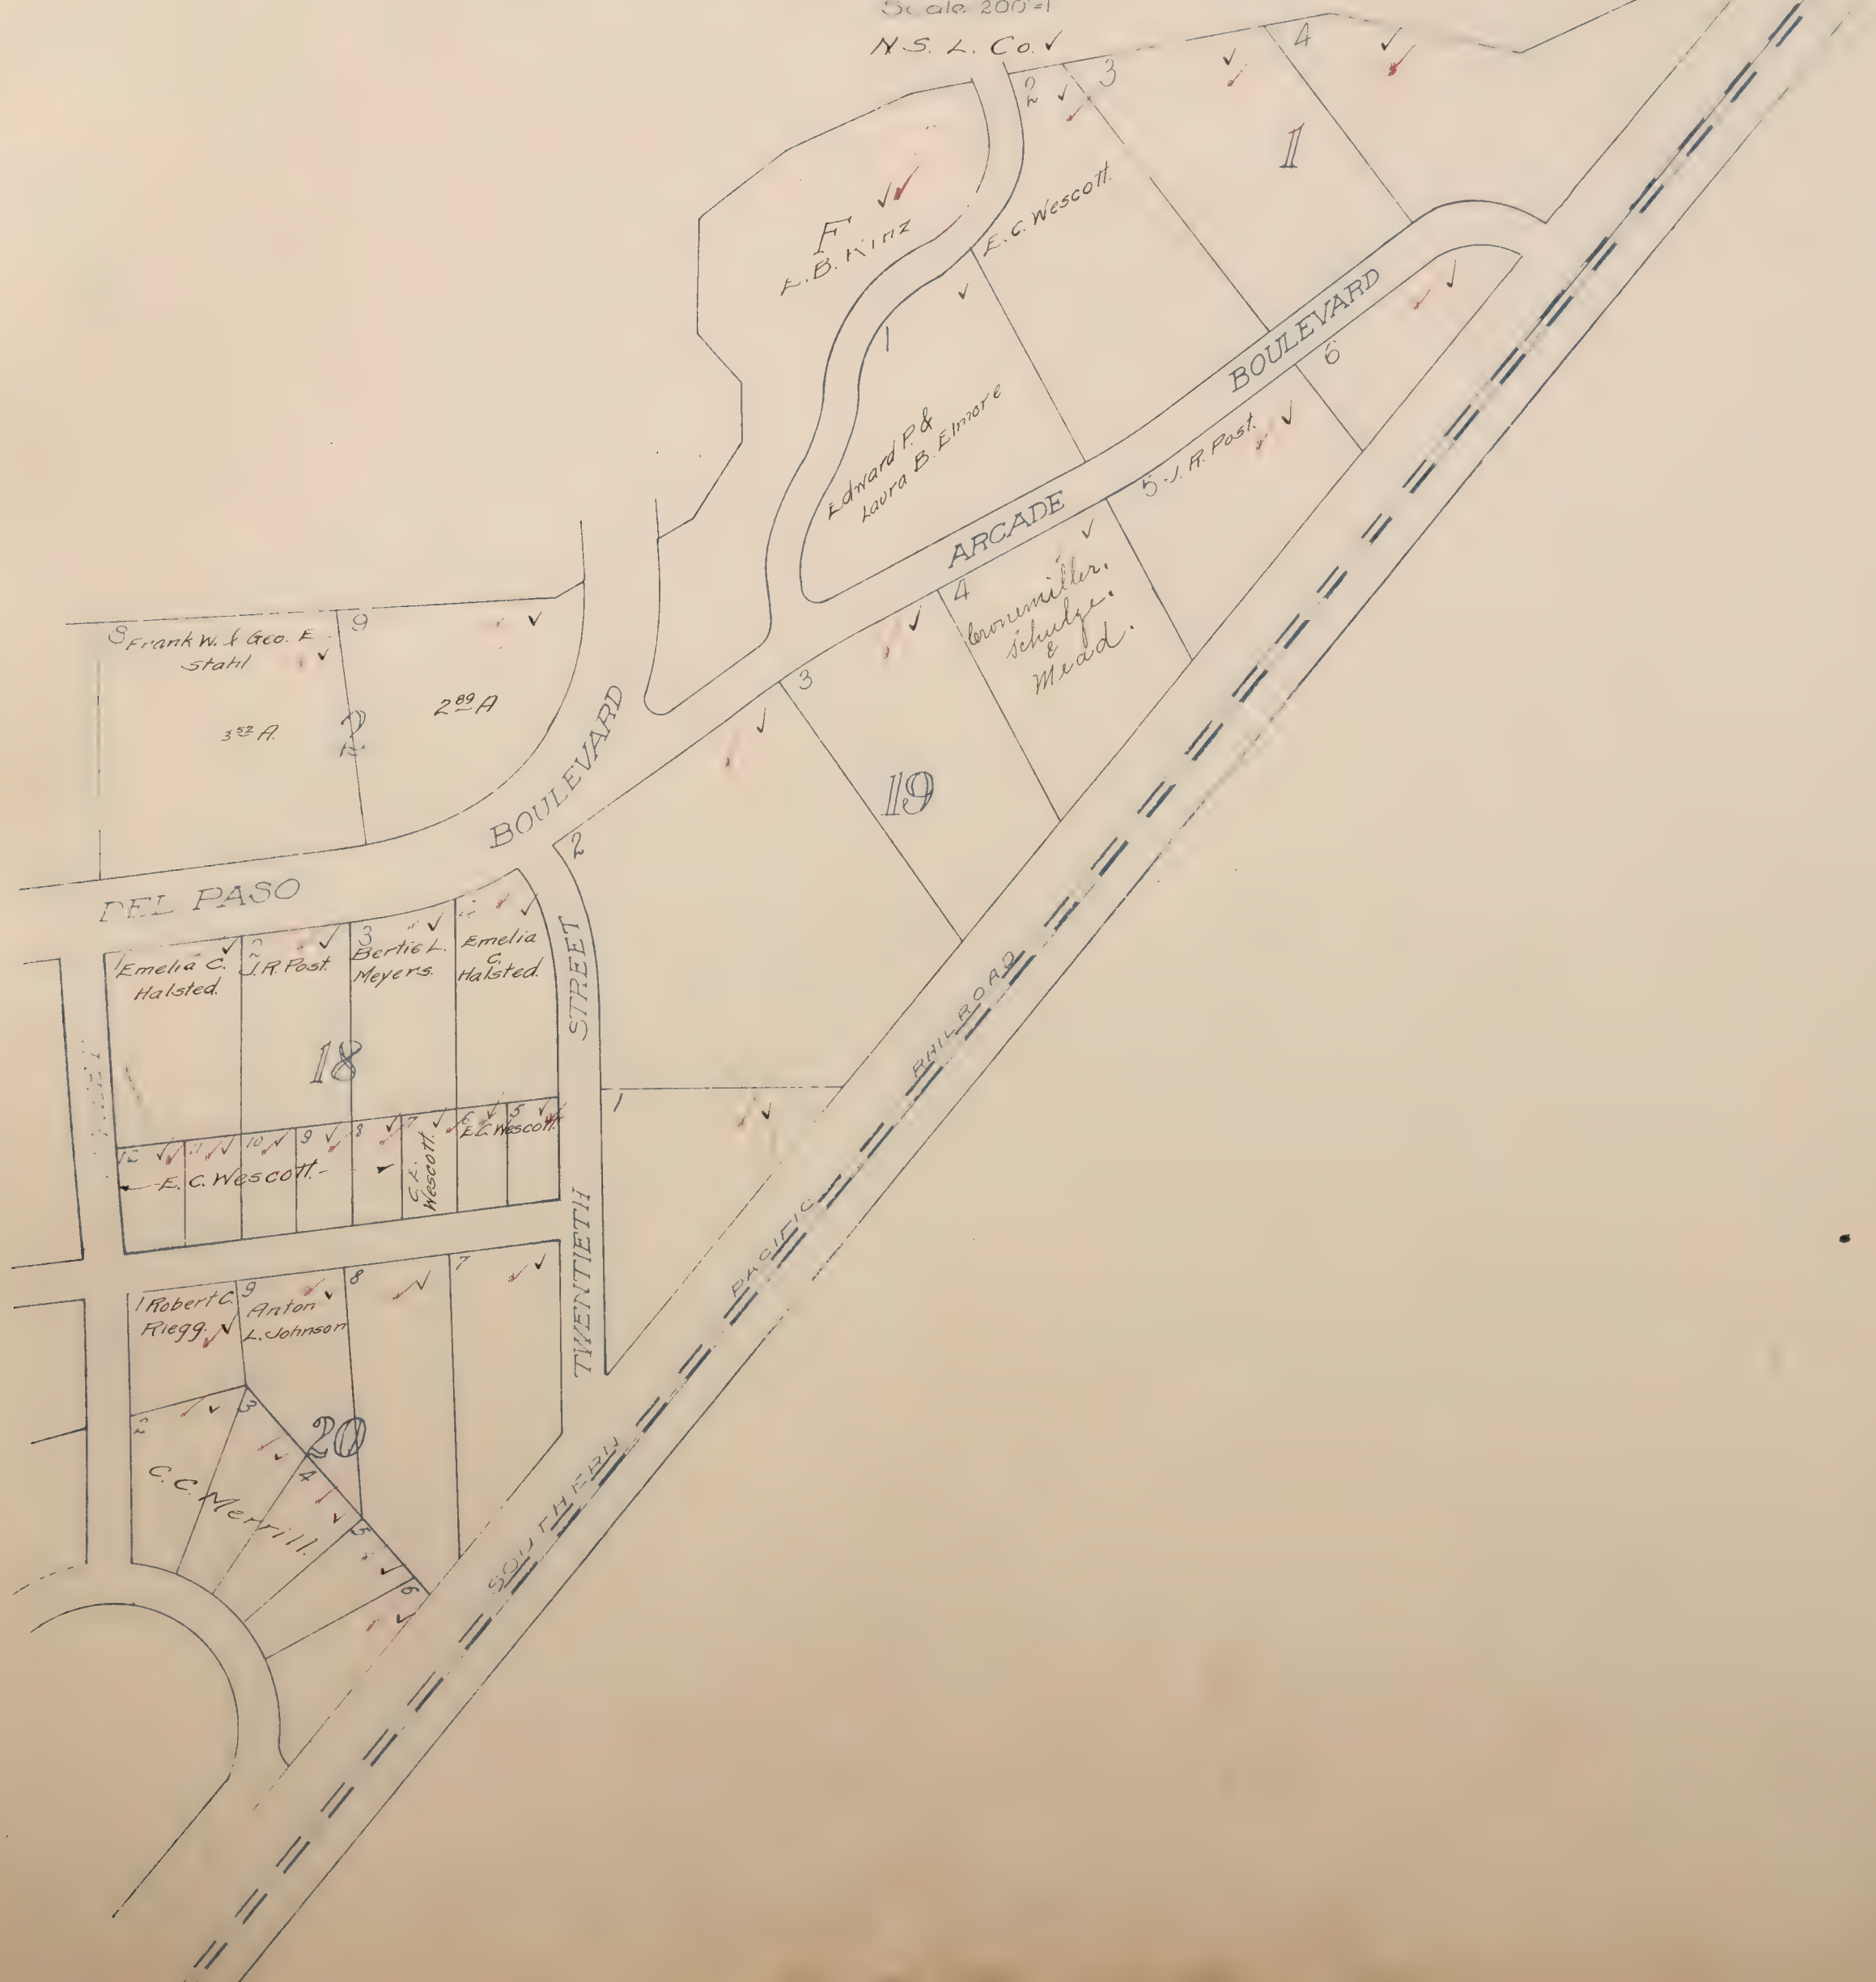

Mapped.

Black Ink-1919 Ownership
Red Ink-1920 Ownership

NORTH SAC TO SUBD. NO. 3

LOCATED IN
Rancho Del Paso
Scale: 1 in. = 200 ft.

N. S. L. Co v

T. L. Lick
Archie S. D.



Located in
Riverside Del Mar
Scale 200 ft

N. Sac. S. D

Del Paso Hts S.D. N. Sacto. S.D.

Map showing lots and owners:

- Top Section:**
 - 3¹² A. ✓
 - 6¹² A. ✓
 - A. A. Trueblood
- Middle Section:**
 - 9 ✓, 10 ✓, 11 ✓, 12 ✓, 13 ✓, 14 ✓, 15 ✓, 16 ✓
 - Martin J. & Ethel A. Minneberg
 - H. A. Trueblood
 - Eliza Schuler
 - H. A. Trueland
 - 7¹² A.
 - 3
 - D
 - 5¹² A.
- Bottom Section:**
 - 5 ✓, 6 ✓, 7 ✓, 8 ✓, 9 ✓
 - Limer Viola S. Joerger, Ramirez
 - William J. & Nellie E. Rouse
 - Madeline Graber
 - Eliza Schuler
 - 10
 - A
 - B
 - 4¹² A.
 - 5¹² A.
 - 12
 - Brooke Farm
 - Harvey W. Strader
- Streets:**
 - TWELFTH STREET
 - THIRTEENTH STREET
 - BOULEVARD
 - ARCAD
- Other Labels:**
 - J. A. Becker
 - W. Strader
 - Pitney
 - See other sheet

Black Ink-1919 Ownership
Red Ink-1920 Ownership

NORTH SACRAMENTO SUBDN NO.3

LOCATED IN
Plancha Del Paso
Scale: 200'-1"

Haggin Race Track Sub.

Del Paso Hts. S.D.

N. S. L. Co. ✓



Black Ink-1919 Ownership
Red Ink-1970 Ownership

LOCATED IN
Sec. 16 Rancho Del Paso 7 Sept. 11.
Scale 800'-1"

all blanks, below assessed to North Sacto Land Co ✓



Mapped.

NORTH SACRAMENTO SUBD N° 5

Sec 26 Range 10 North
Twp 20 North

Haggin Wood

Black Ink-1919 Ownership
Red Ink-1920 Ownership

N. Sacto. S.D.




Alpen.

Scale: 200' = 1"

Haggin Wood.

N. Sacto S.D.

N. S. L. Co. ✓

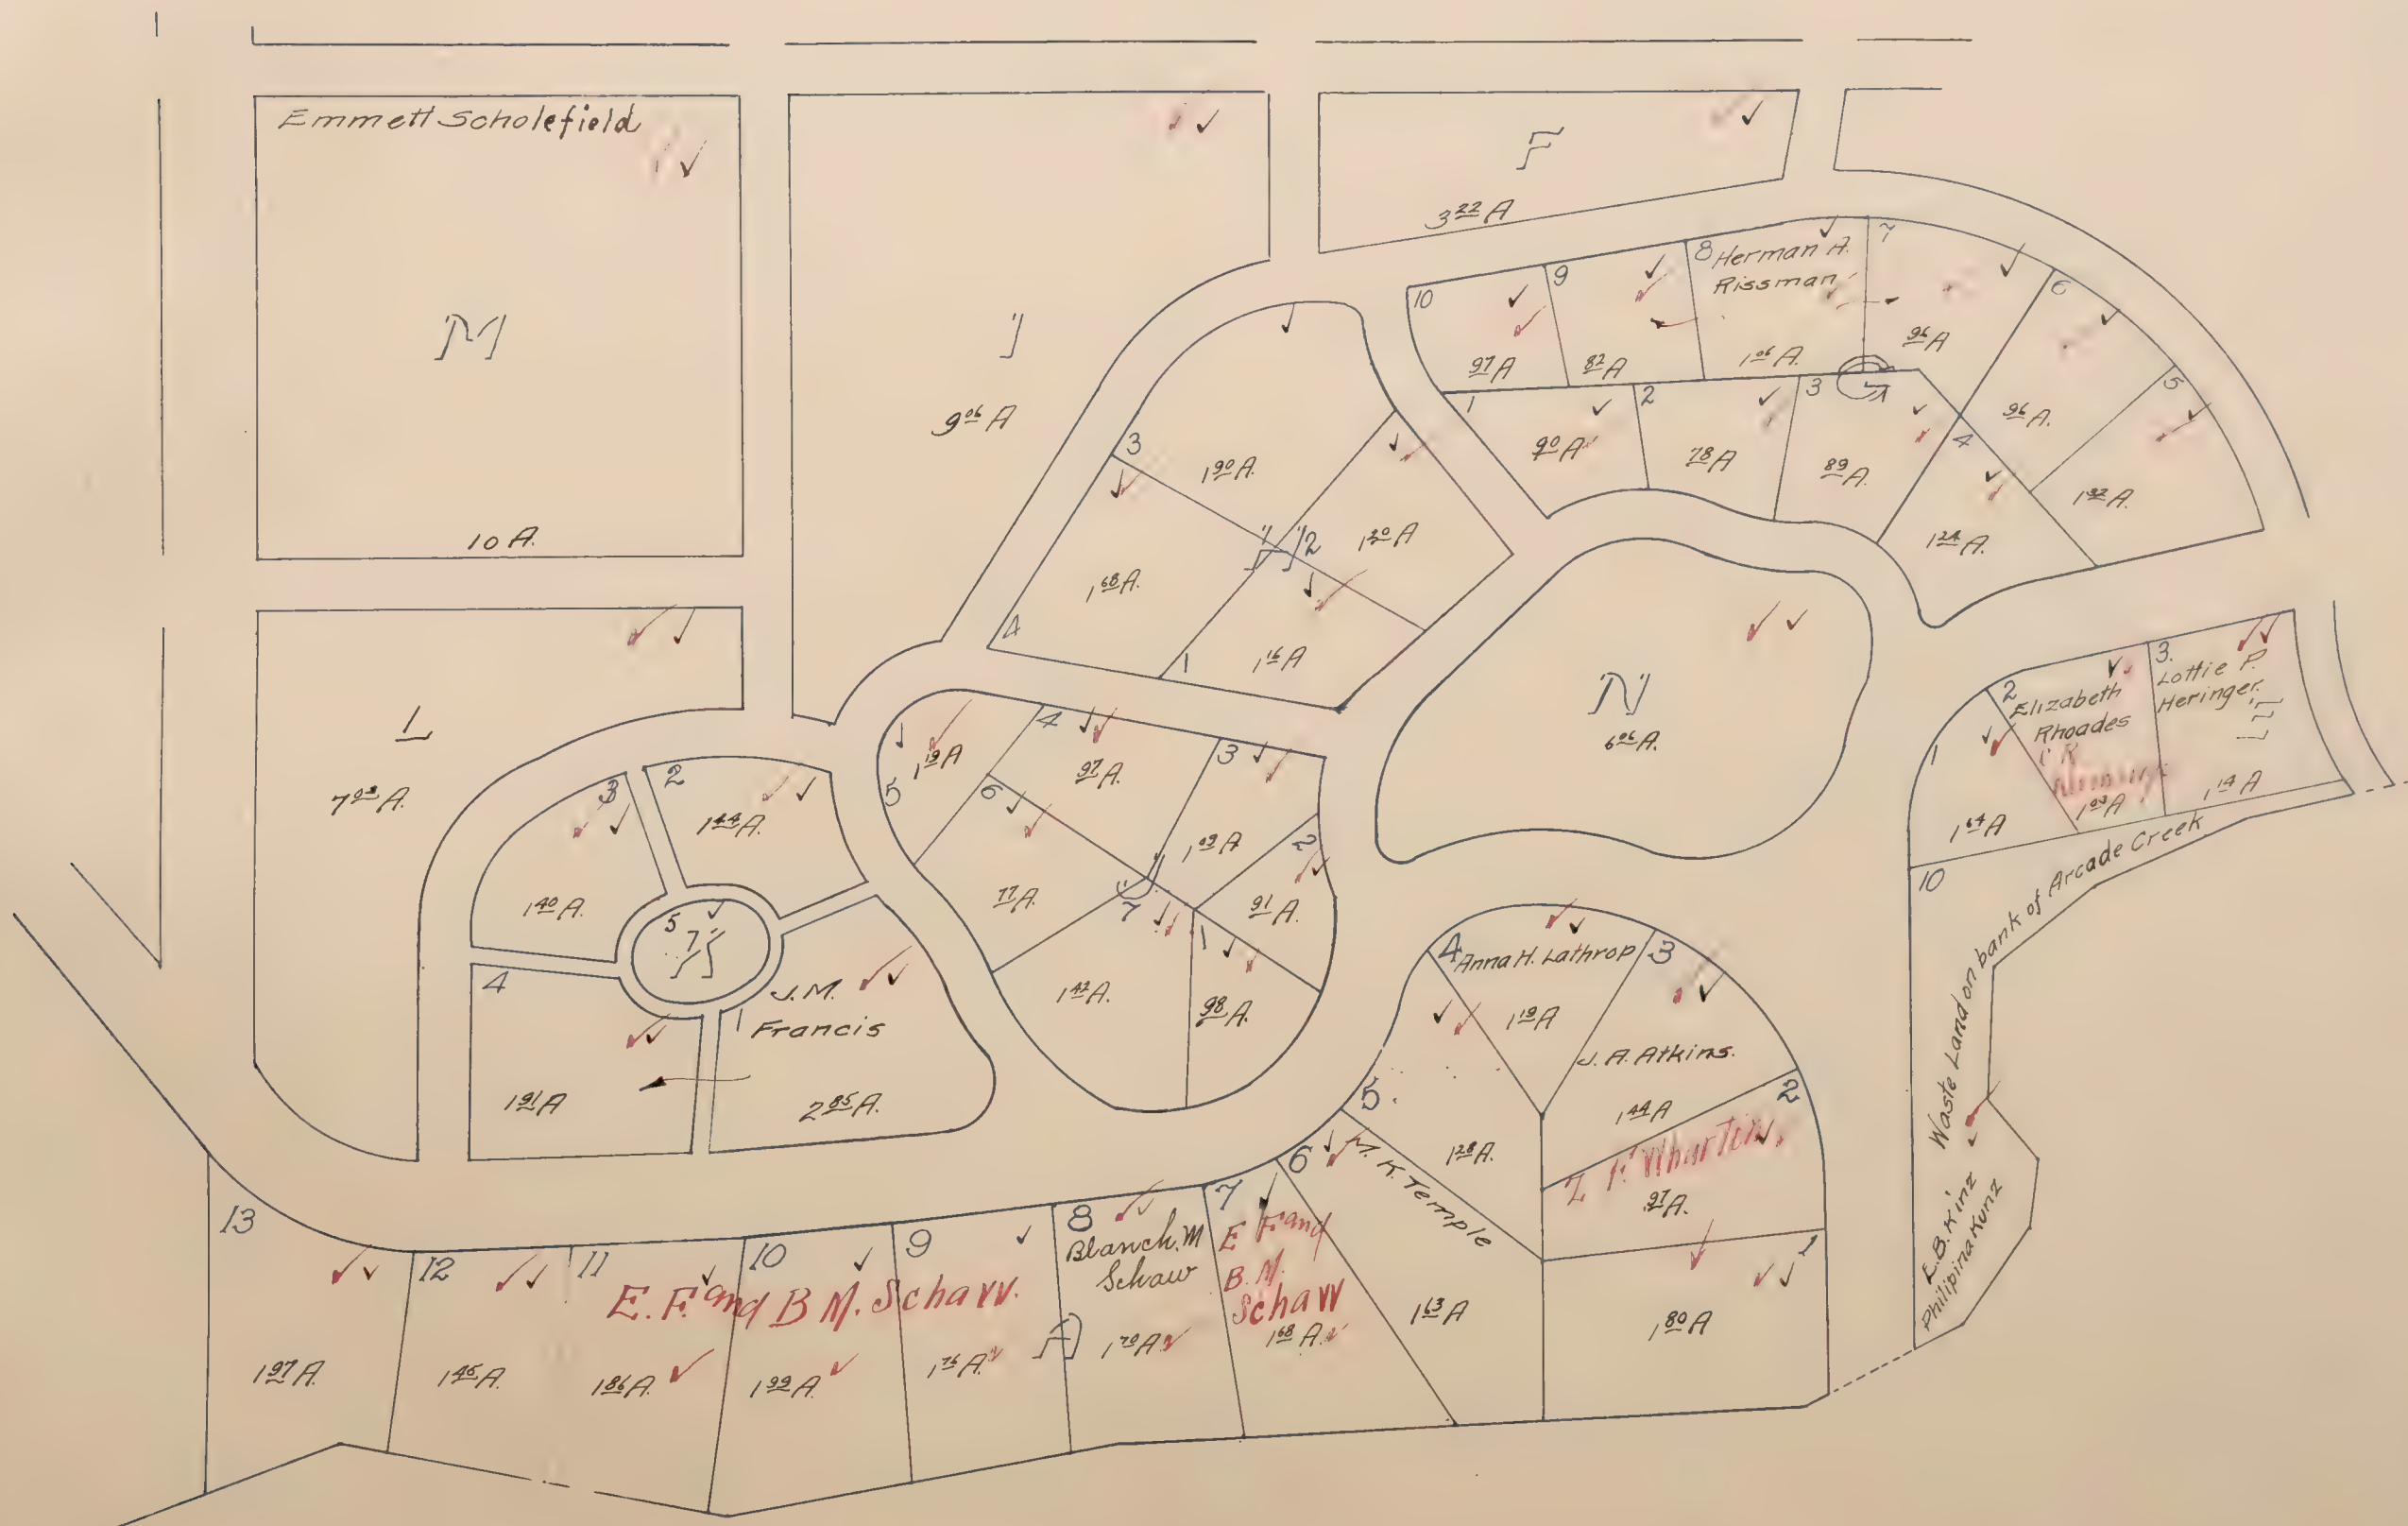


SUBD NO.6 NORTH SACRAMENTO

located in
Section 26 Rancho Del Pozo
Scale 1"=200ft

N. S. L. Co. v ✓

~~Accade 5.7~~

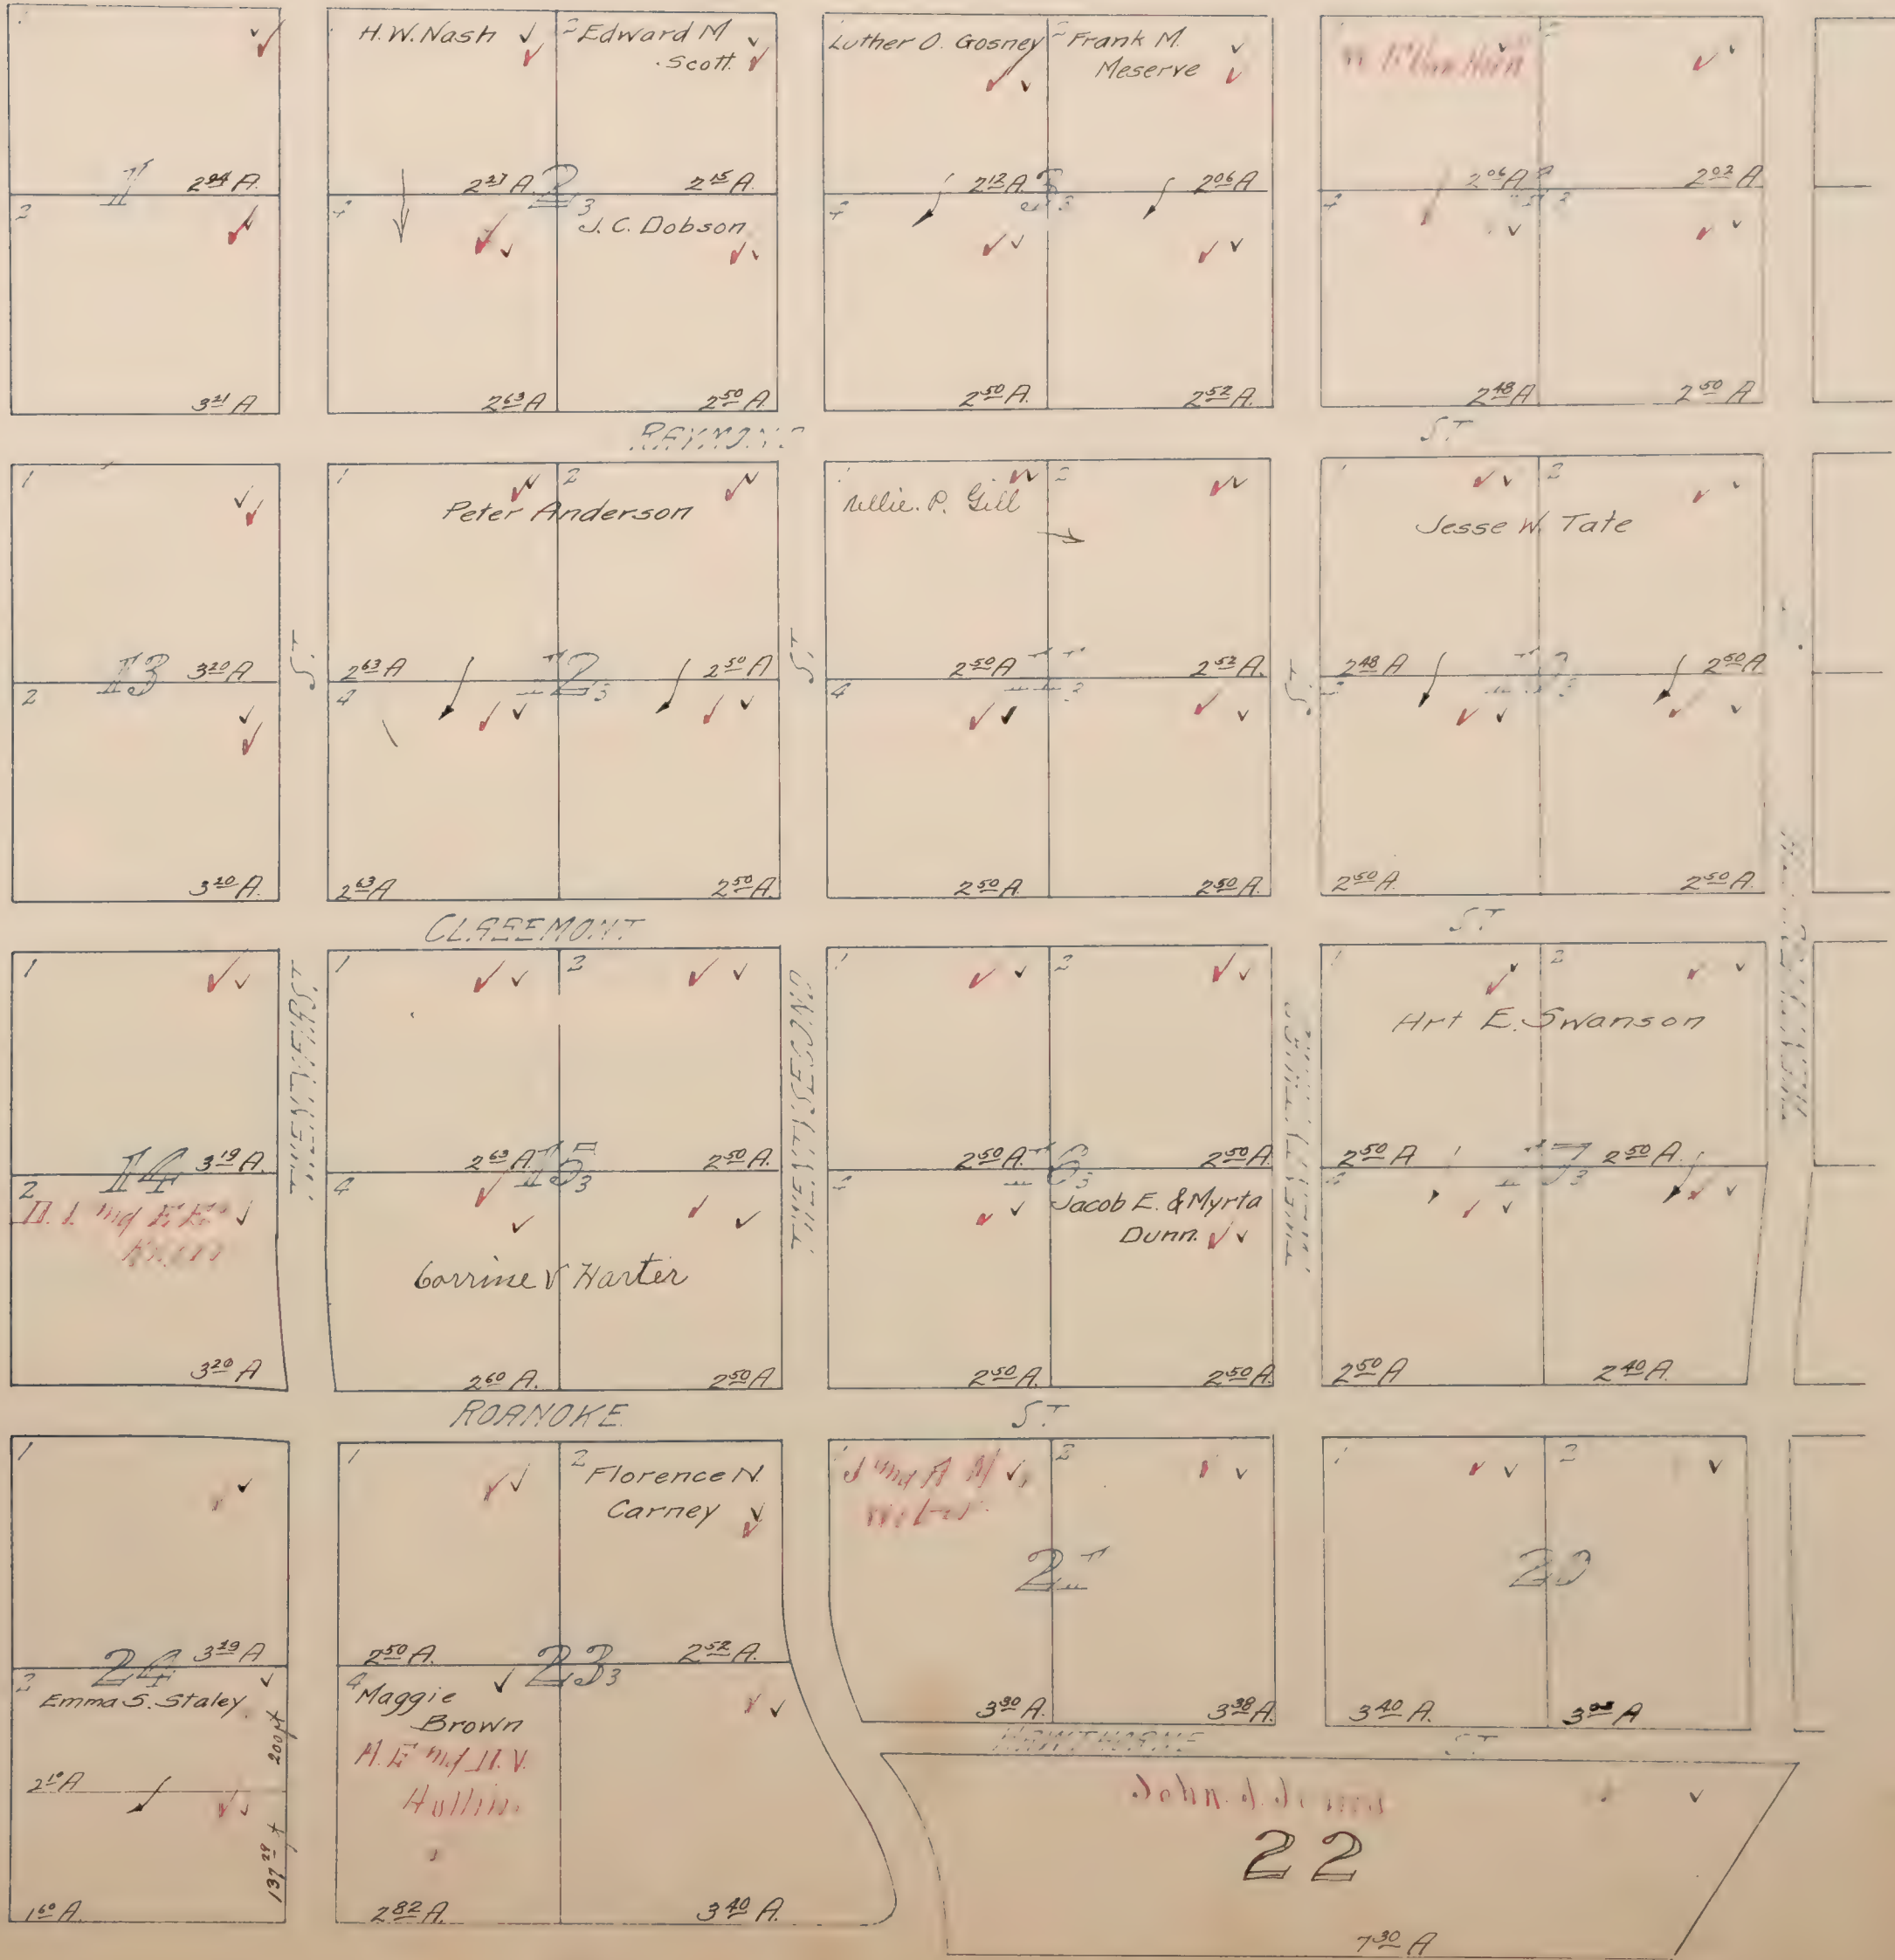

Mapped.

Black Ink-1919 Ownership
Red Ink-1920 Ownership


SUBD. NO. 6 NORTH SACRAMENTO

Located in
Section 26, Rancho Del Paso.

Scale 1" = 200 ft.

N. S. L. Co. ✓

h. J. L. Co.
Aracata S.D.

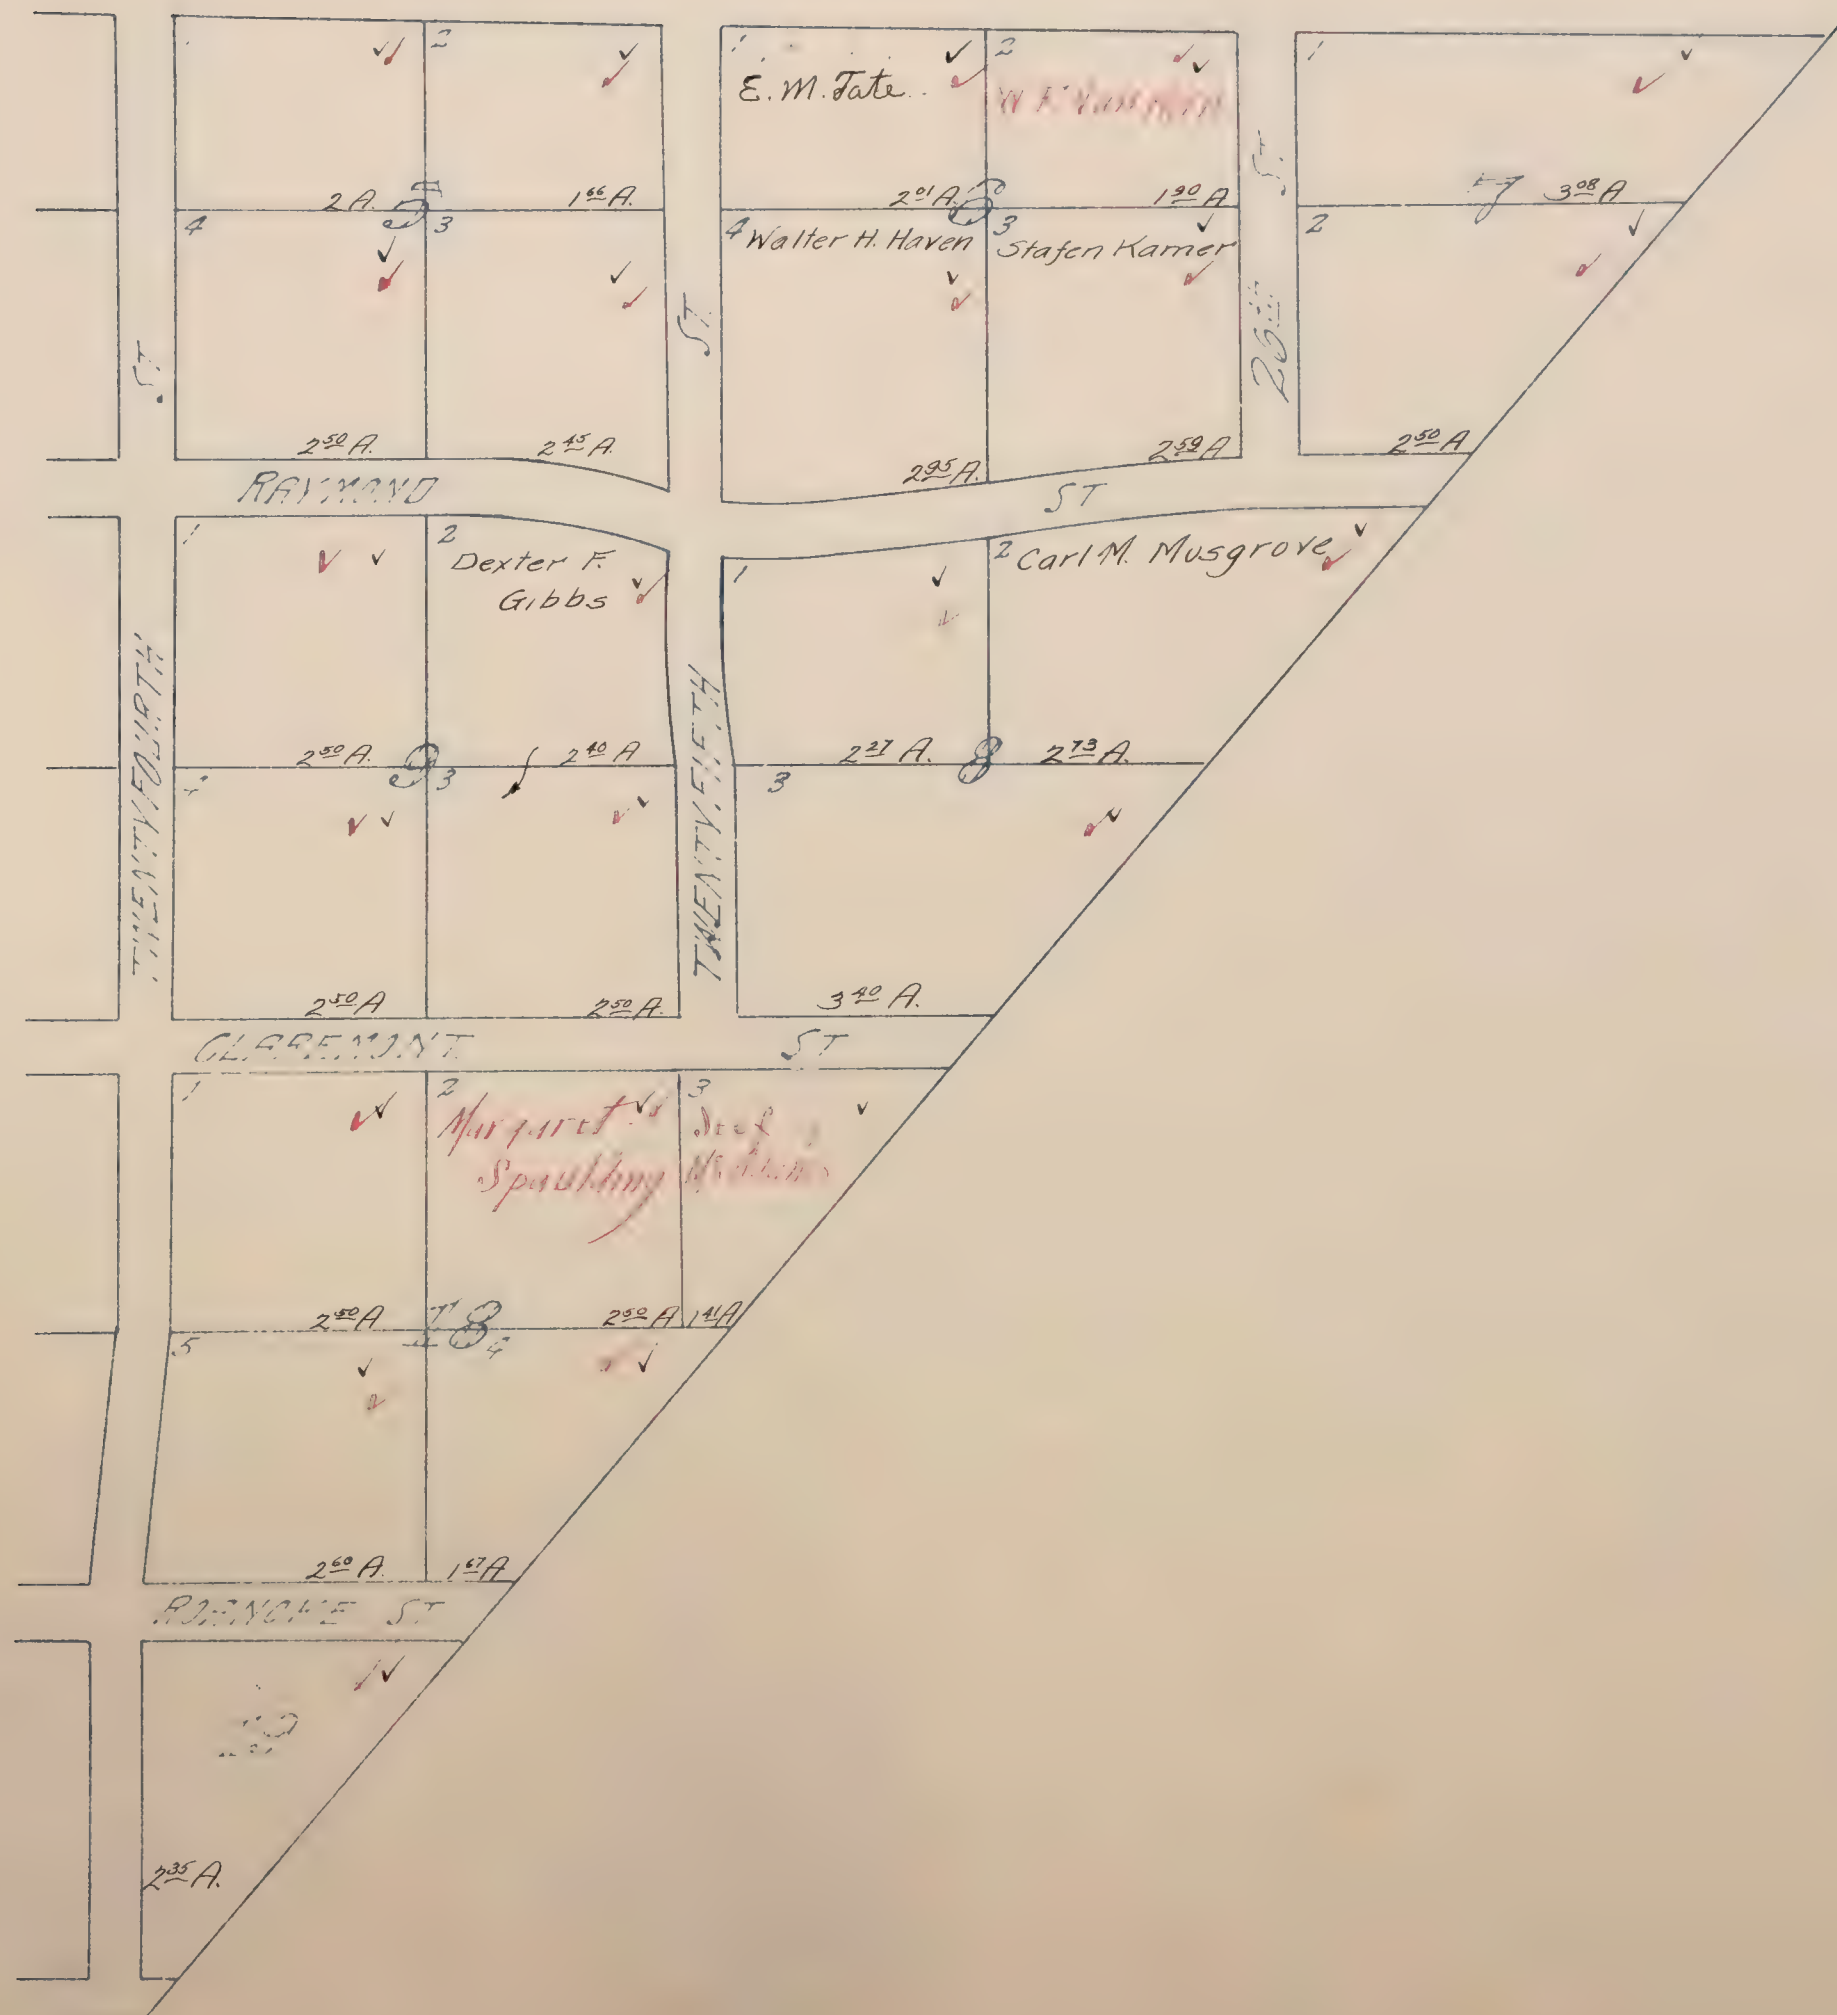

mapped.

Black Ink-1919 Ownership
Red Ink-1920 Ownership

SUBD. NO. 7 NORTH SACRAMENTO



Section 7

Section 7, Township 17 North, Range 12 East

Section 7, T17N, R12E

N. S. L. Co. ✓

N. Sacto S.D.

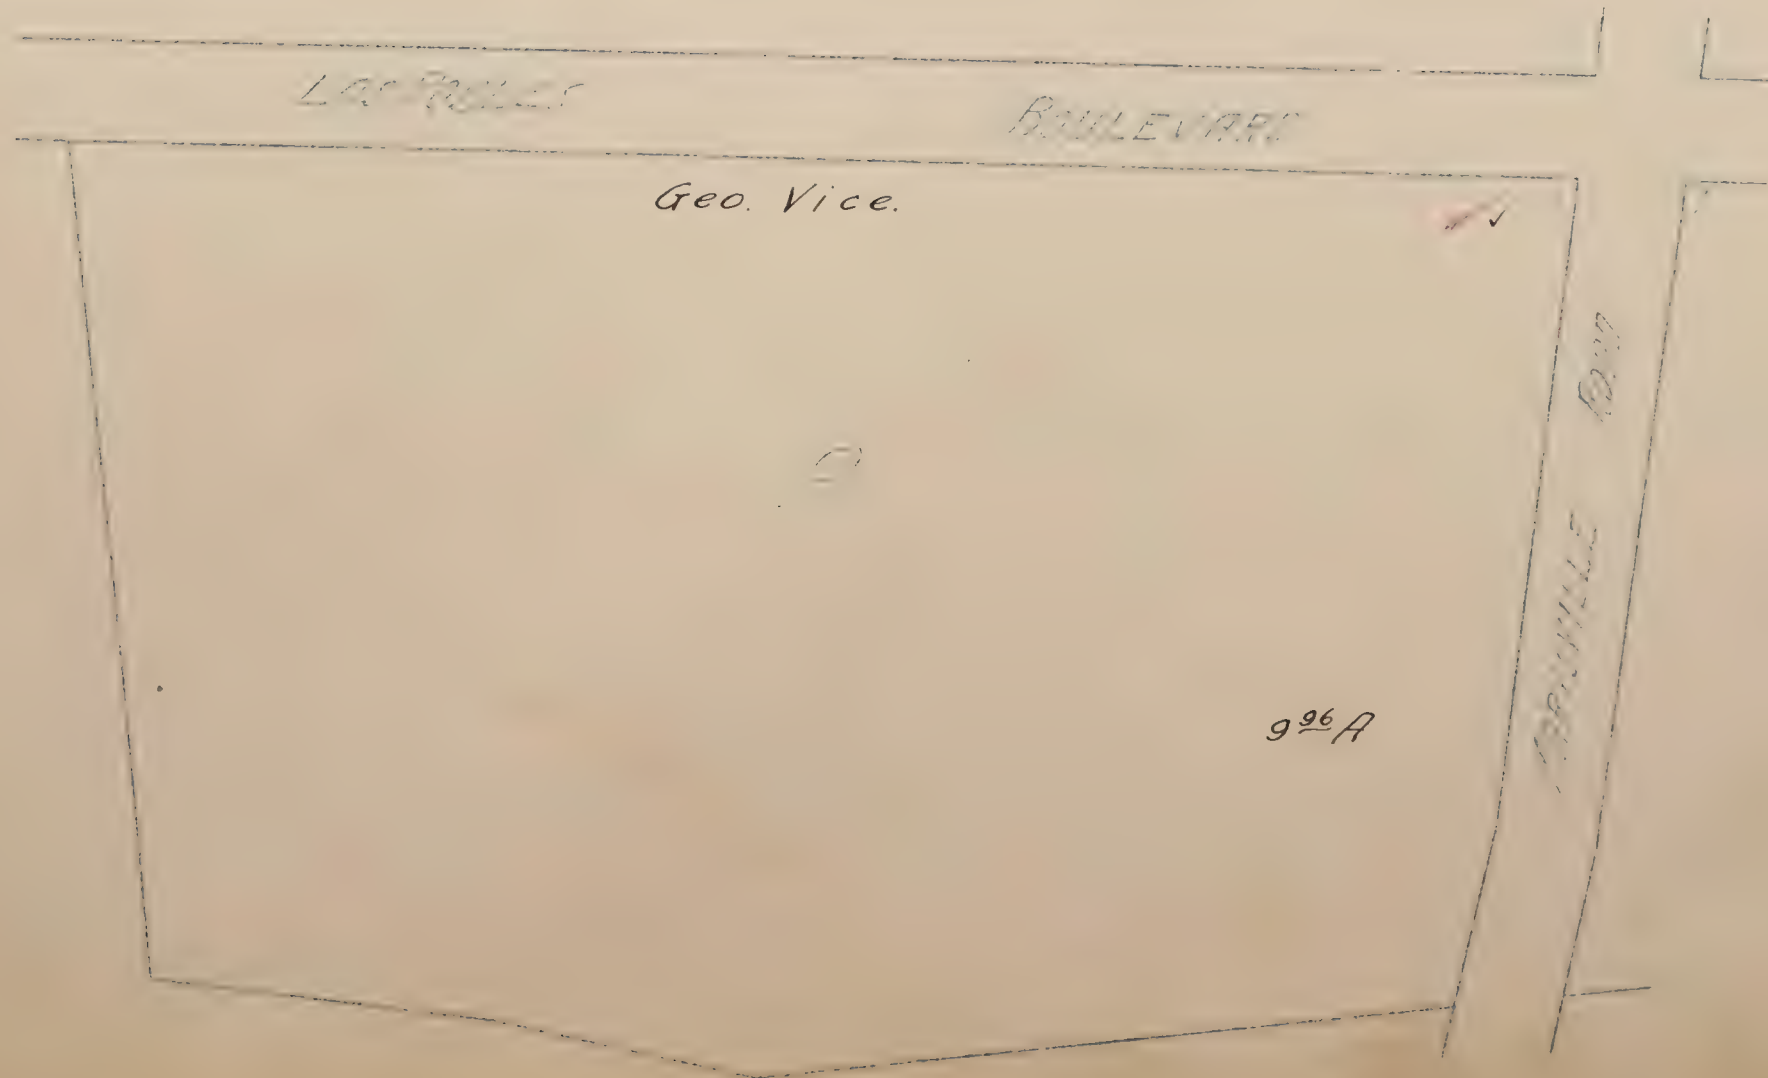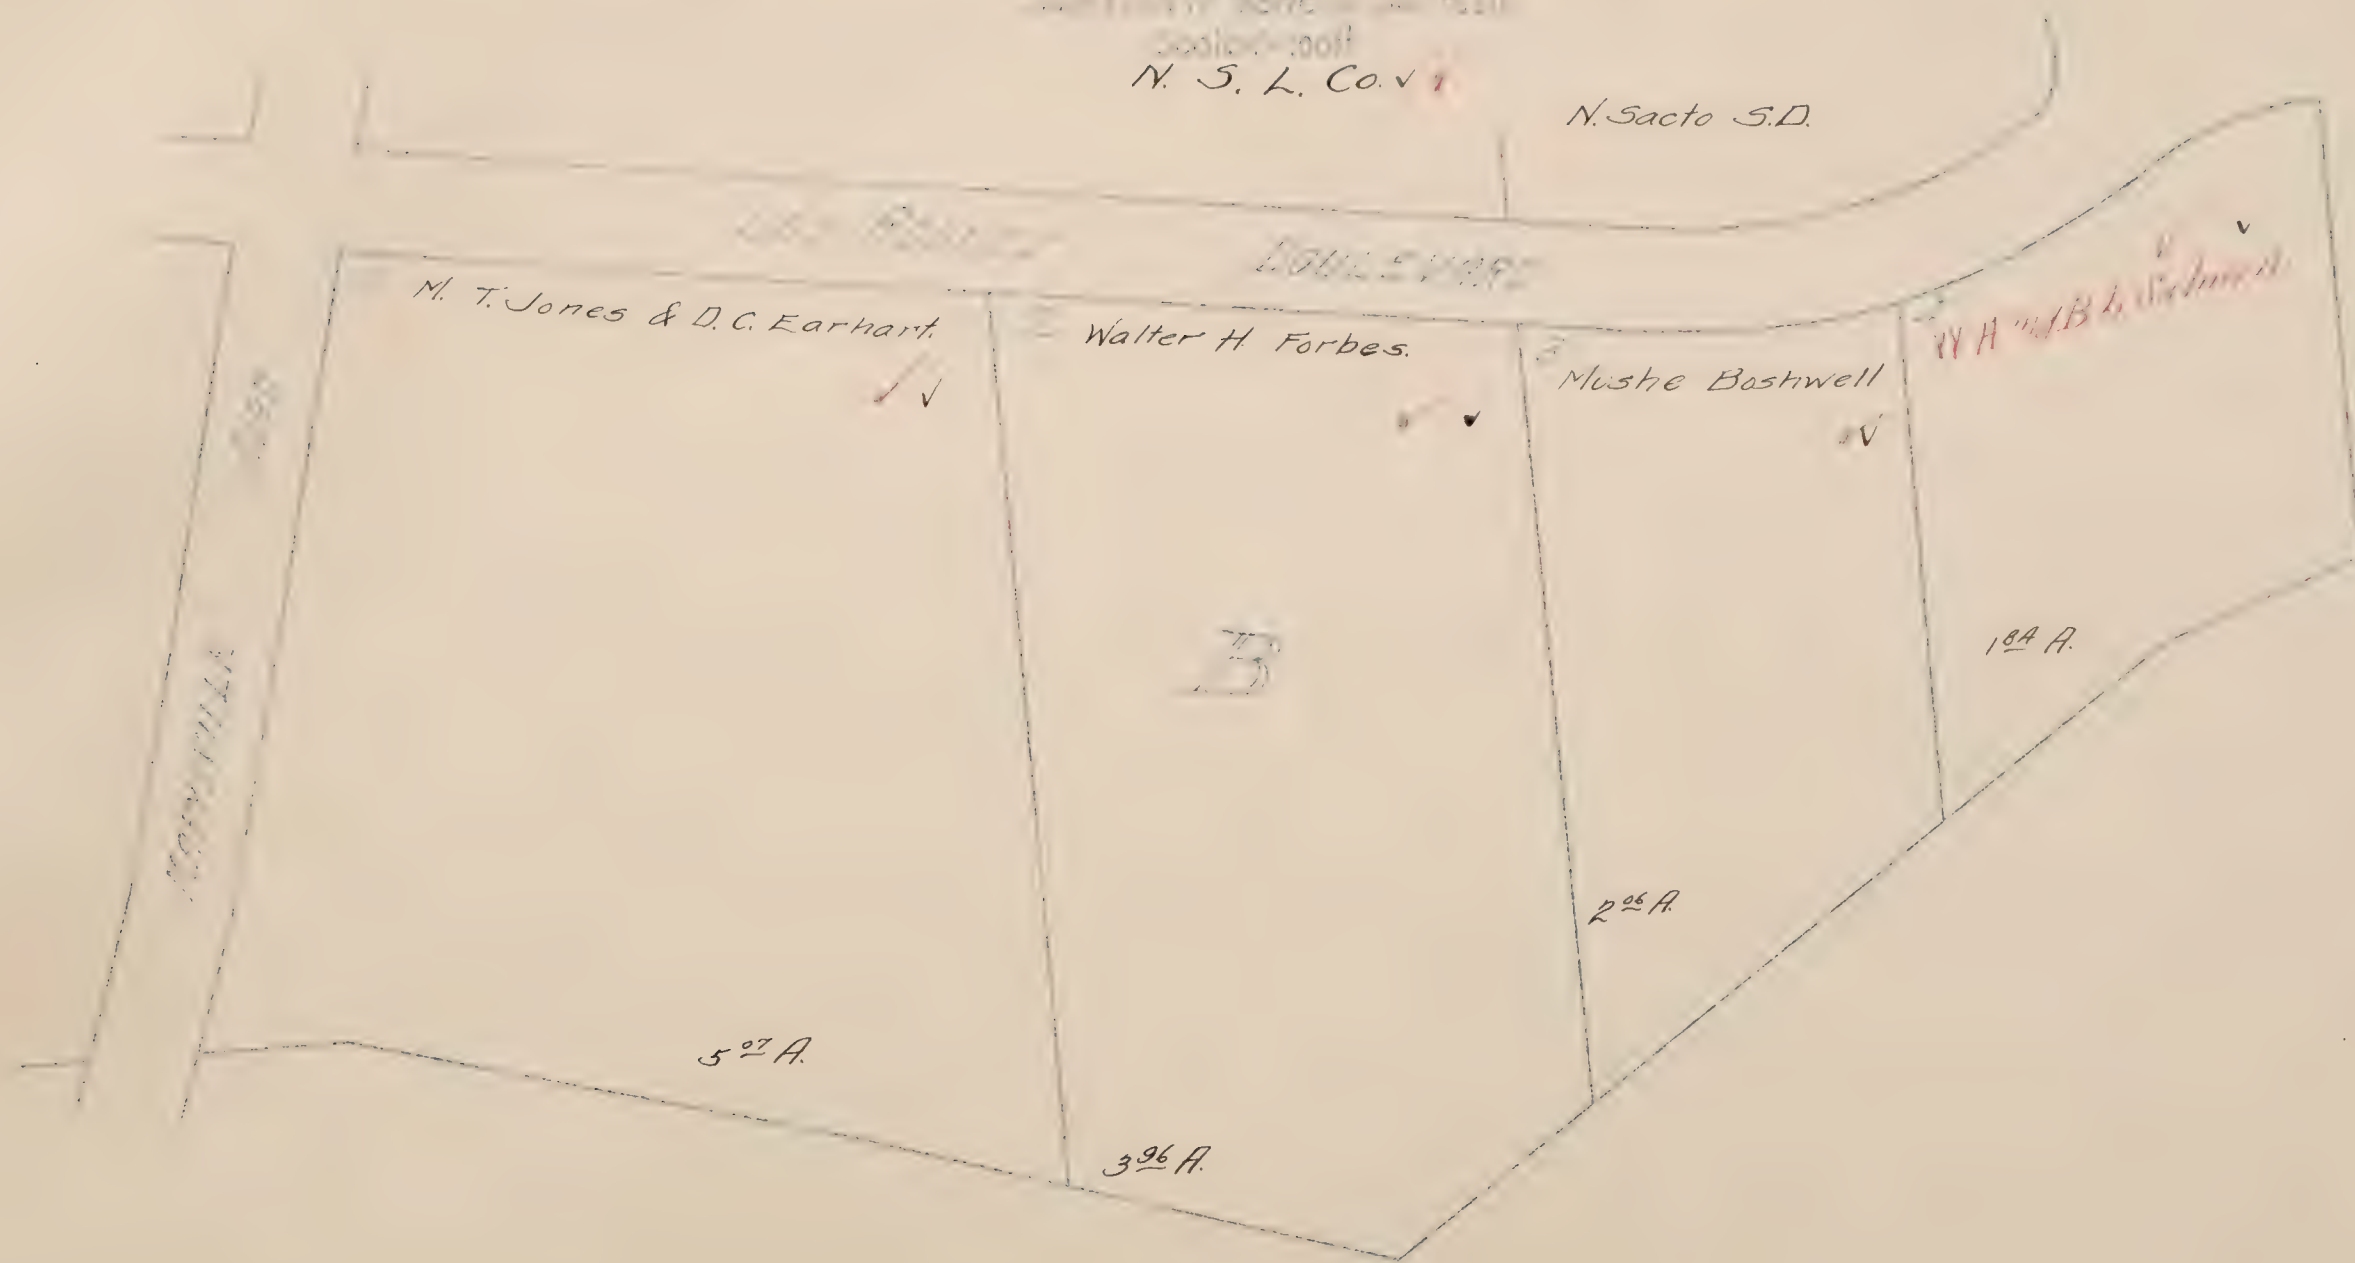

Black Ink-1919 Ownership
Red Ink-1920 Ownership



located in
Section 17, Rancho Del Paso
Scale: 1" = 100ft

N.S. L. Co. ✓ N. Sacto. S.D.

NORTH SACRAMENTO
SUBDIVISION NO 8

located in
Secs 13-10 Rancho Del Paso


Scale 1"=200'

Black Ink-1919 Ownership
Red Ink-1925 Ownership

Part of Sheet 102.

7. 1925
H. J. J. J.
H. J. J. J.

All blanks below assessed to North Sac Land Co

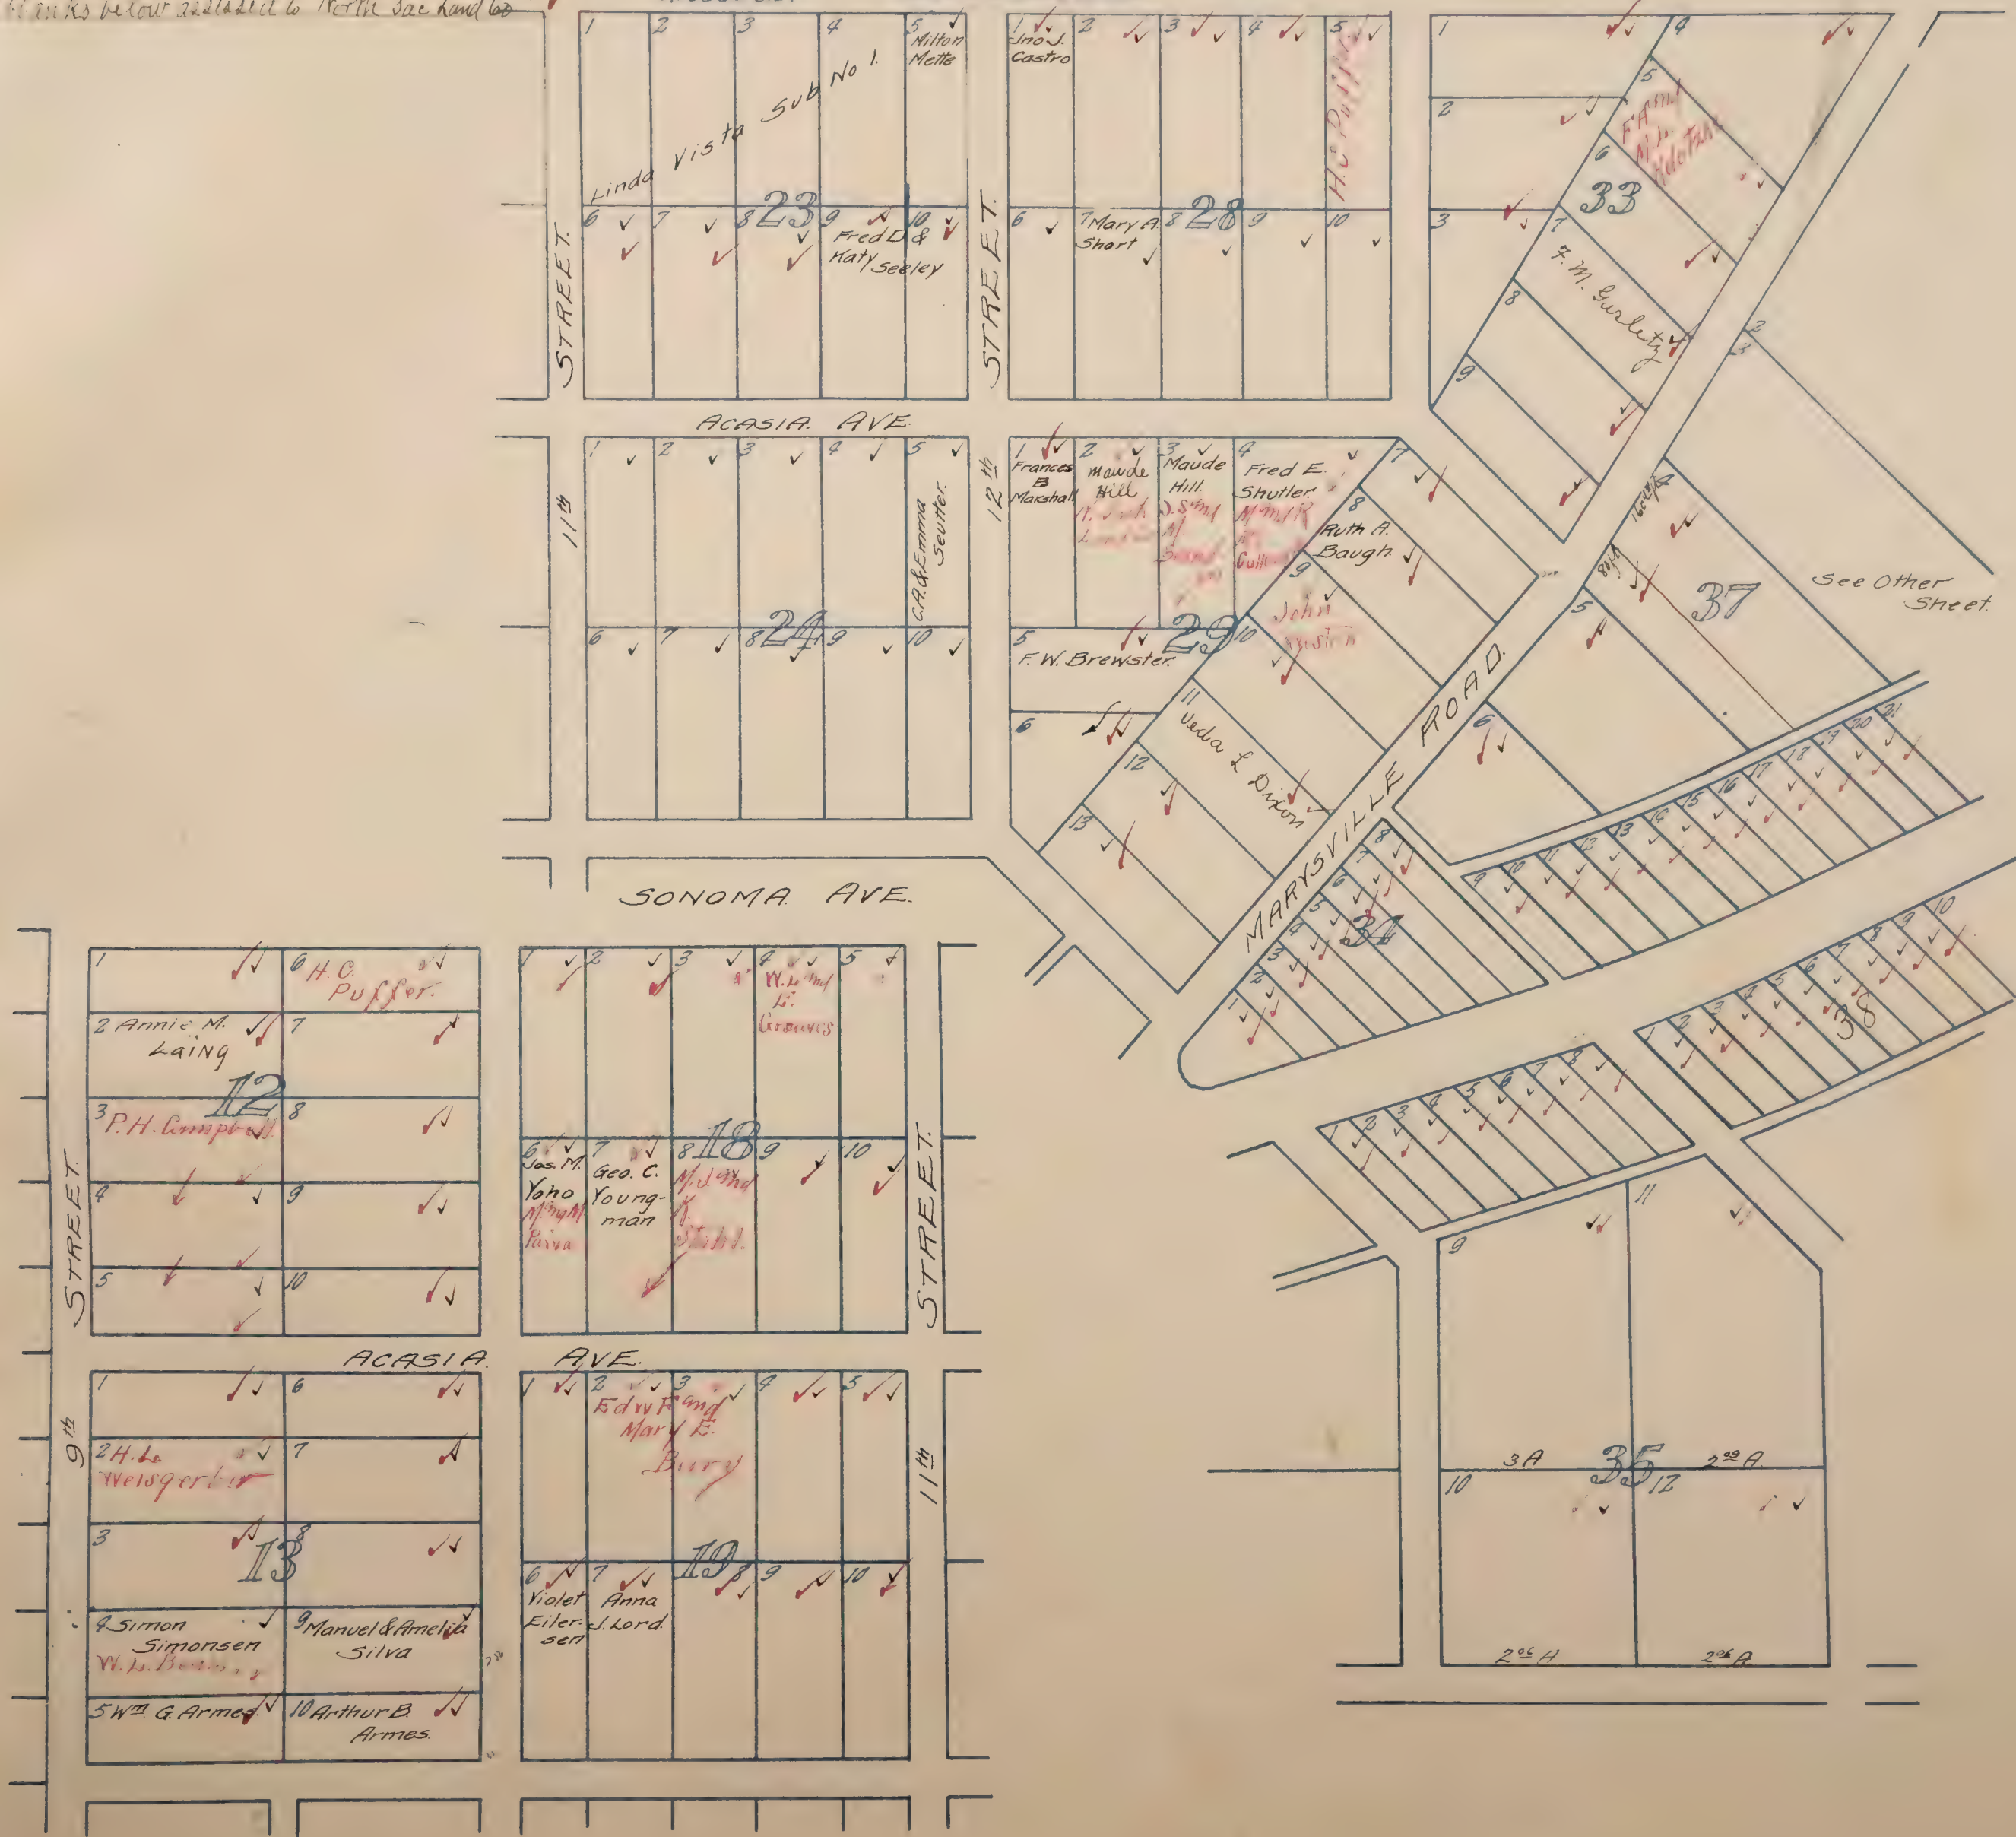


NORTH SACRAMENTO
- SUBDIVISION No. 8

located in
Sec's 2-13-16 Rancho Del Paso
Scale: 1"=200'
N. S. L. CO. v

Black Ink-1919 Ownership
Red Ink-1920 Ownership

Part of Street No 2

h. J. Smith
Attorney S.D.

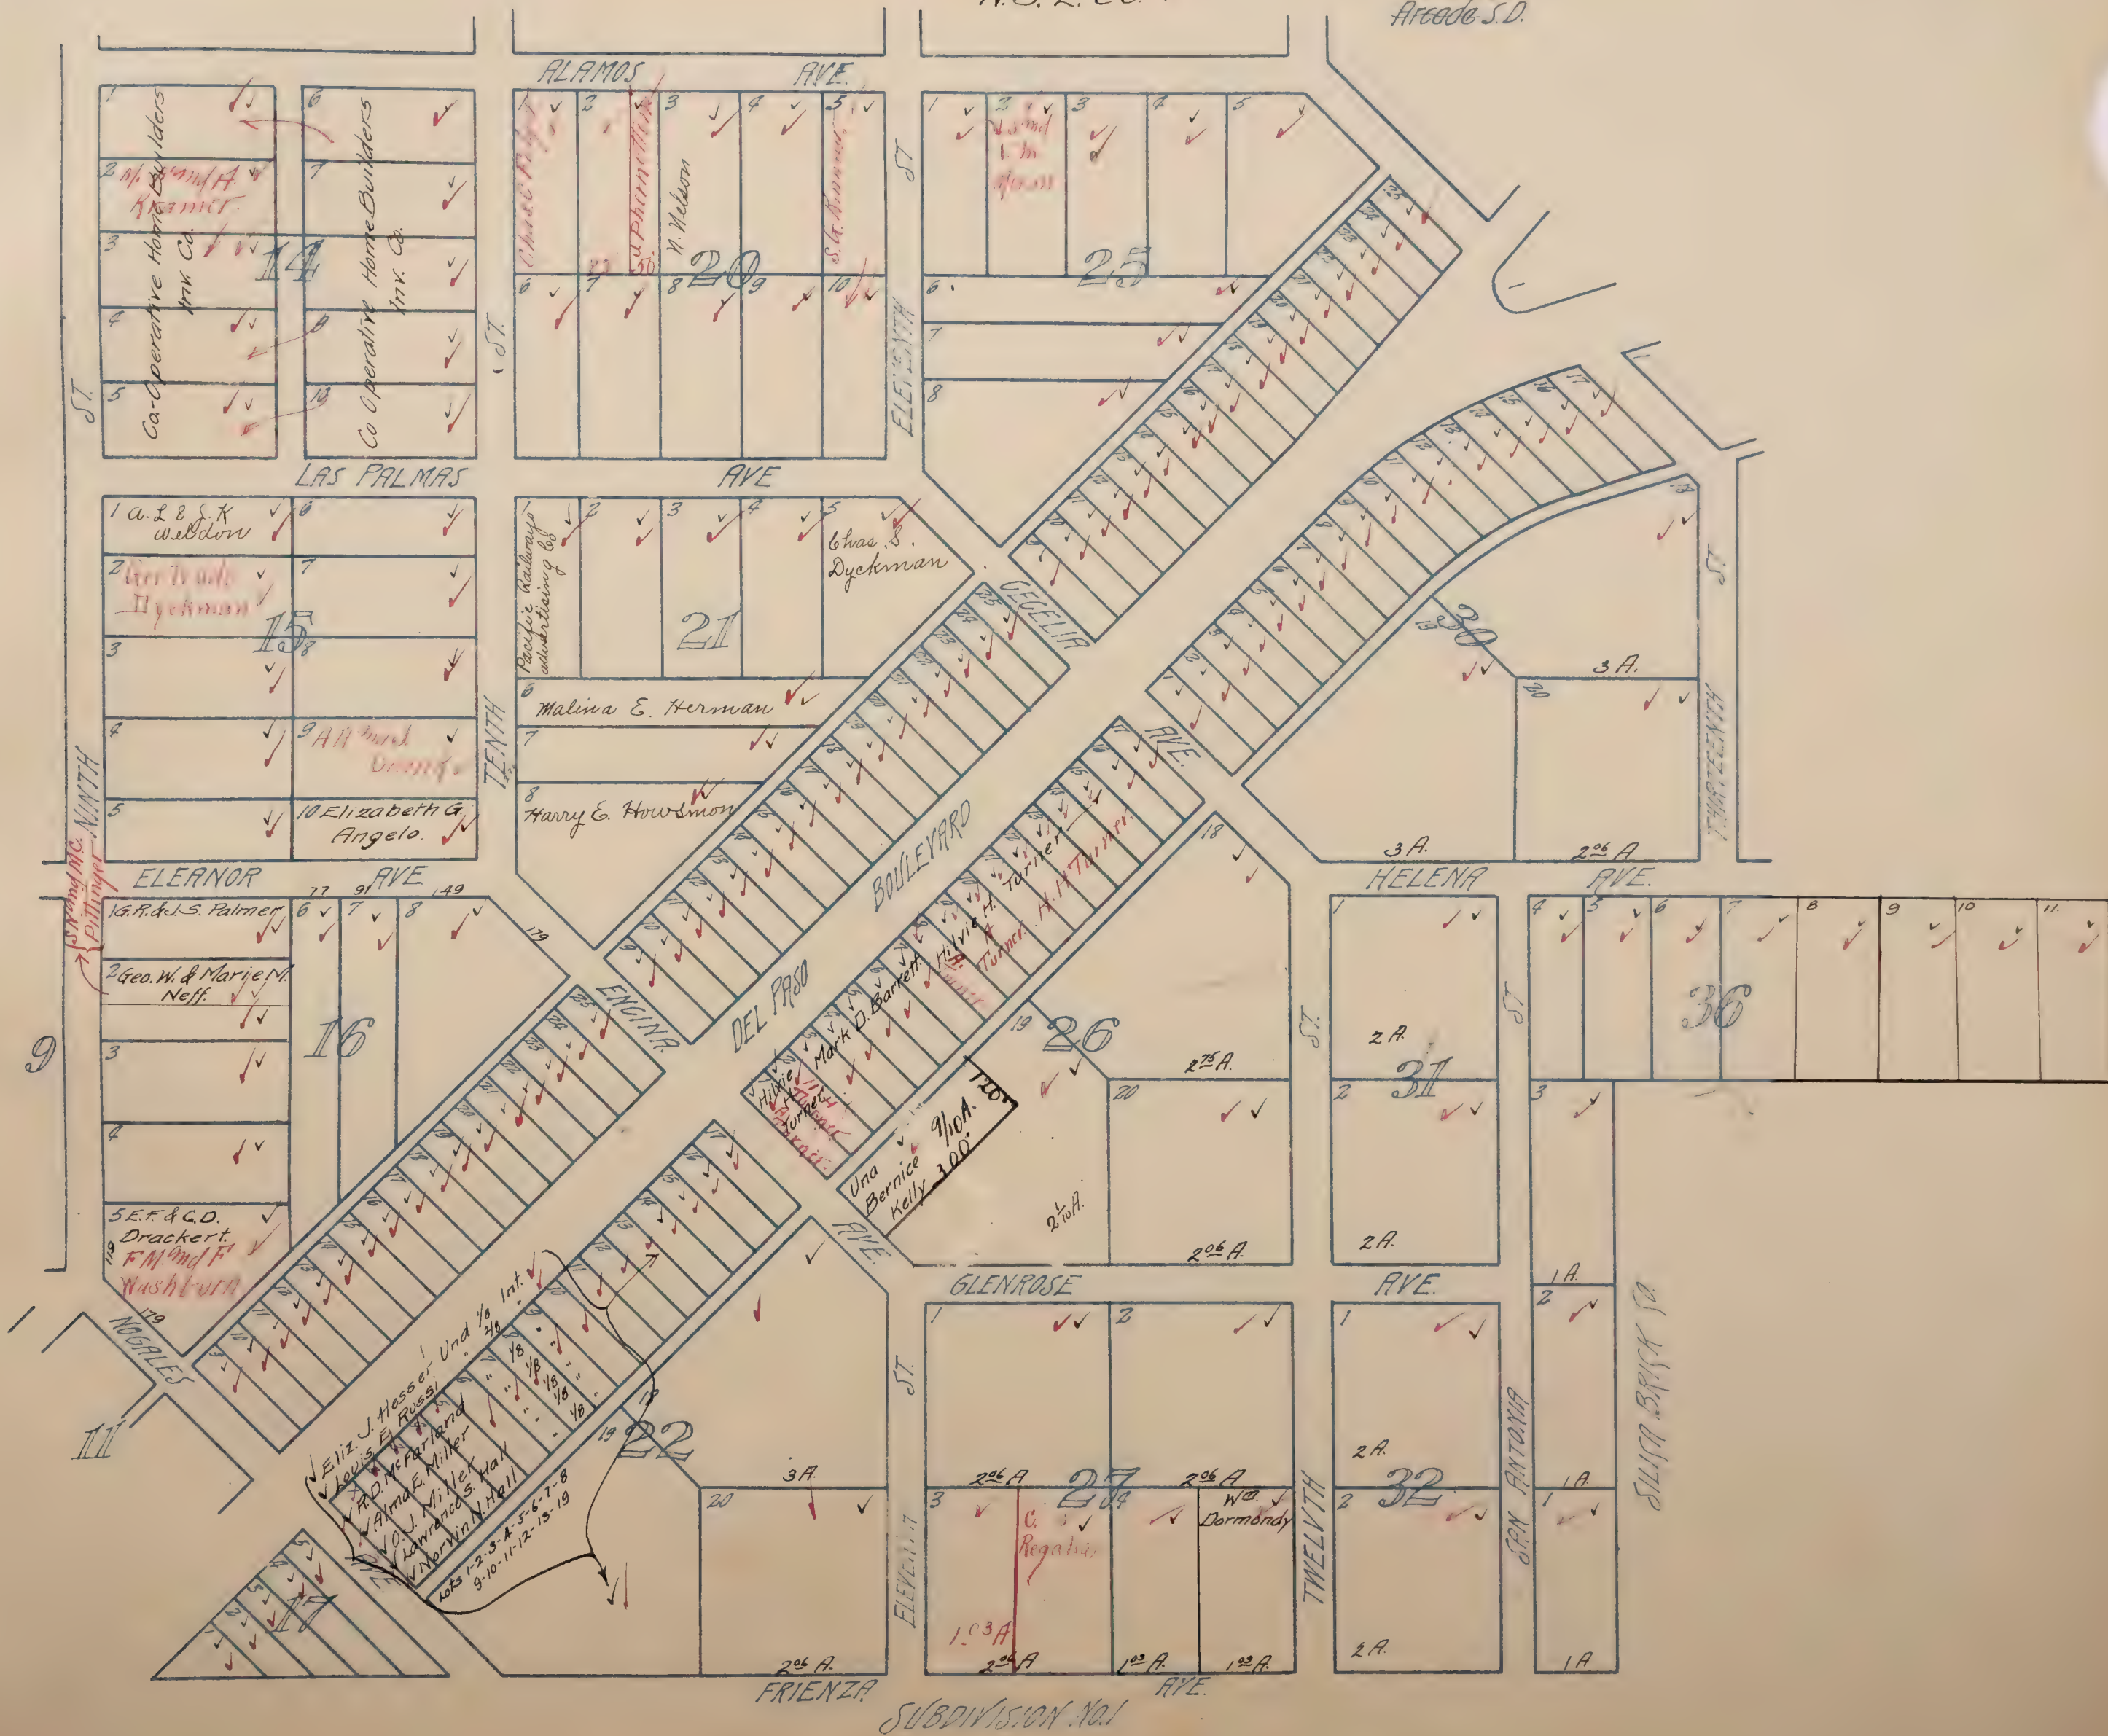

SUBDIVISION No. 1

Blanks to N. Sac. Land Co. ✓✓

NORTH SACRAMENTO
SUBDIVISION No. 8
located in
Secs 2-13-16 Rancho Del Paso —
Scale: 1" = 200'

Sheet No. 3

h. J. Smith
Arcade S.D.



Hand-drawn map of a residential neighborhood in Sacramento, California. The map shows a grid of streets and property lots. The streets labeled include El Camino, El Monte, El Paso, North Sacramento, Bolivar, and Bolivar. The lots are numbered and many are marked with checkmarks. The names of the owners are written on the lots. A large handwritten note on the right side reads "Checked in to register".

Streets shown:

- El Camino
- El Monte
- El Paso
- North Sacramento
- Bolivar
- Bolivar

Property lots and owners (from top left to bottom right):


- Lot 1: M. Oscar
- Lot 2: M. Oscar
- Lot 3: M. Oscar
- Lot 100: M. Oscar

Black Ink-1919 Ownership
Red Ink-1920 Ownership

located in

Scale = 200 feet

Sacramento Land Co. ✓ North Sacramento S.D.

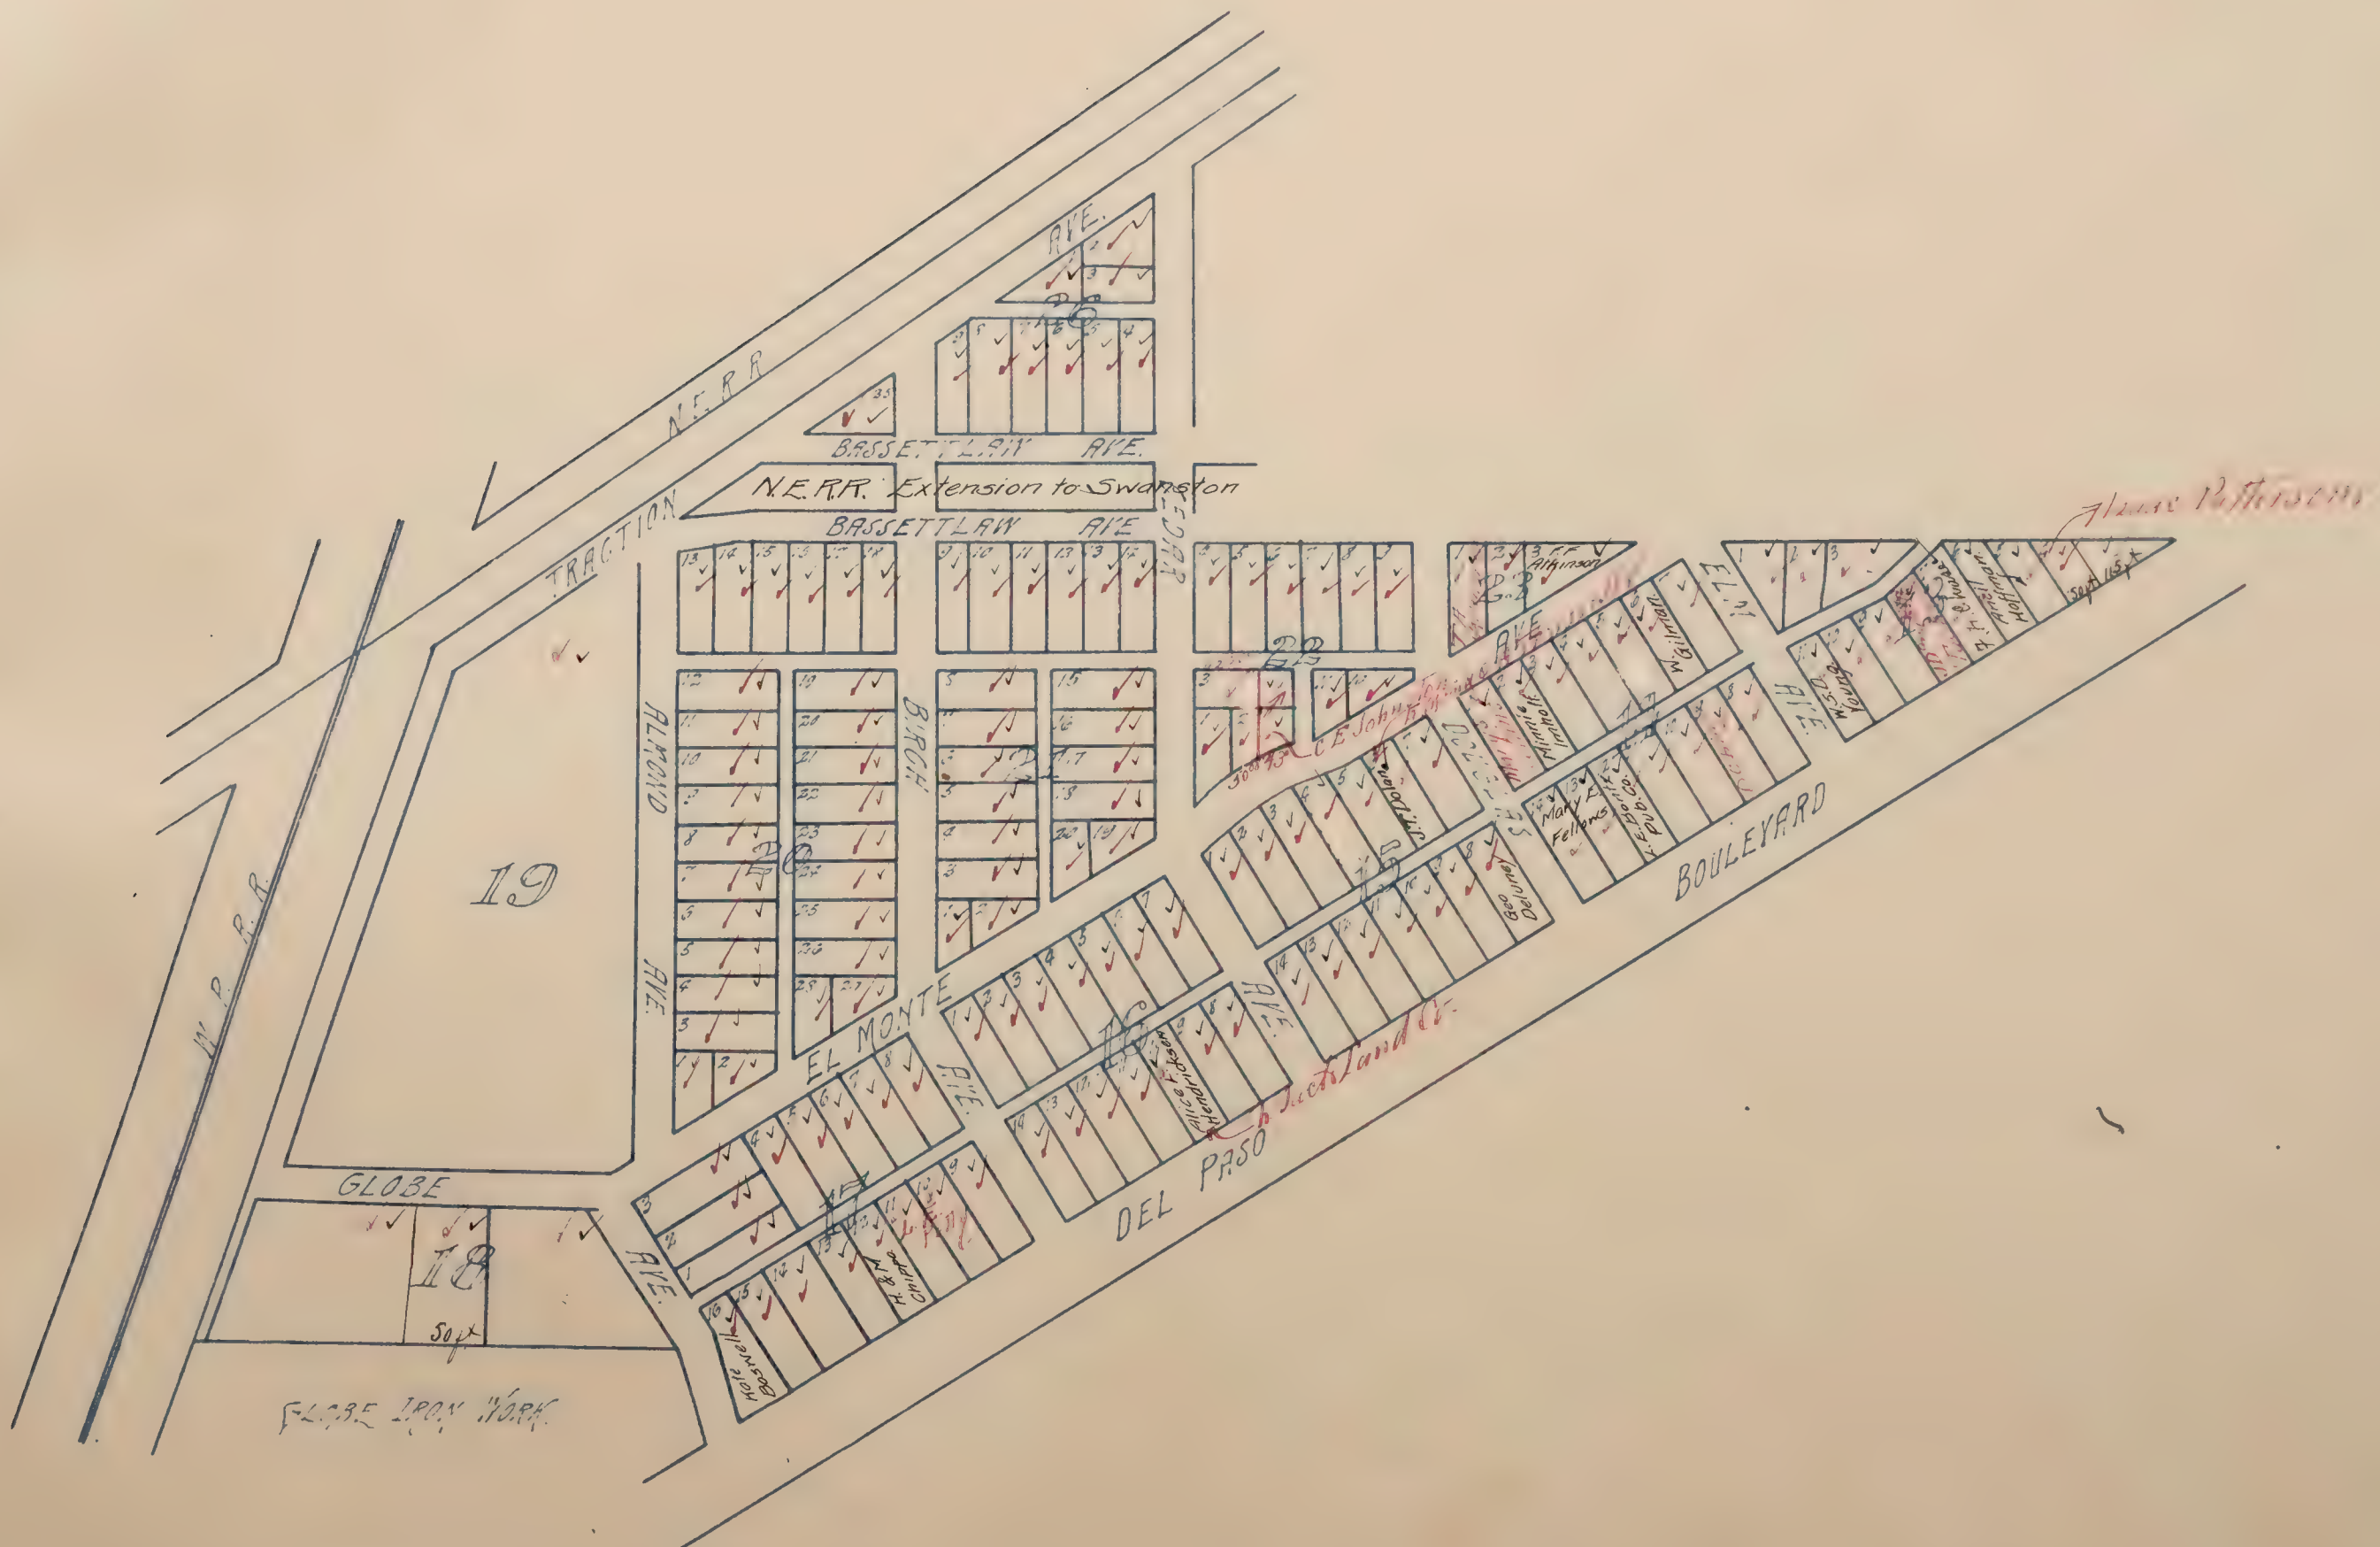

Mapped.


Black Ink-1919 Ownership
Red Ink-1923 Ownership

NORTH SACRAMENTO SUB'DN. NO. 9

located in
Sec's 1 & 14 Rancho Del Paso
Scale: 1"=200 ft

all blanks below assessed to North Sacto Land Co.

North Sacramento S.D.

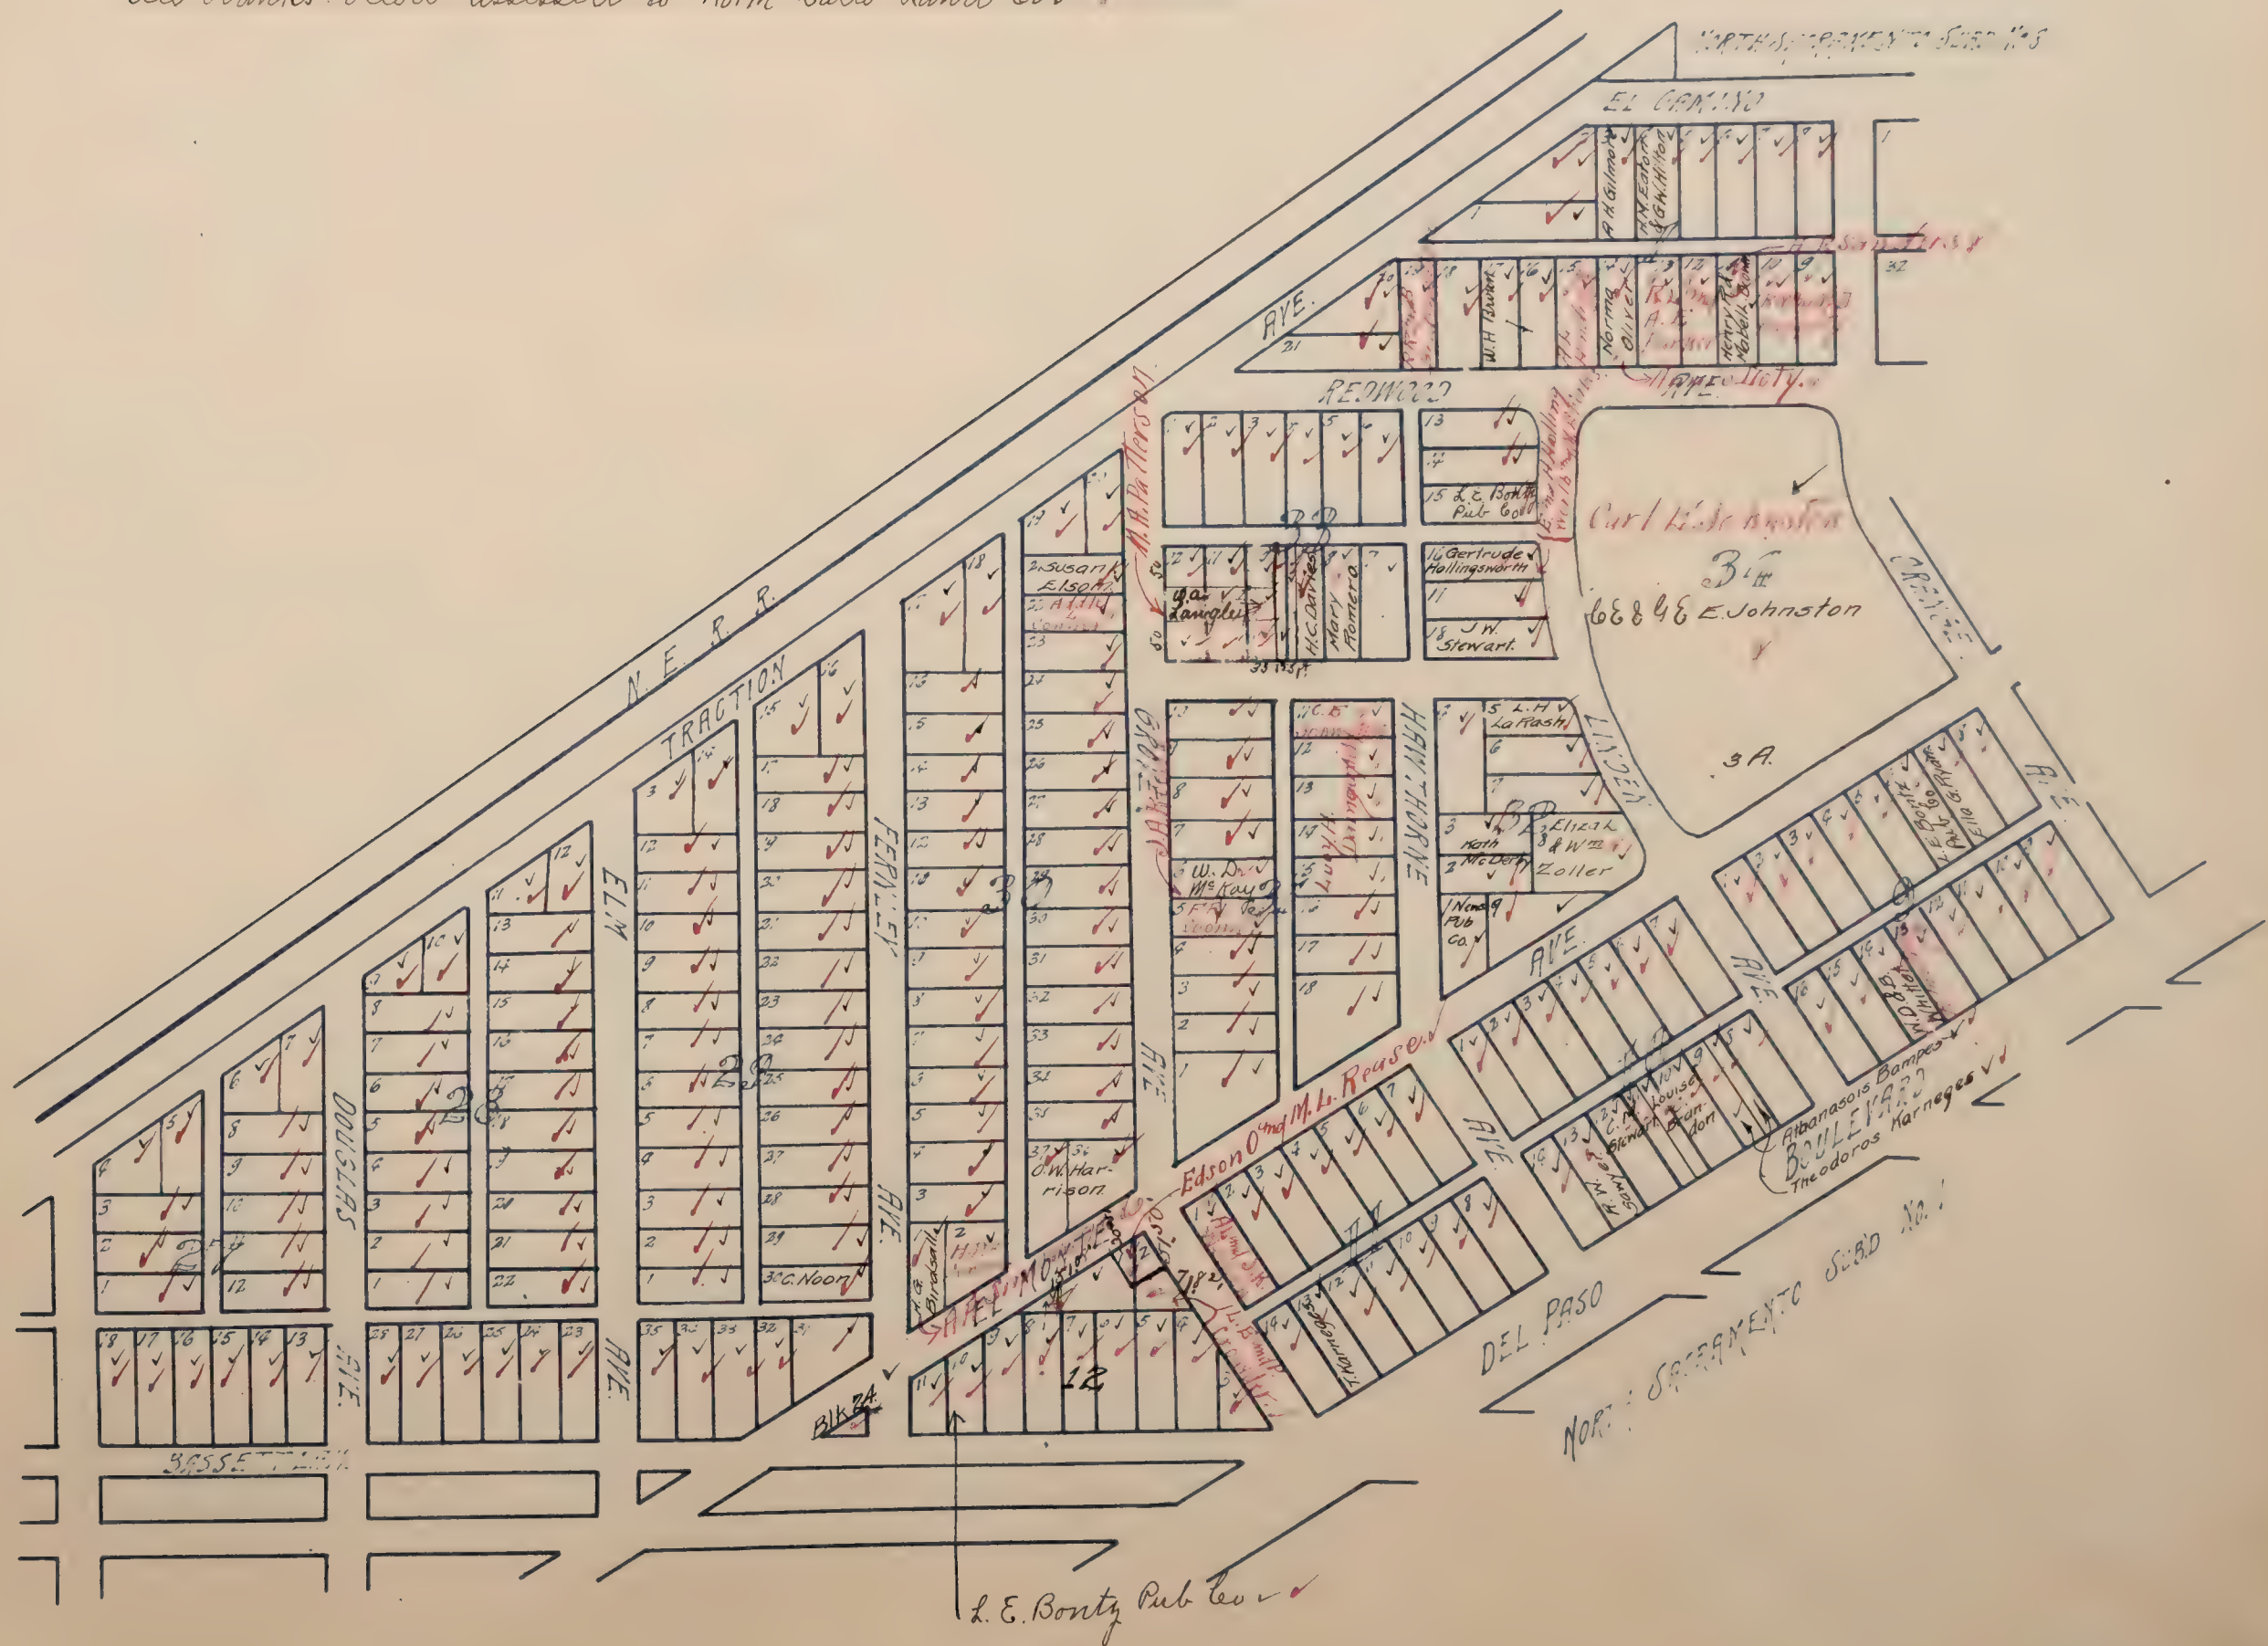


SCALE 1" = 80'

Blanks to N. Sac. Land. Co. ✓✓

OSTRICH FARM

FARM
6 her Red in Norway
2 1/2 A.

H. South A.D.

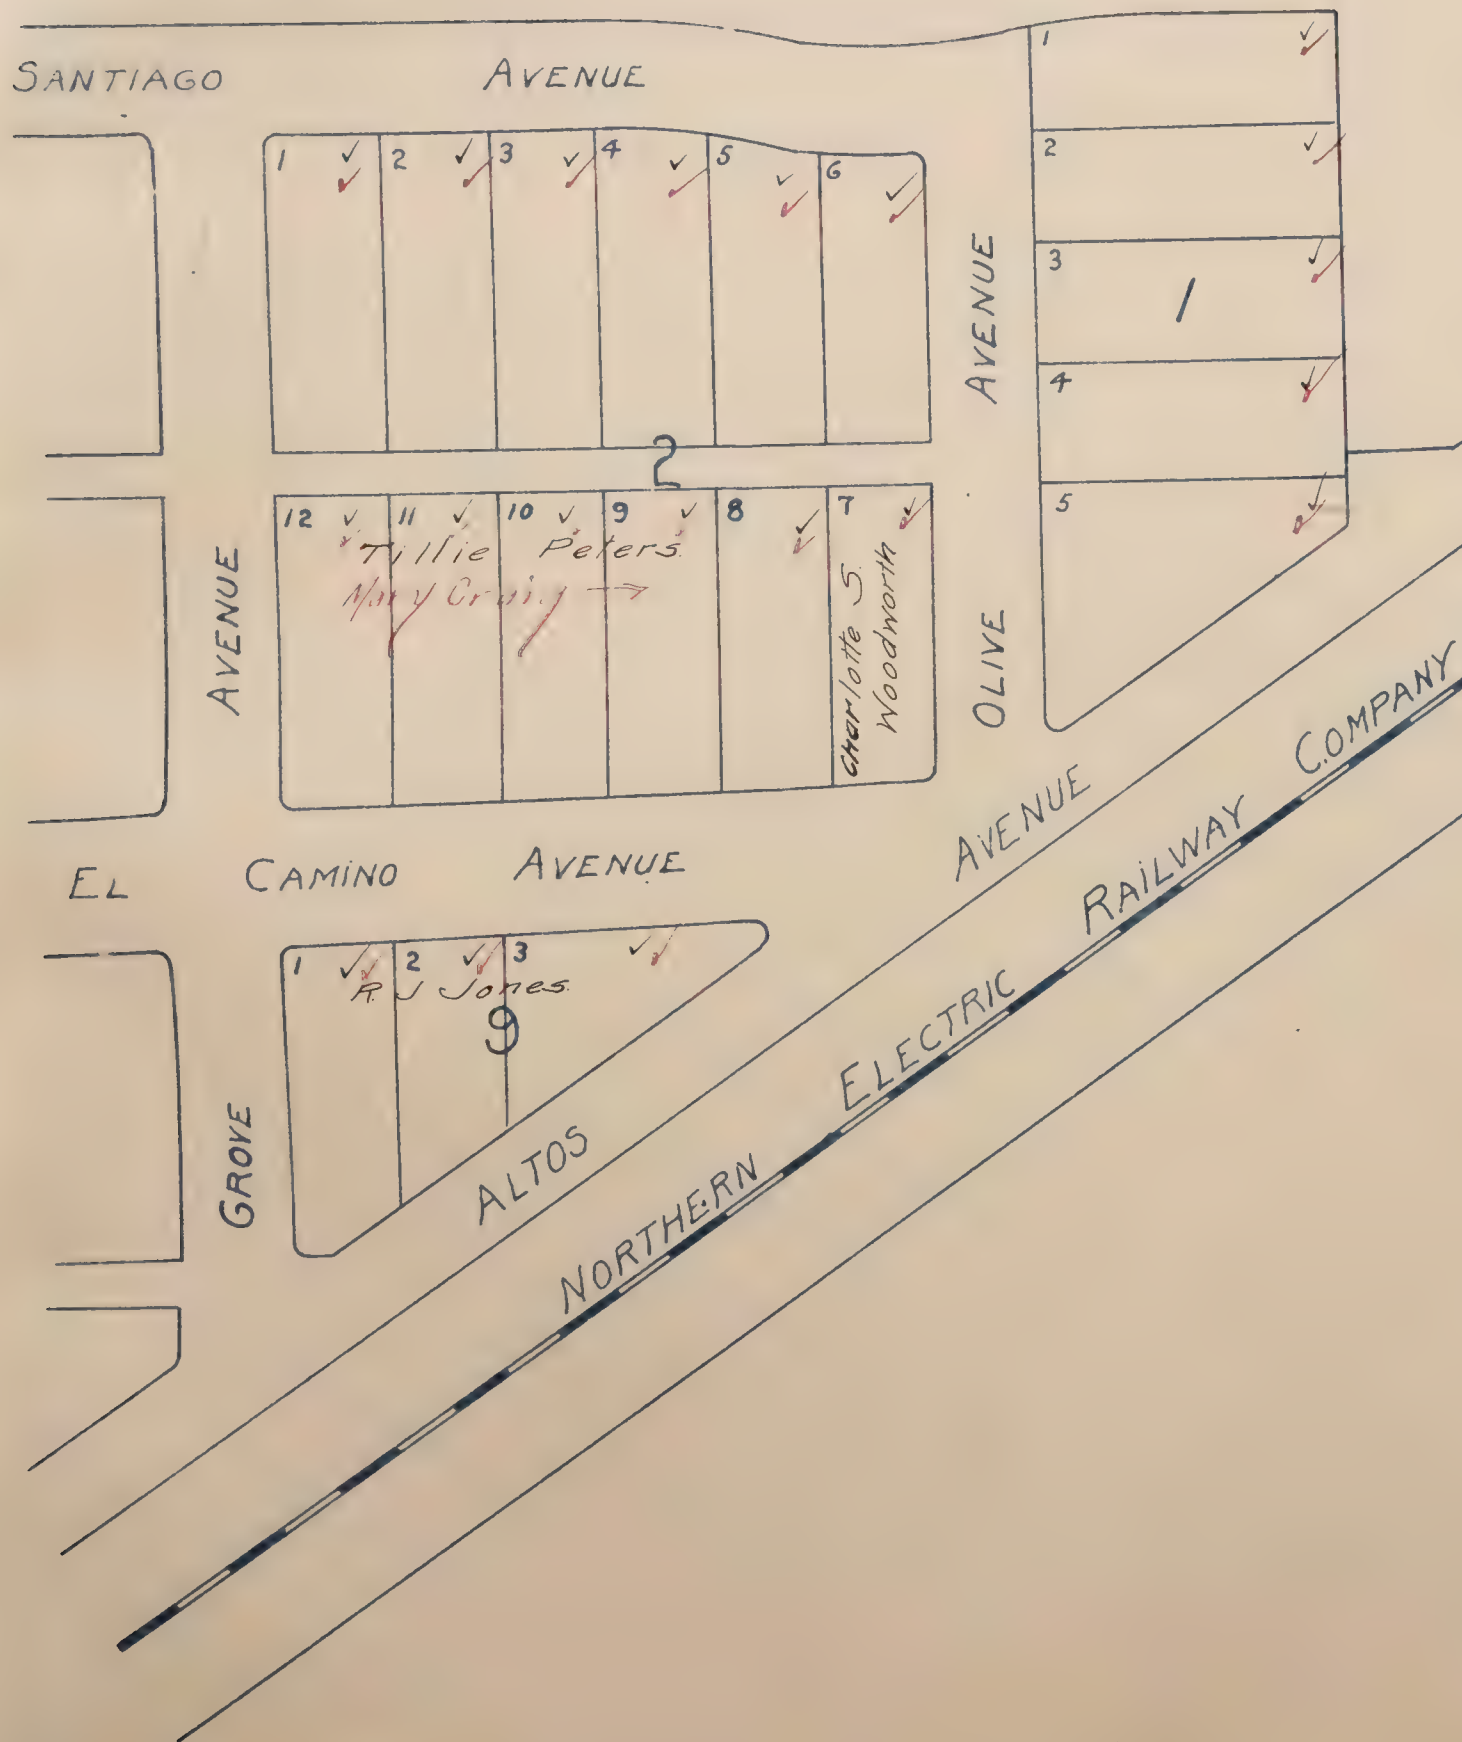

IN

Black Ink-1919 Ownership
Red Ink-1920 Ownership

SCALE - 1" = 80'

Blanks to N. Sac. Land Co. ✓✓

H. L. C. H. 18

AVENUE

8	9	10	11	12	13
---	---	----	----	----	----

AVENUE

Lane	Band Position (approx. % from top)
1	15
2	15
3	15
4	15
5	15
6	15
7	15
8	15
9	15
10	15
11	15
12	15
13	15

4

3

19	18	17	16	15	14
✓	✓	✓	✓	✓	✓

26 ✓	25 ✓	24 ✓	23 ✓ Henry J. Grunewald	22 ✓	21 ✓	20 ✓	19 ✓ Leolin F. Sinnott	18 ✓	17 ✓ Edna M. & Stephen H. Davis	16 ✓ J. M. Donald	15 ✓	14 ✓
------	------	------	----------------------------	------	------	------	---------------------------	------	------------------------------------	----------------------	------	------

AVENUE

AVENUE

EL CAMINO

AVENUE

8	✓ ✓	9	✓ ✓	10	✓ ✓	11	✓ ✓	12	✓ ✓	13	✓ ✓
---	--------	---	--------	----	--------	----	--------	----	--------	----	--------

1	✓	Norma A. Oliver <i>Anna</i>
2	✓	Ella T.
3	✓	Gatchell.
4	✓	
5	✓	Harriet Amelia Hendall.
6	✓	
7	✓	
8	✓	W ^m F. & Mattie Tahman
9	✓	
10	✓	Mary A Stearns
11	✓	
12	✓	
13	✓	

GROVE

7

8

19	✓	18	✓	17	✓	16	✓	15	✓	14	✓
----	---	----	---	----	---	----	---	----	---	----	---

25 ✓	24 ✓	23 ✓ William J. Dempsey	22 ✓ William Edw. Harrison	21 ✓	20 ✓ Ella Brui	19 ✓	18 ✓	17 ✓	16 ✓	15 ✓ Eugene Kristiansen	14 ✓
------	------	----------------------------	-------------------------------	------	-------------------	------	------	------	------	----------------------------	------

AVENUE

COMPANY

ELM

REDWOOD

AVENUE

8	9	10	11	12	13
✓		✓	✓	✓	✓

1 ✓ 2 ✓ 3 ✓ 4 ✓ 5 ✓

11

10

19	✓	18	✓	17	✓	16	✓	15	✓	14	✓
----	---	----	---	----	---	----	---	----	---	----	---

ALTOS

NORTHERN

AVENUE

ELECTRIC

A hand-drawn sketch of a railway track. The track consists of two parallel lines with cross-ticks representing sleepers. The words "RAILWAY COMPANY" are written in a stylized, hand-drawn font along the upper track line. The entire sketch is rendered in a simple, illustrative style with black outlines on a light background.

STANFORD

AVENUE

NORTH SACRAMENTO SUBDIVISION No 10

IN

Black Ink-1919 Ownership
Red Ink-1920 Ownership

SECS 1, 2 + 13, RANCHO DEL PASO

SCALE - 1" = 80'

Blanks to N. Sac. Land Co. v. J. L. L. 1919

SANTIAGO

AVENUE

1	✓✓	2	✓✓	3	✓✓
12	✓✓	11	✓✓	10	✓✓
9	✓✓	8	✓✓	7	✓✓
6	✓✓	5	✓✓	4	✓✓

1	✓✓	2	✓✓	3	✓✓	4	✓✓	5	✓✓	6	✓✓	7	✓✓
26	✓✓	25	✓✓	24	✓✓	23	✓✓	22	✓✓	21	✓✓	20	✓✓

EL

CAMINO

AVENUE

1	✓✓	2	✓✓	3	✓✓	4	✓✓	5	✓✓	6	✓✓	7	✓✓	8	✓✓	9	✓✓
12	✓✓	11	✓✓	10	✓✓	9	✓✓	8	✓✓	7	✓✓	6	✓✓	5	✓✓	4	✓✓

1	✓✓	2	✓✓	3	✓✓	4	✓✓	5	✓✓	6	✓✓	7	✓✓
26	✓✓	25	✓✓	24	✓✓	23	✓✓	22	✓✓	21	✓✓	20	✓✓

12	✓✓	11	✓✓	10	✓✓
----	----	----	----	----	----

26	✓✓	25	✓✓	24	✓✓	23	✓✓	22	✓✓	21	✓✓	20	✓✓
----	----	----	----	----	----	----	----	----	----	----	----	----	----

REDWOOD

CEDAR

1	✓✓	2	✓✓	3	✓✓
6	✓✓	5	✓✓	4	✓✓

1	✓✓	2	✓✓	3	✓✓	4	✓✓	5	✓✓	6	✓✓	7	✓✓
26	✓✓	25	✓✓	24	✓✓	23	✓✓	22	✓✓	21	✓✓	20	✓✓

STANFORD

AVENUE

6	✓✓	5	✓✓	4	✓✓
---	----	---	----	---	----

26	✓✓	25	✓✓	24	✓✓	23	✓✓	22	✓✓	21	✓✓	20	✓✓
----	----	----	----	----	----	----	----	----	----	----	----	----	----

COMPANY

RAILWAY

PACIFIC

WESTERN

